


5 cm

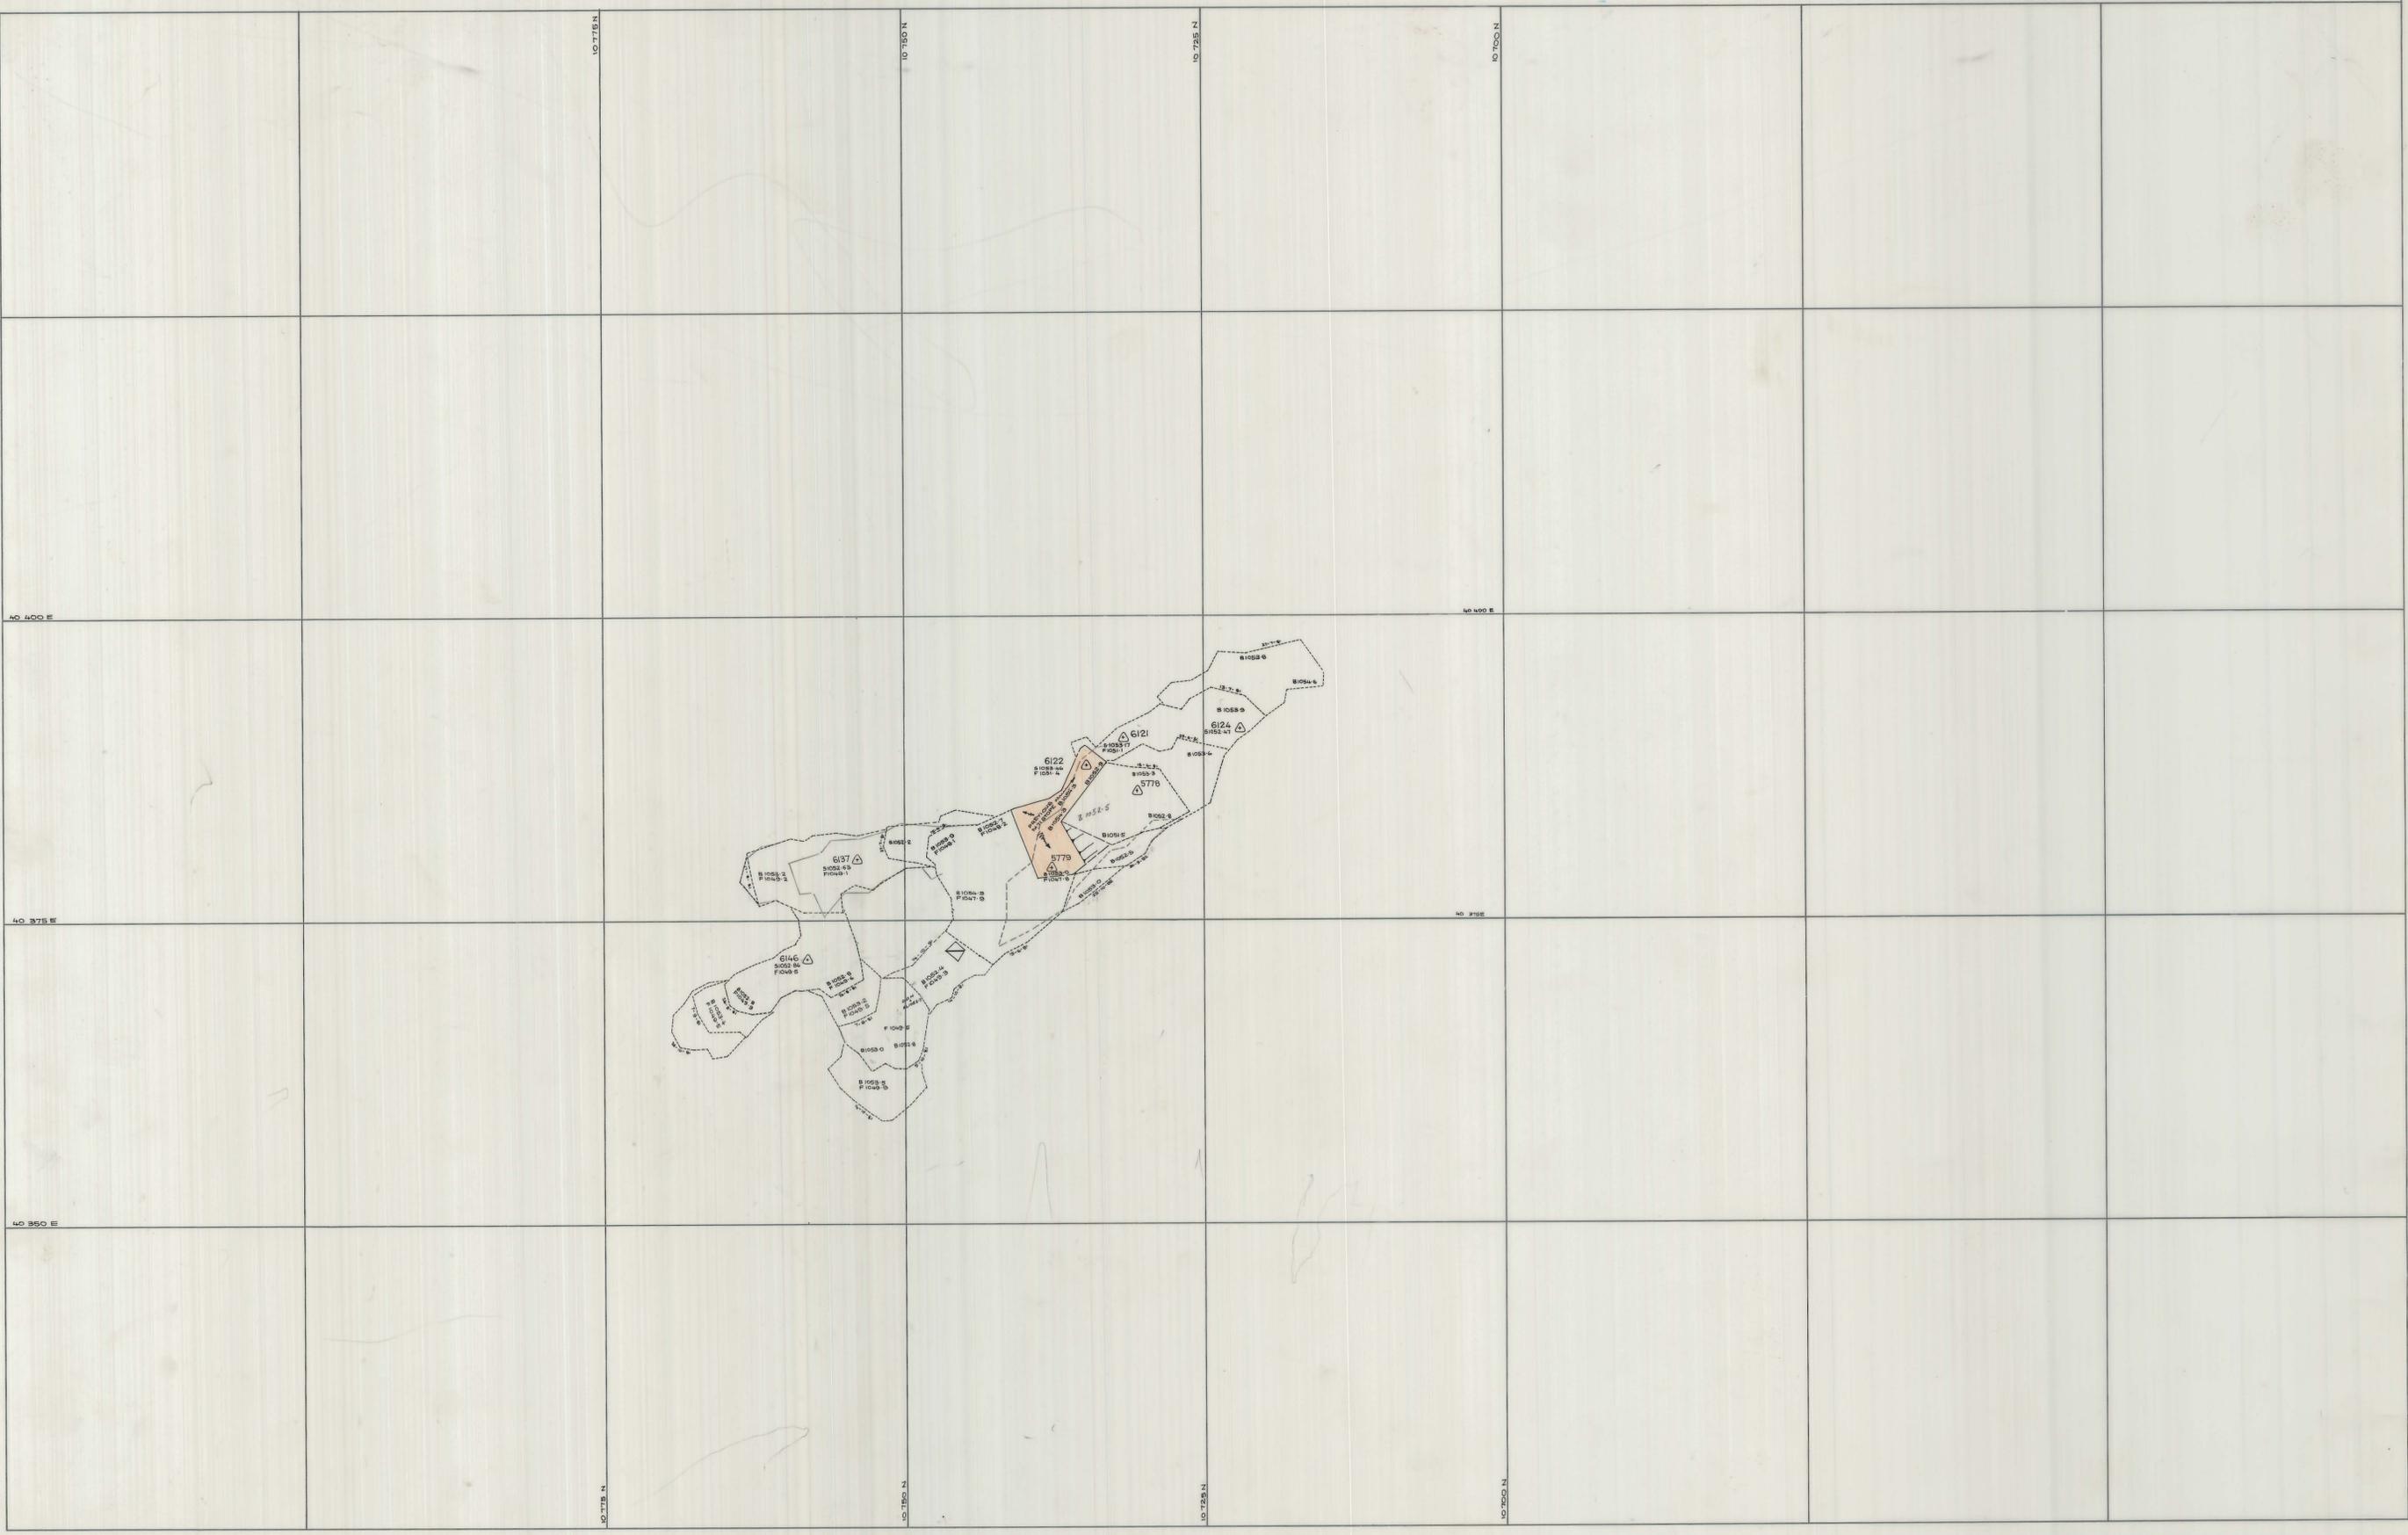

	<p>SCALE 1:250</p> <p>BACK WL 1000 APPROX.</p>		<p>LOCATION BOLD HEAD MINE</p> <p>SUBJECT P 70 STOPE 6th lift</p>	<p>KING ISLAND SCHEELITE A DIVISION OF WARMAN INTERNATIONAL</p> <p>GRASSY KING ISLAND</p> <p>PLAN NUMBER 04BH13 - 166 100 S</p>
--	--	--	---	---