



27 JUN 1981

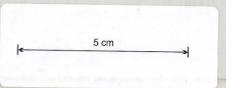

04BH13 - 166 212 S

0374_4534

260
LIFT 4

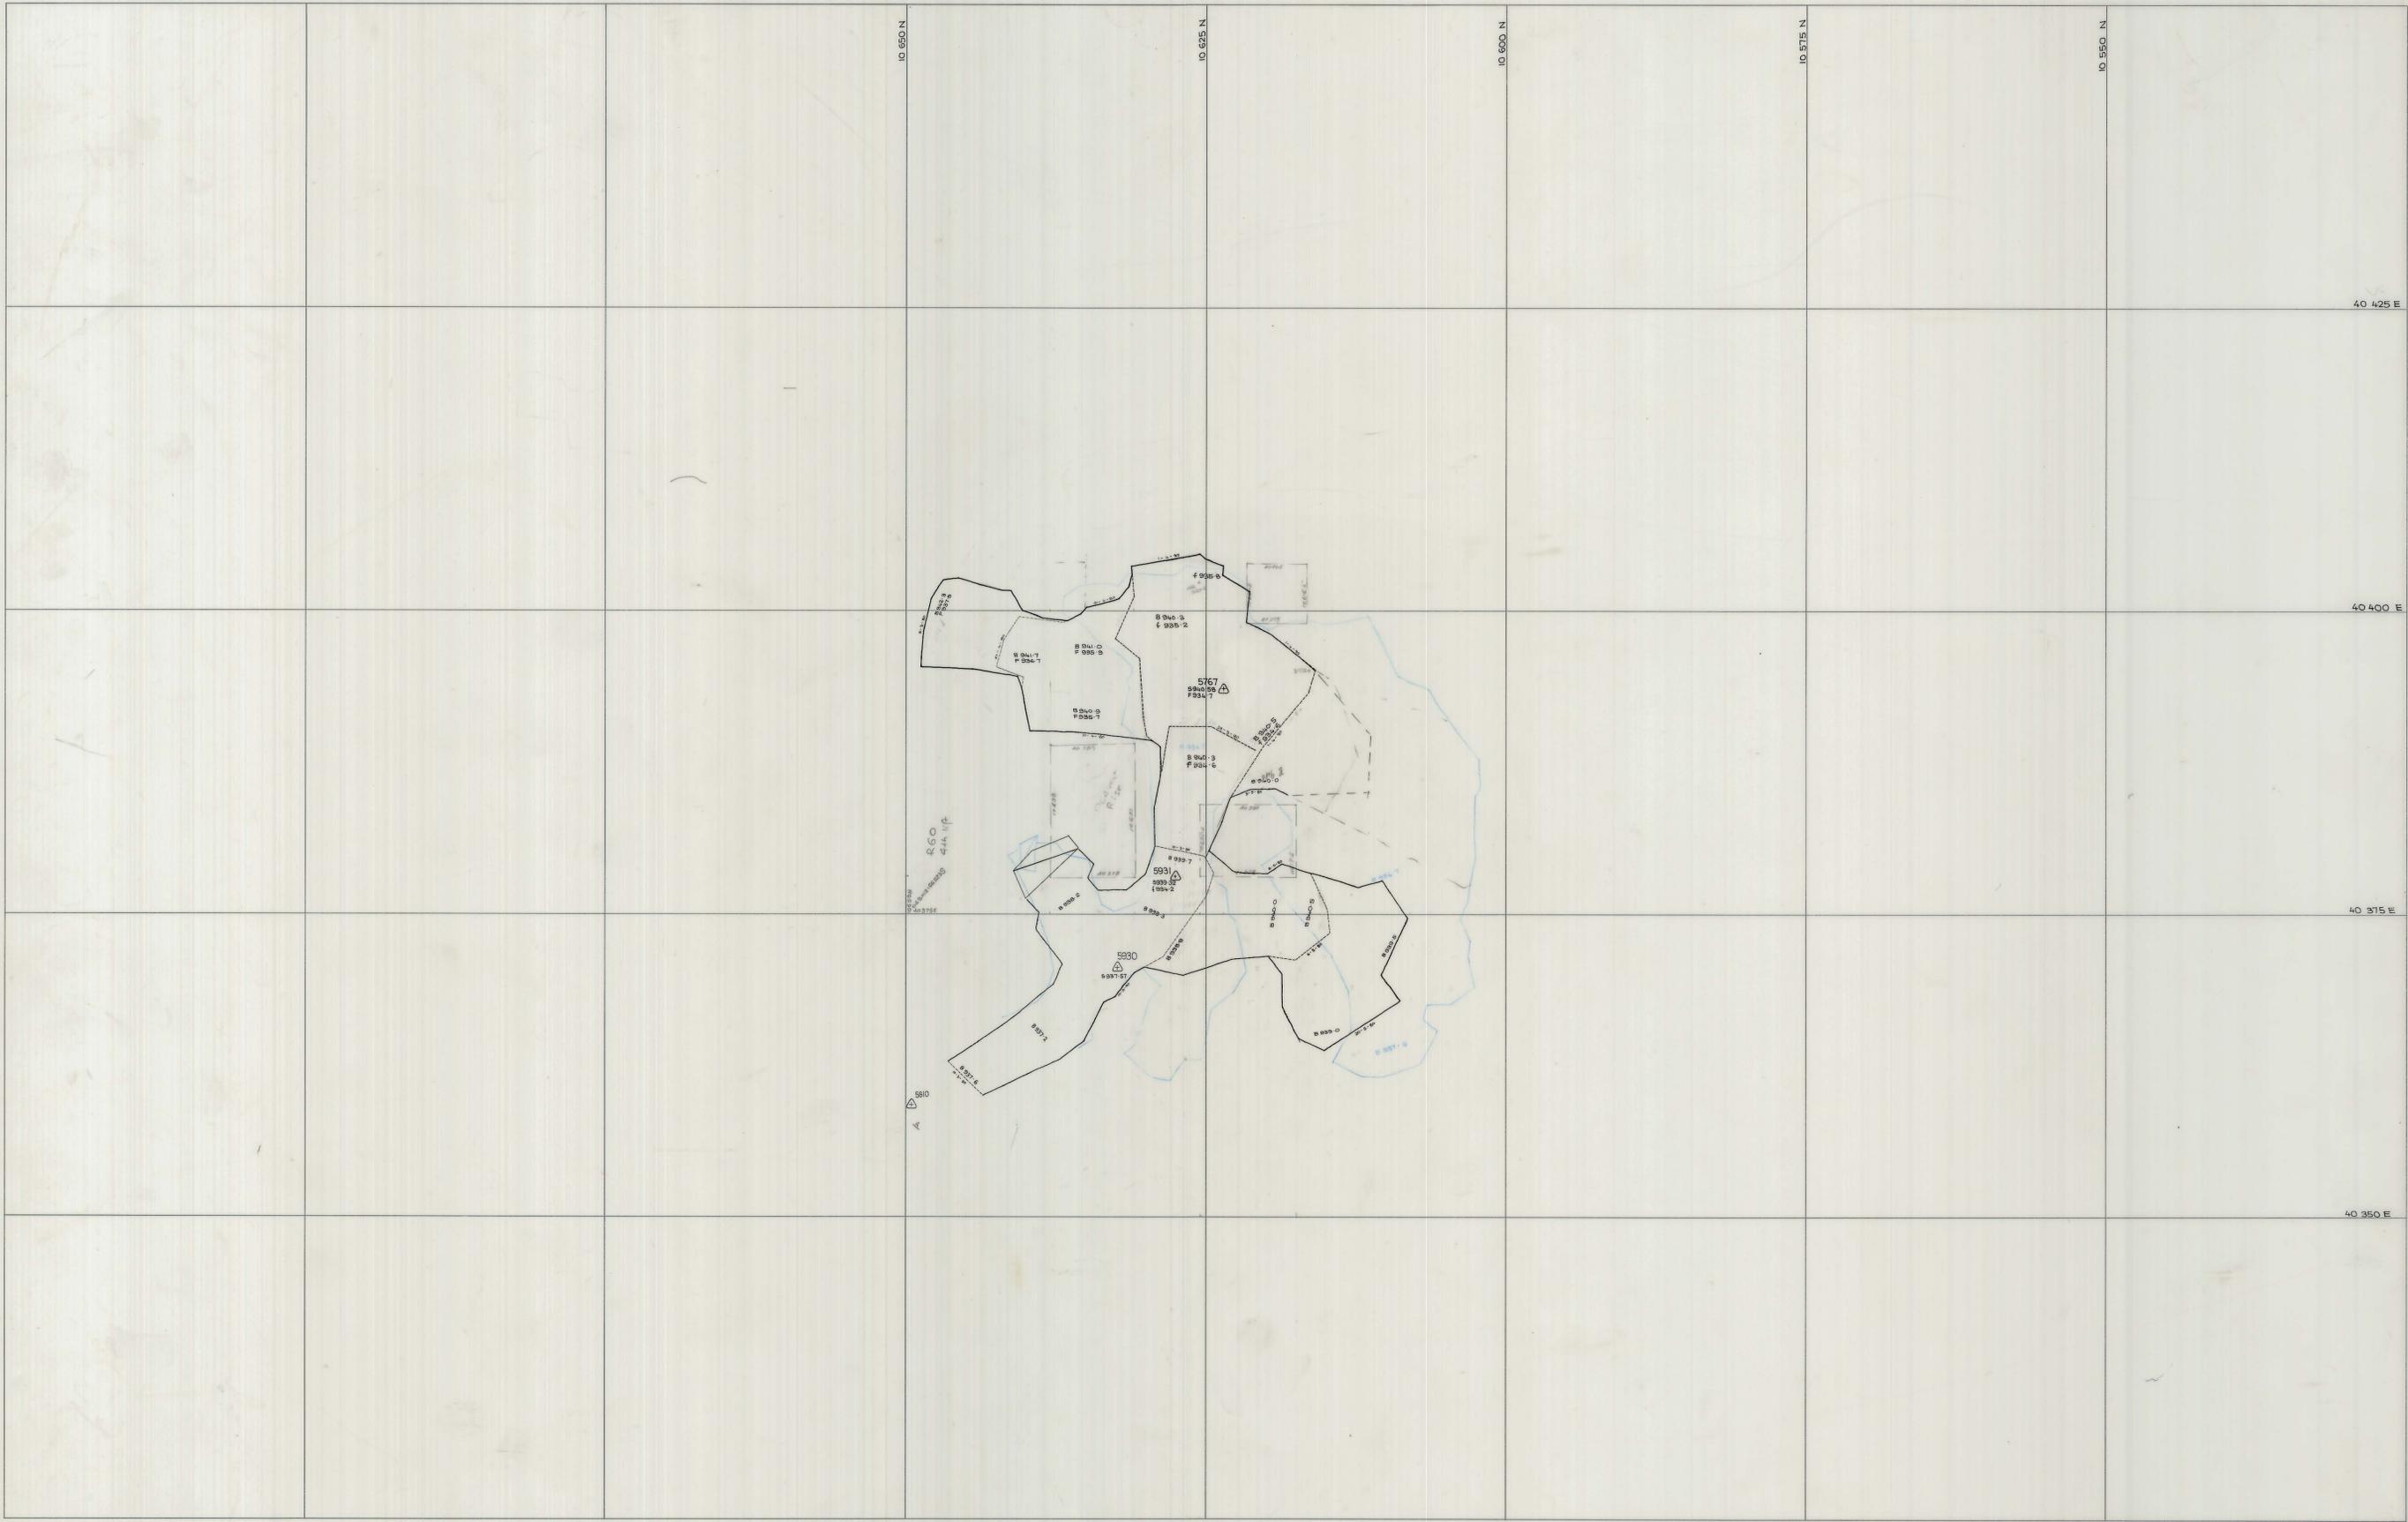

SCALE 1:250 Sec 038-07-3002 for Biter roads	LOCATION BOLD HEAD MINE	 KING ISLAND GRASSY A DIVISION OF WARMAN INTERNATIONAL
	SUBJECT R 60 4th lift	
north		