


27 JUN 1981

5 cm

04BH13 - 166 216S

0374_4535

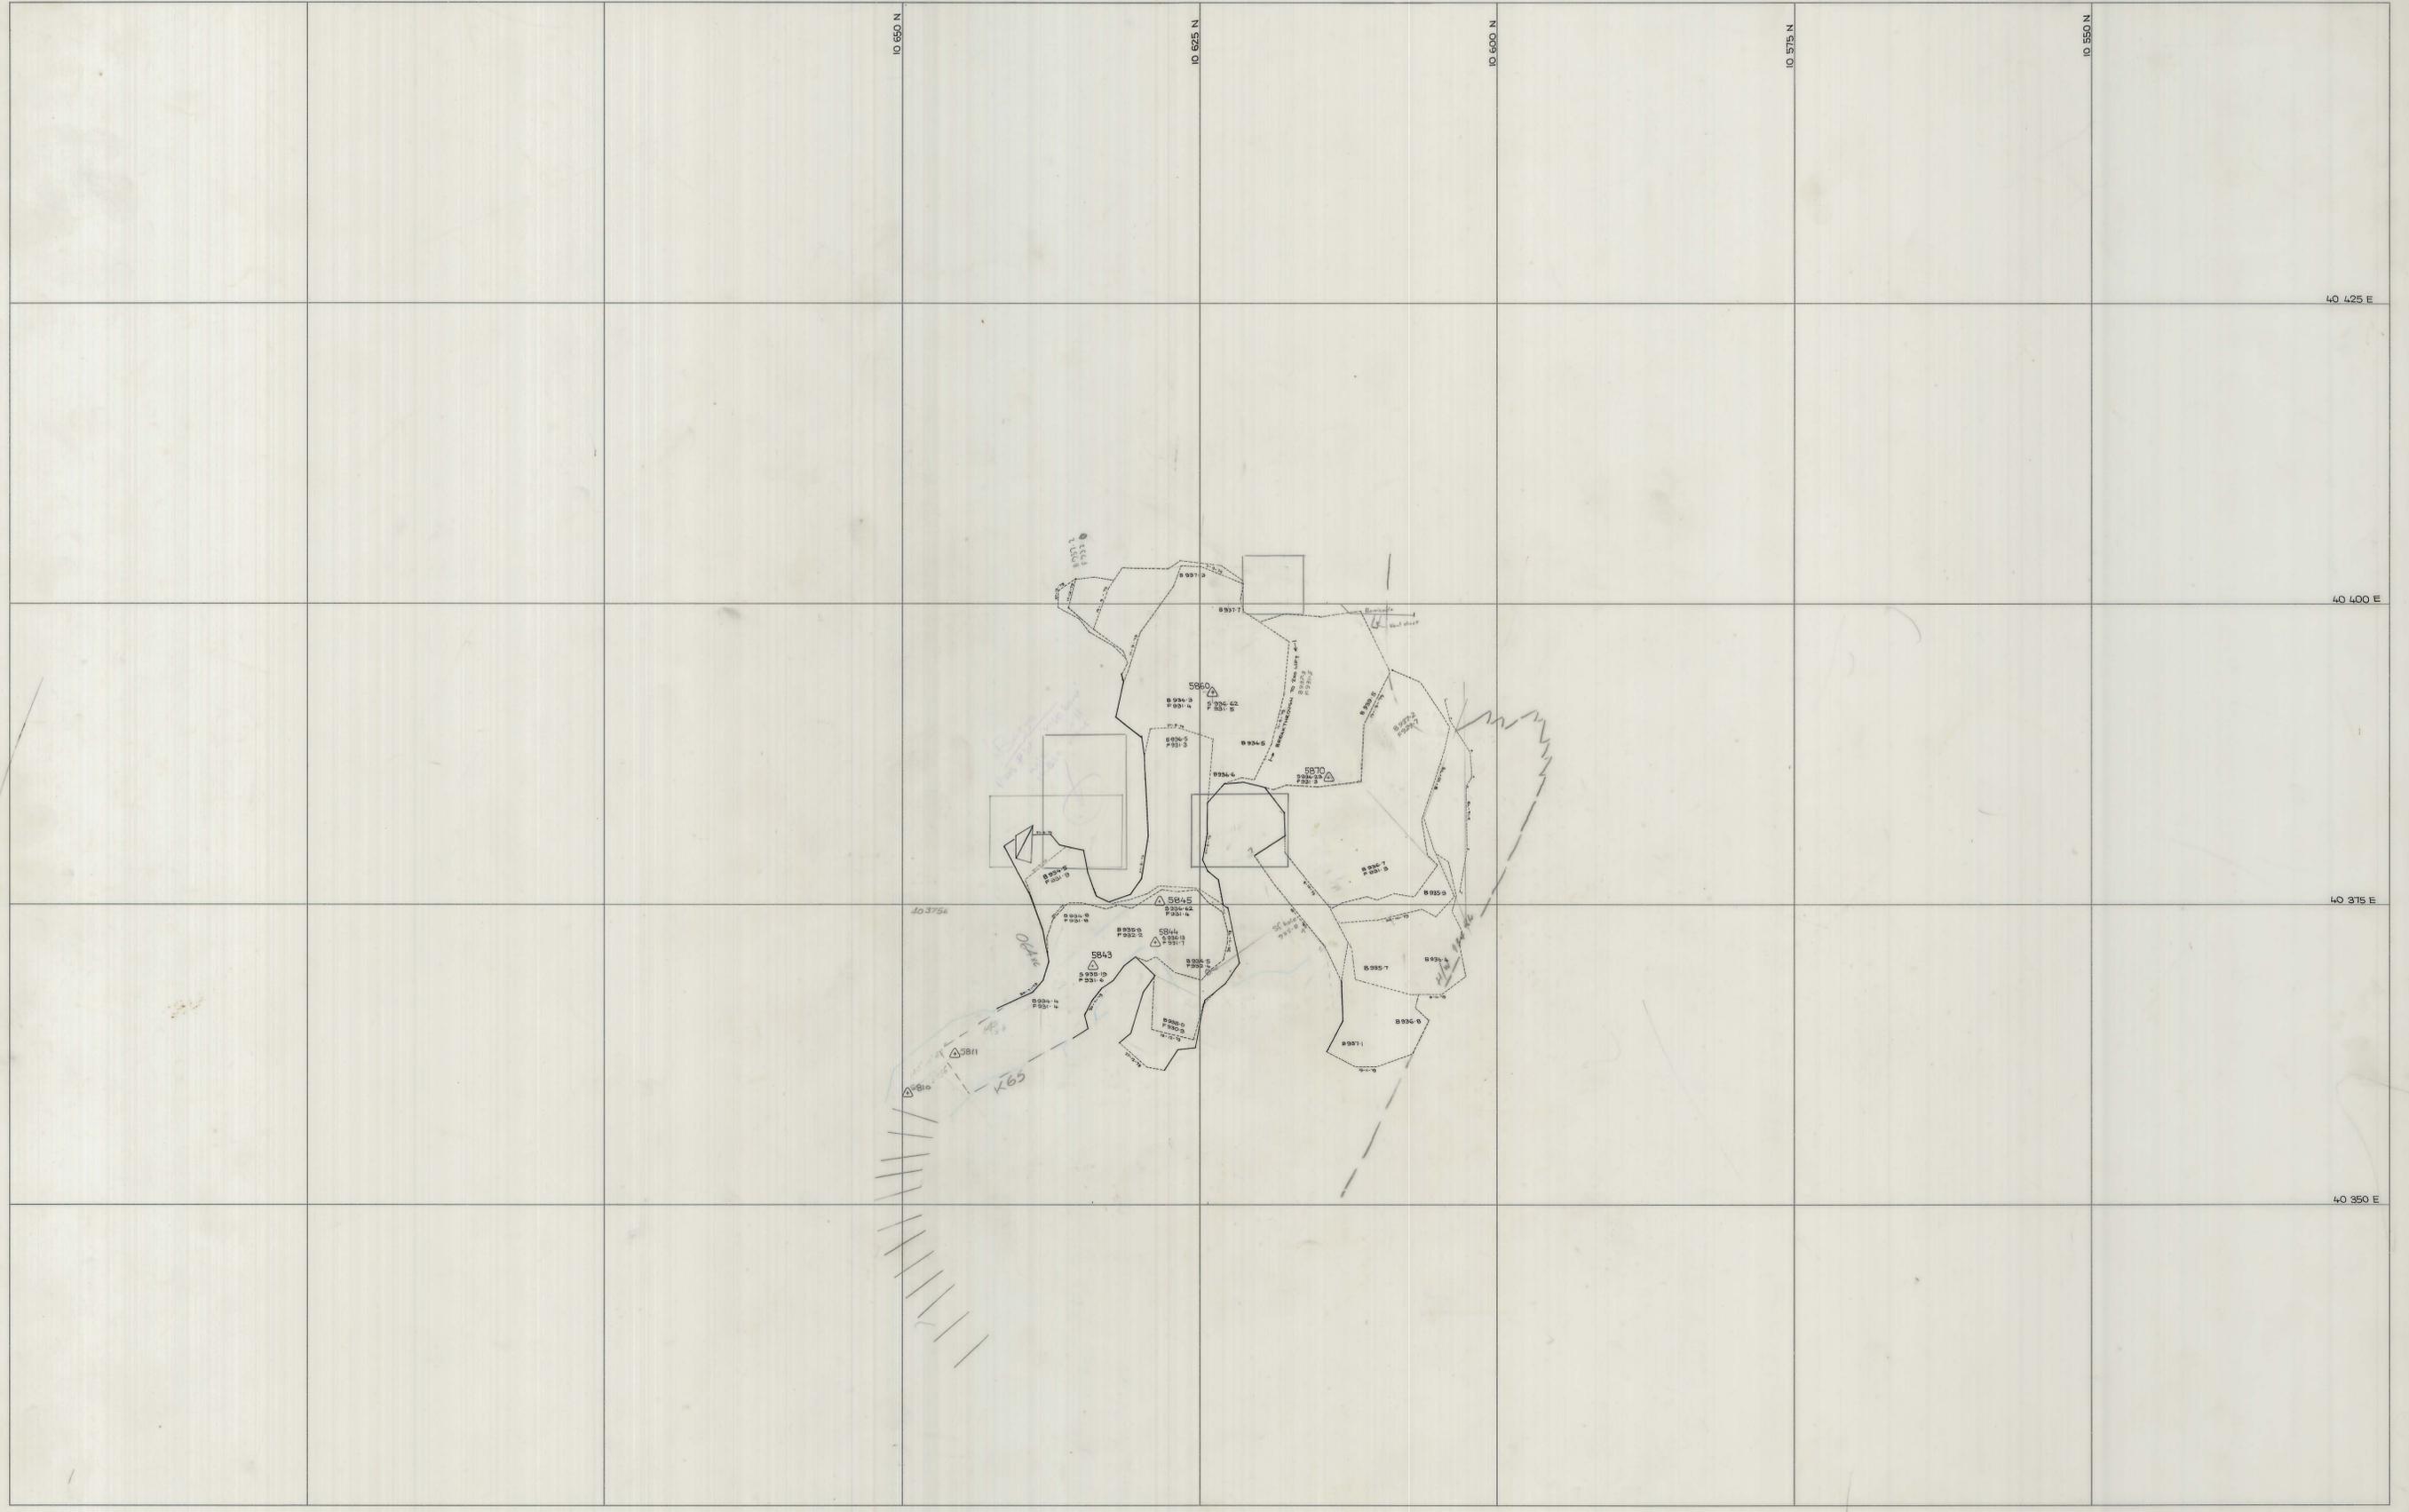

	SCALE 1:250	LOCATION BOLD HEAD MINE	
		SUBJECT 3rd lift R60 C ₂ OREBODY	
		north	