


27 JUN 1981

04BH13-166219 S

0374_4536

5 cm

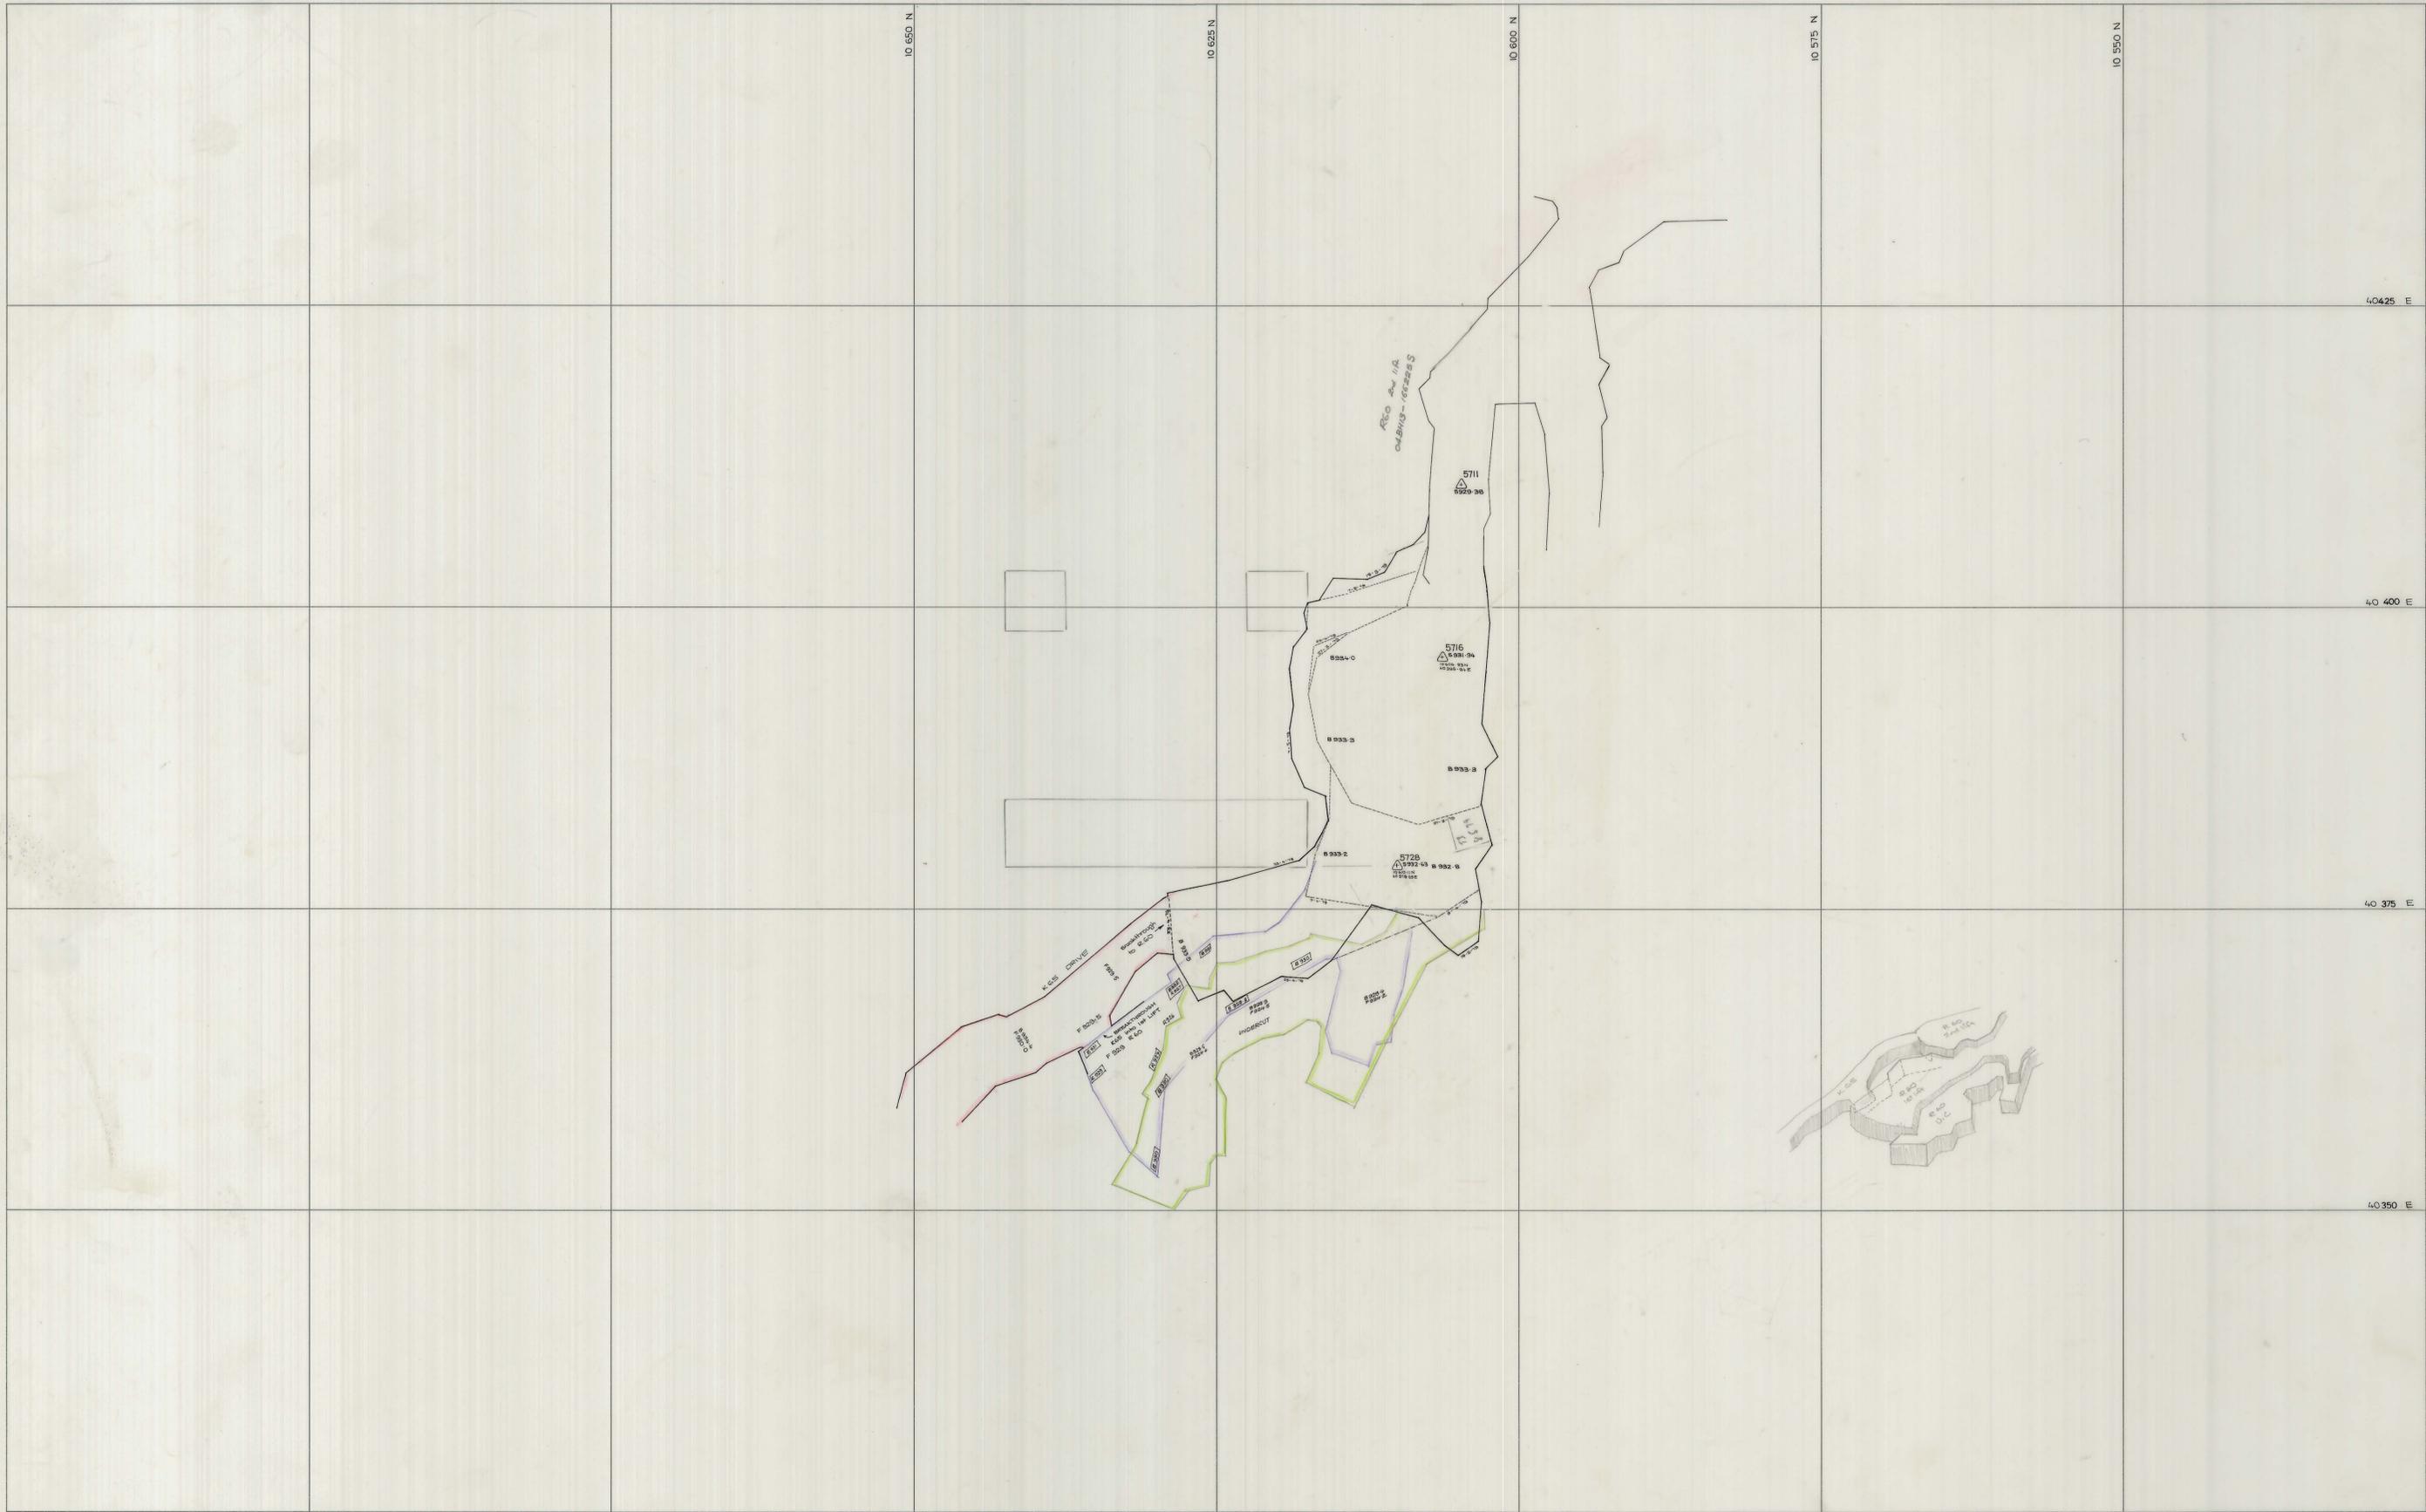

SCALE 1:250

LOCATION

BOLD HEAD MINE

SUBJECT

2nd lift
R60

C₂ OREBODY

north

KIS KING ISLAND SCHEELITE
A DIVISION OF WARMAN INTERNATIONAL

GRASSY KING ISLAND

PLAN NUMBER

04BH13 - 166 219 S