


27 JUN 1981

0374_4537

5 cm

04BH13-166 220

L57, L58, L59
L59
564

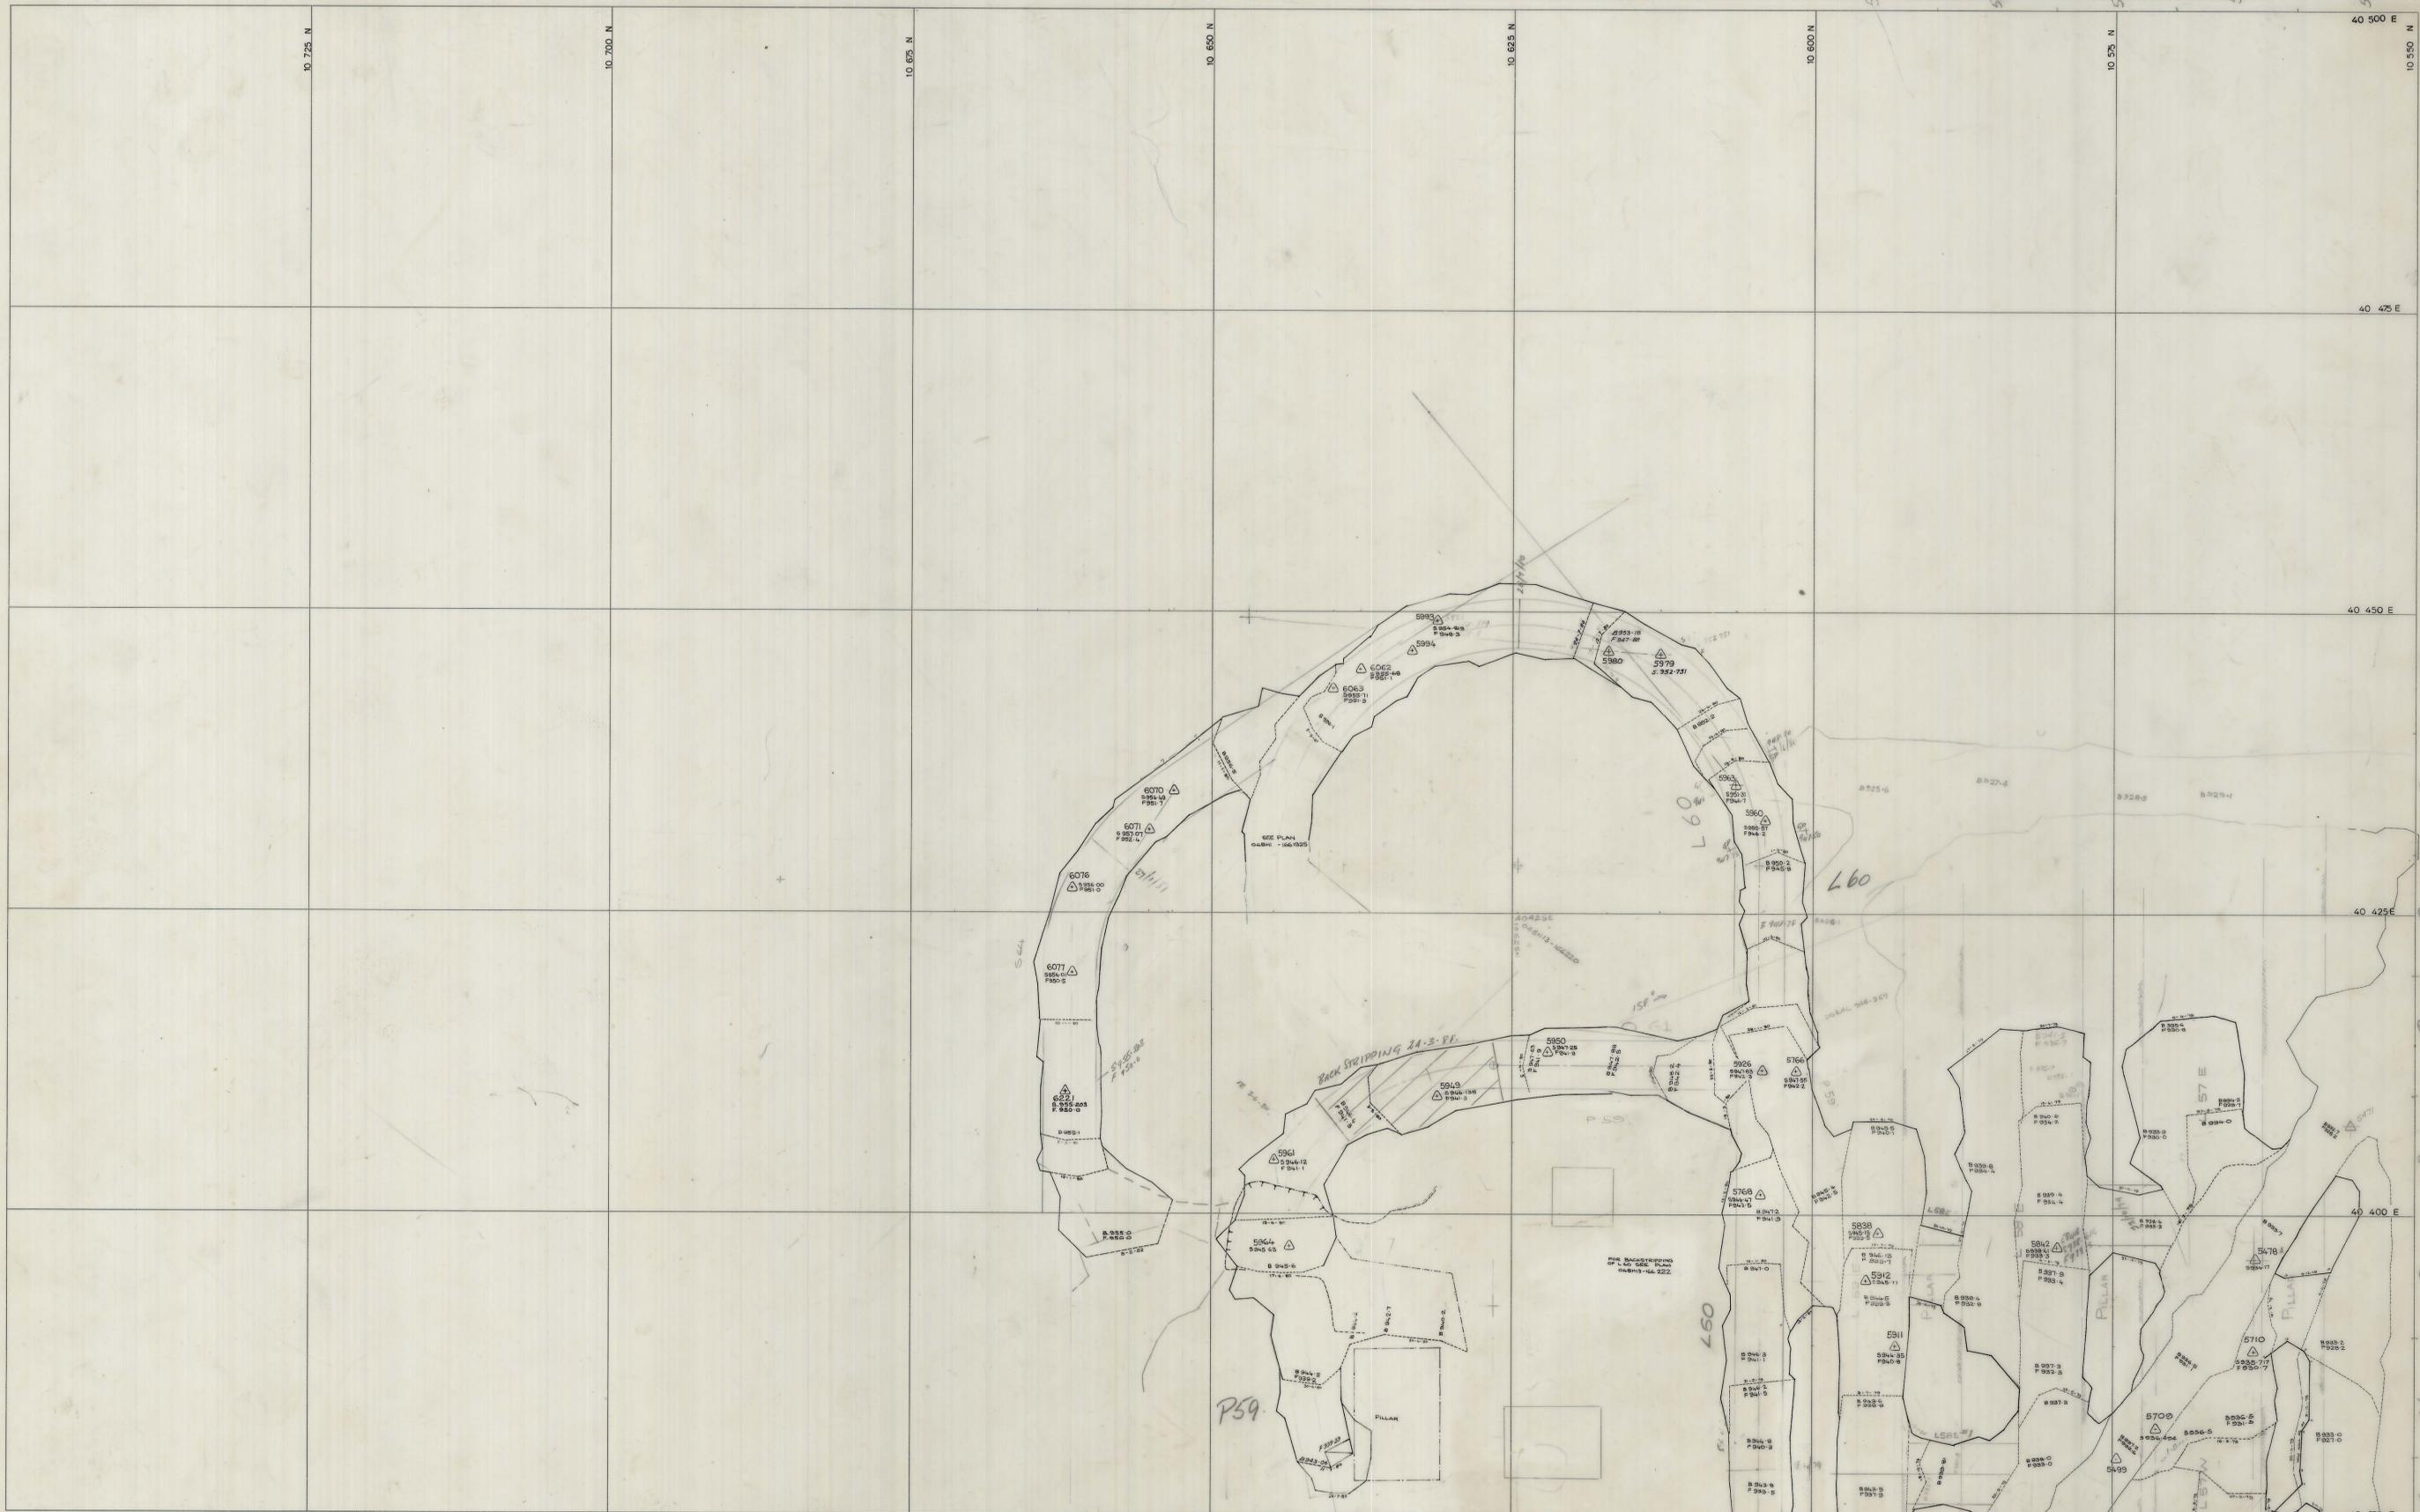

<p>SCALE 1: 250</p> <p>See O-4BH12-1002 for details See O3 BH04-4001 for staking design</p>	<p>LOCATION BOLD HEAD MINE</p> <p>SUBJECT C1 OREBODY L57, L58 & L59</p>	<p>SCALE 1: 250</p> <p>LOCATION BOLD HEAD MINE</p> <p>SUBJECT C1 OREBODY L57, L58 & L59</p>	<p>KIS KING ISLAND SCHEELITE A DIVISION OF WARMAN INTERNATIONAL</p> <p>GRASSY KING ISLAND</p> <p>PLAN NUMBER 04BH13-166 220</p>
---	---	---	--