


0374_4538



Base level
Surveyed by
1-2-73

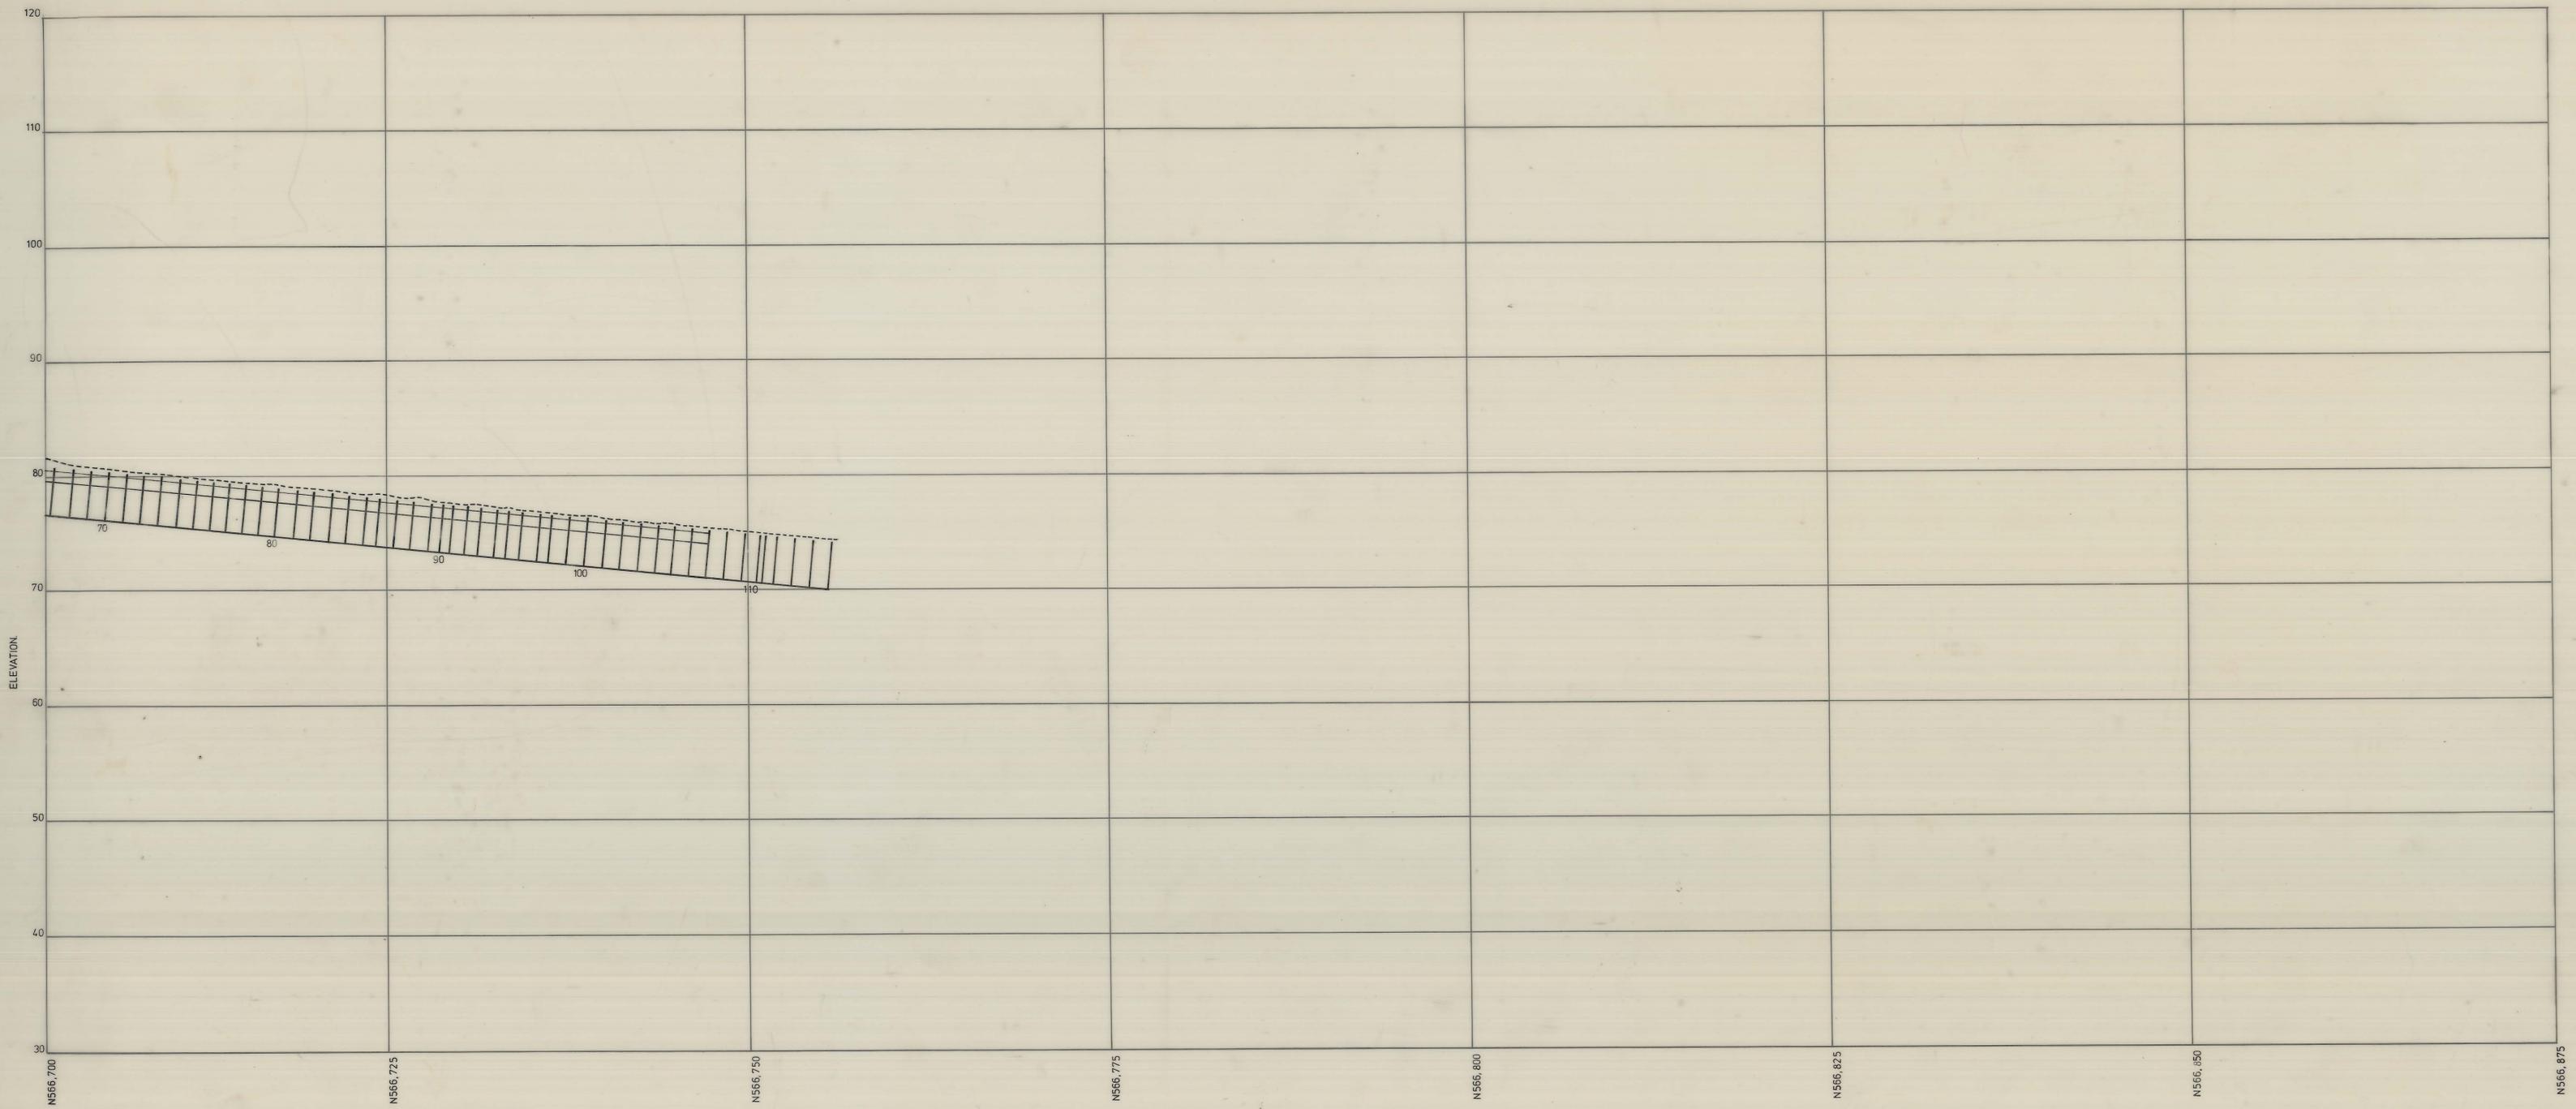

 <small>DATE 5-5-73 SURVEYED J.C. DRAWN J.C. TRACED CHECKED</small>	KING ISLAND SCHEELITE LTD. <small>Scale</small>	<small>No 1-</small> 1:5:14A
	SECTION ALONG ϕ OF DECLINE.	