


27 JUN 1981

5 cm

04BH13-166227

0374_4541

R 60
R 69

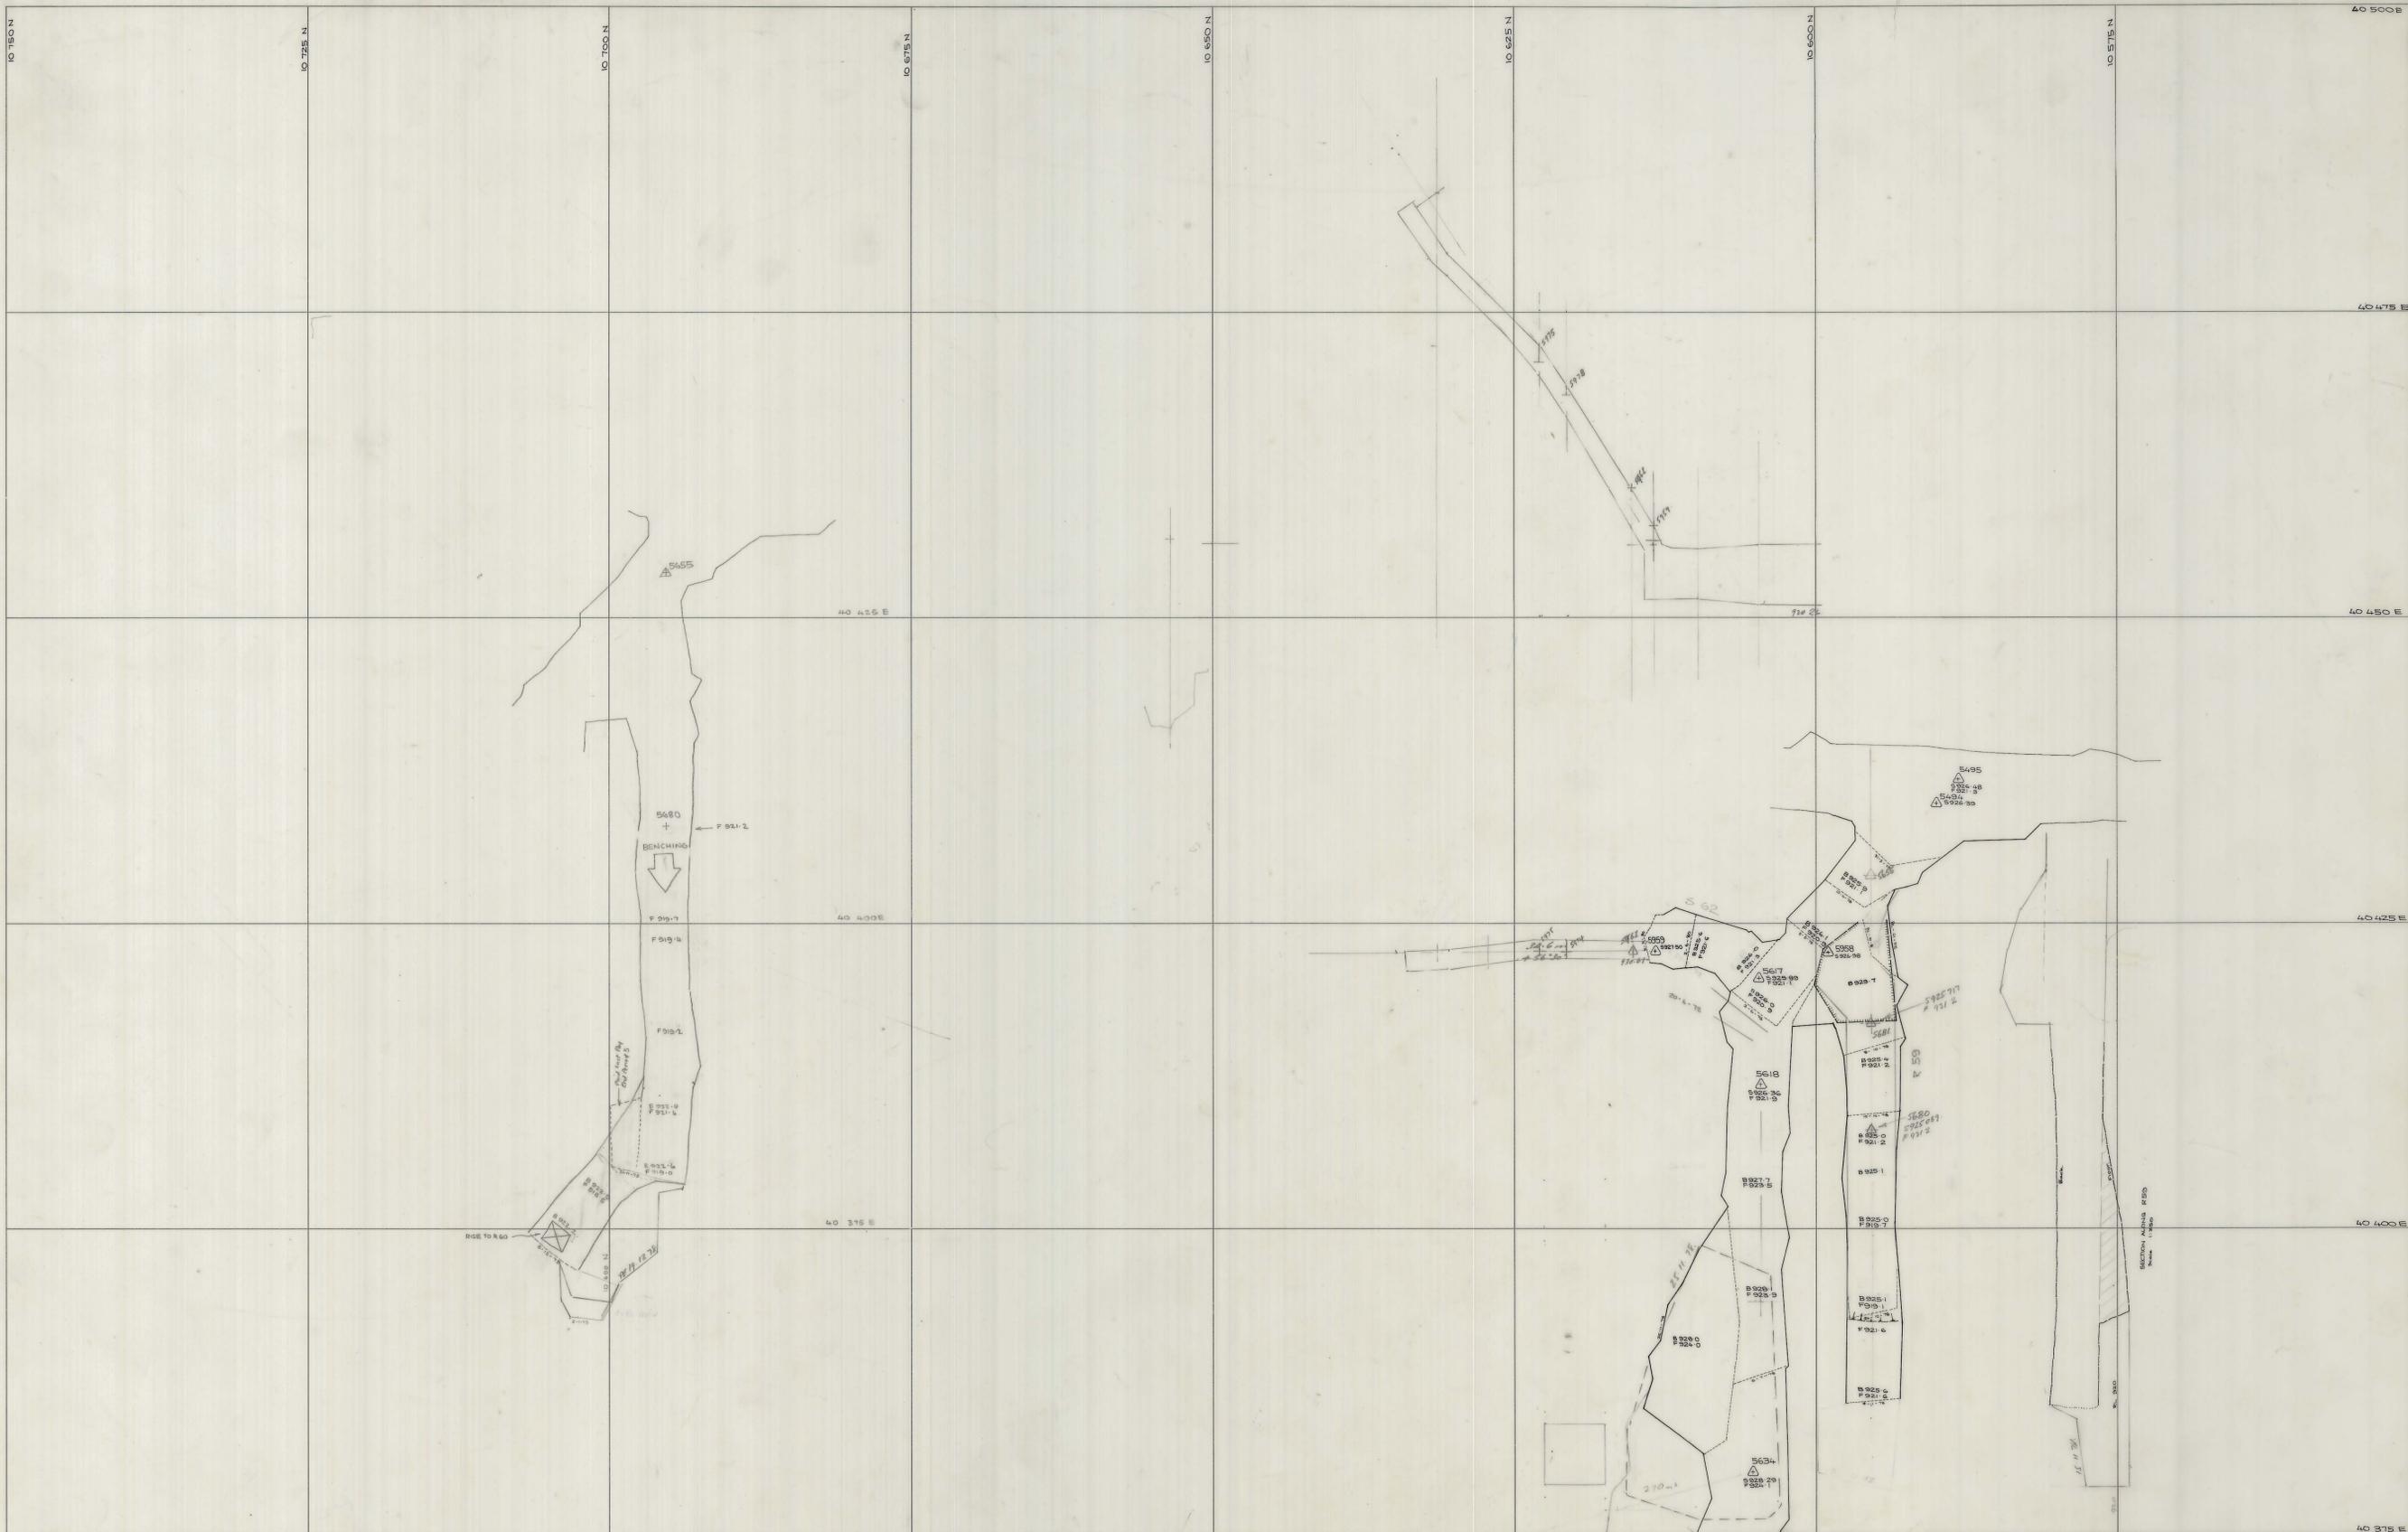

<p>17-46 8-40</p>	<p>SCALE 1:250</p>	<p>LOCATION BOLD HEAD MINE</p> <p>SUBJECT R60 - C2 OREBODY</p> <p>north</p>	<p>KIS KING ISLAND SCHEELITE A DIVISION OF HARBAN INTERNATIONAL</p> <p>GRASSY KING ISLAND</p> <p>PLAN NUMBER 04BH13 - 166 227</p>
-----------------------	--------------------	---	--