




04BH13 - 166 245

0374\_4544

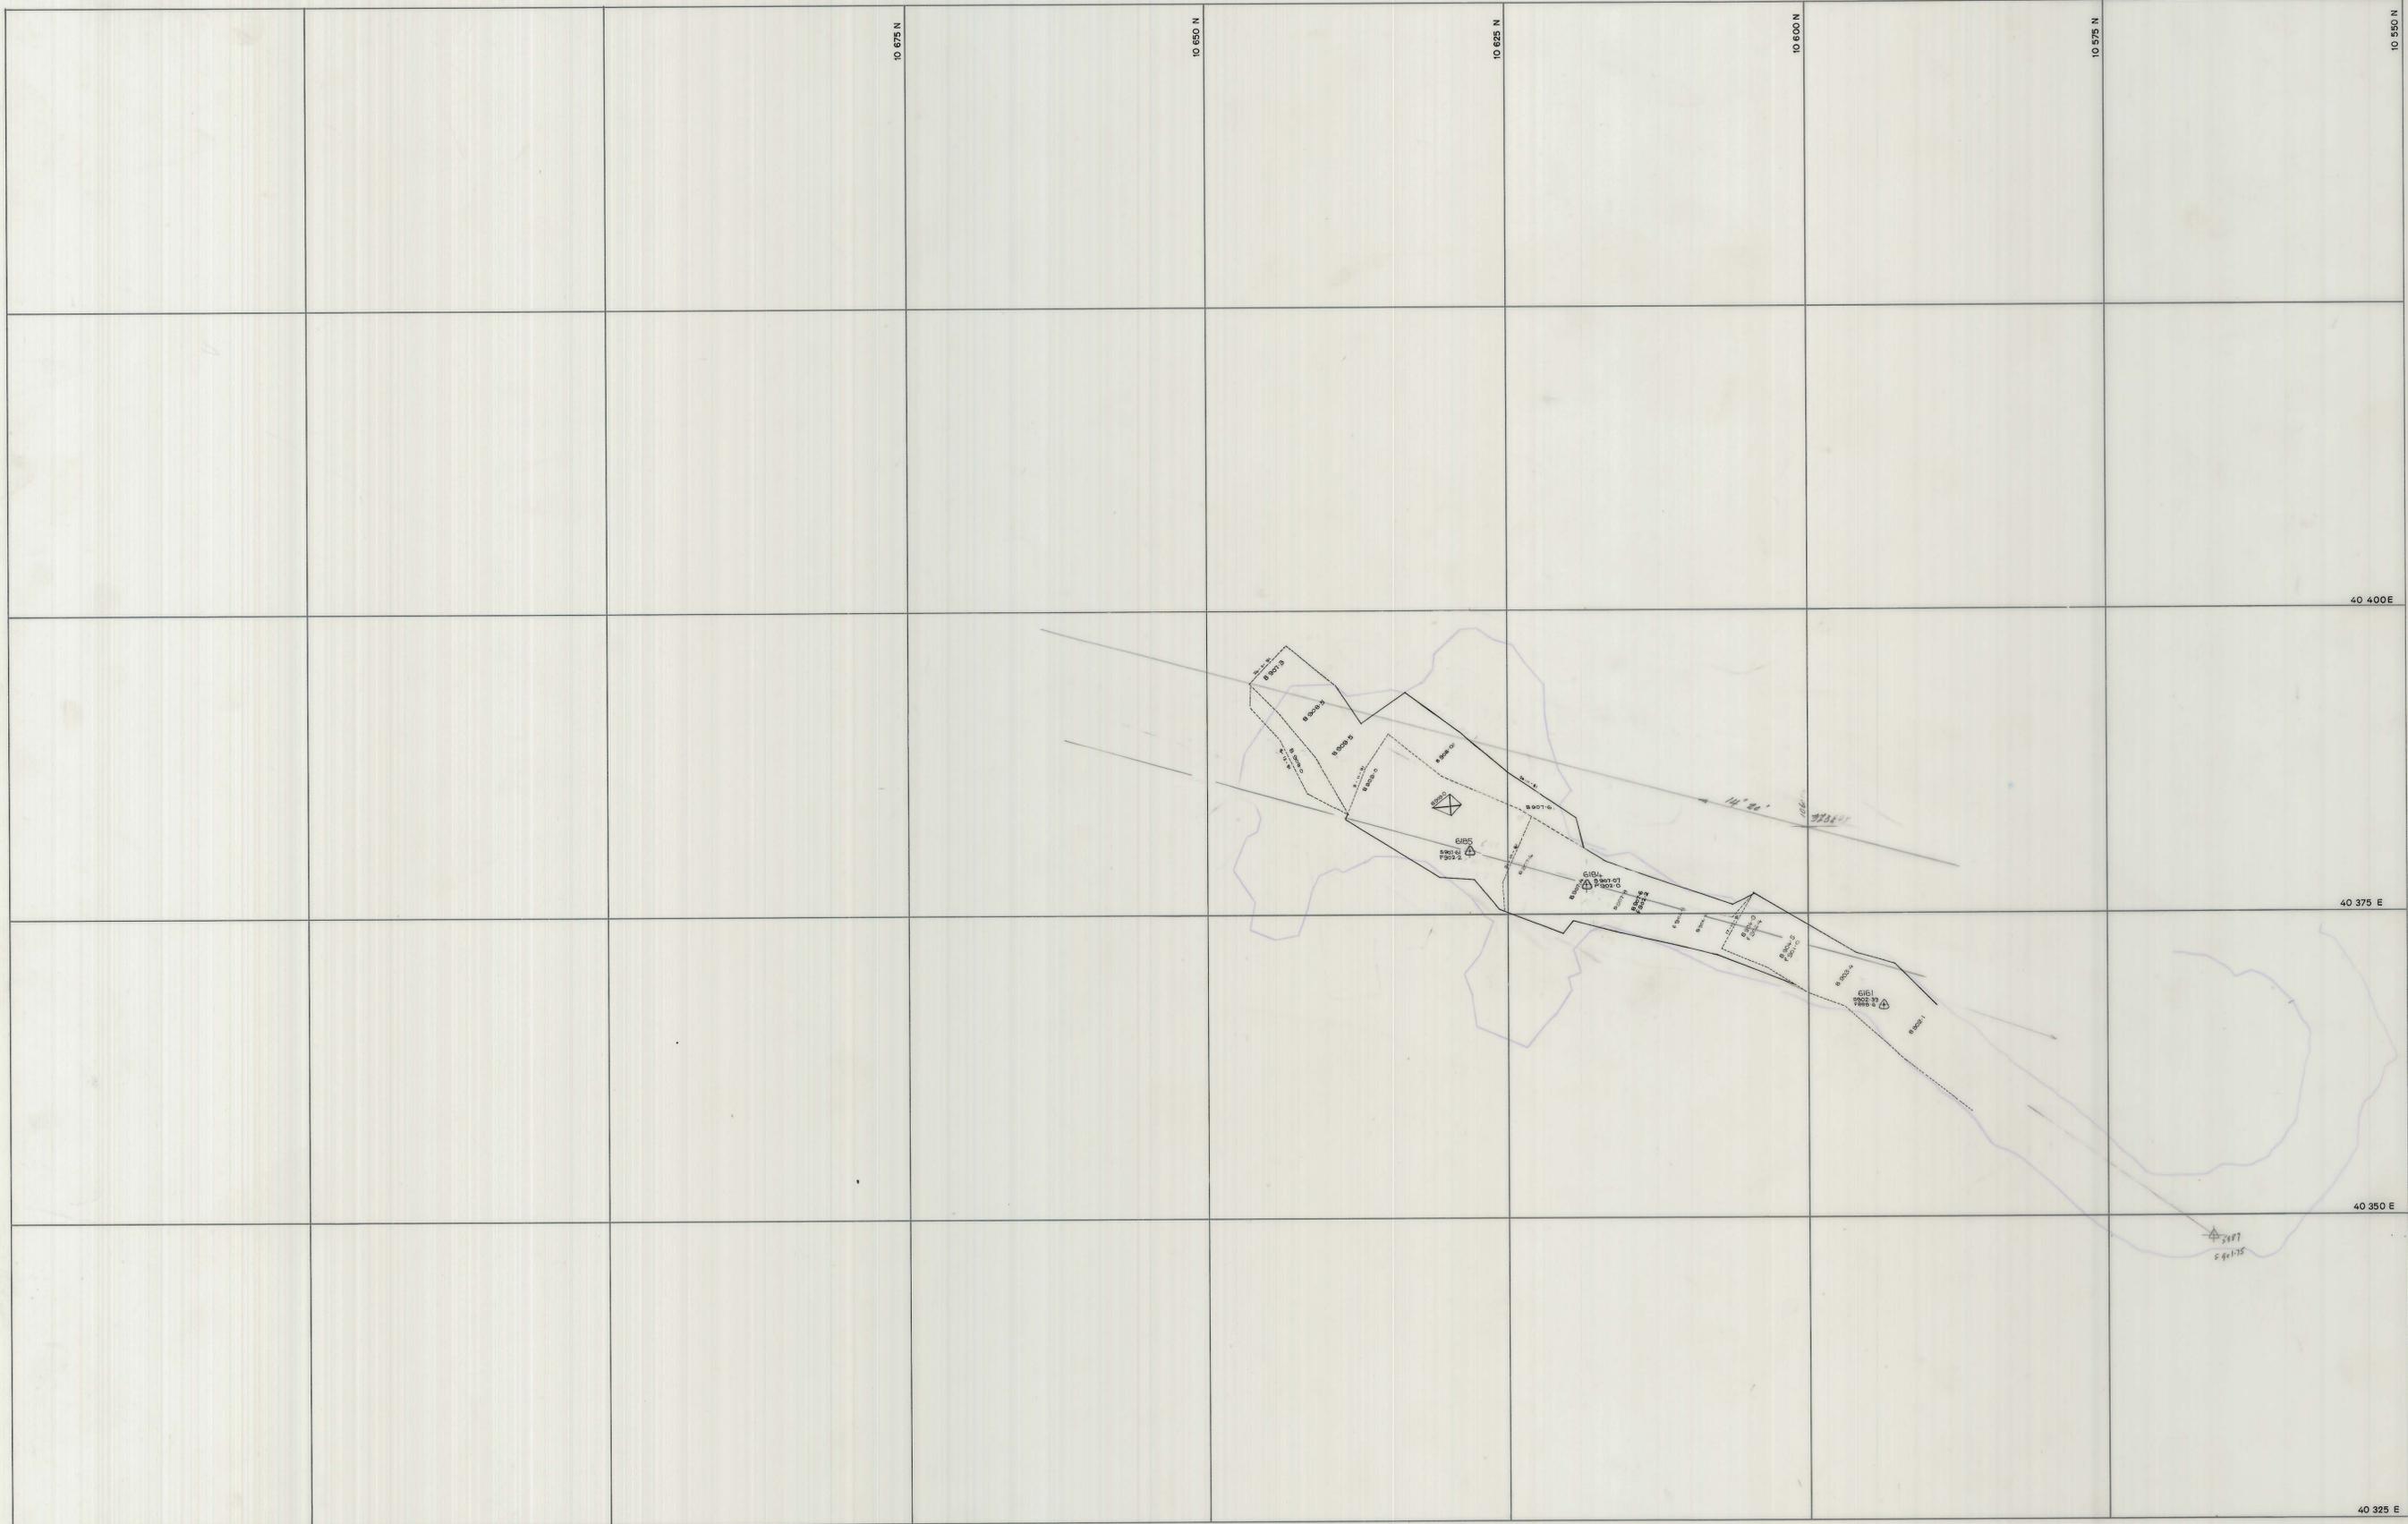

	SCALE 1: 250	 north	LOCATION BOLD HEAD MINE	 KING ISLAND SCHEELITE A DIVISION OF WARMAN INTERNATIONAL GRASSY KING ISLAND <small>PLAN NUMBER</small>
			SUBJECT D LENS - K 57 2nd lift	