



27 JUN 1981

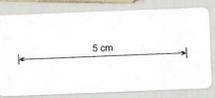


04BH13-166 248

K57 ②

0374\_4545

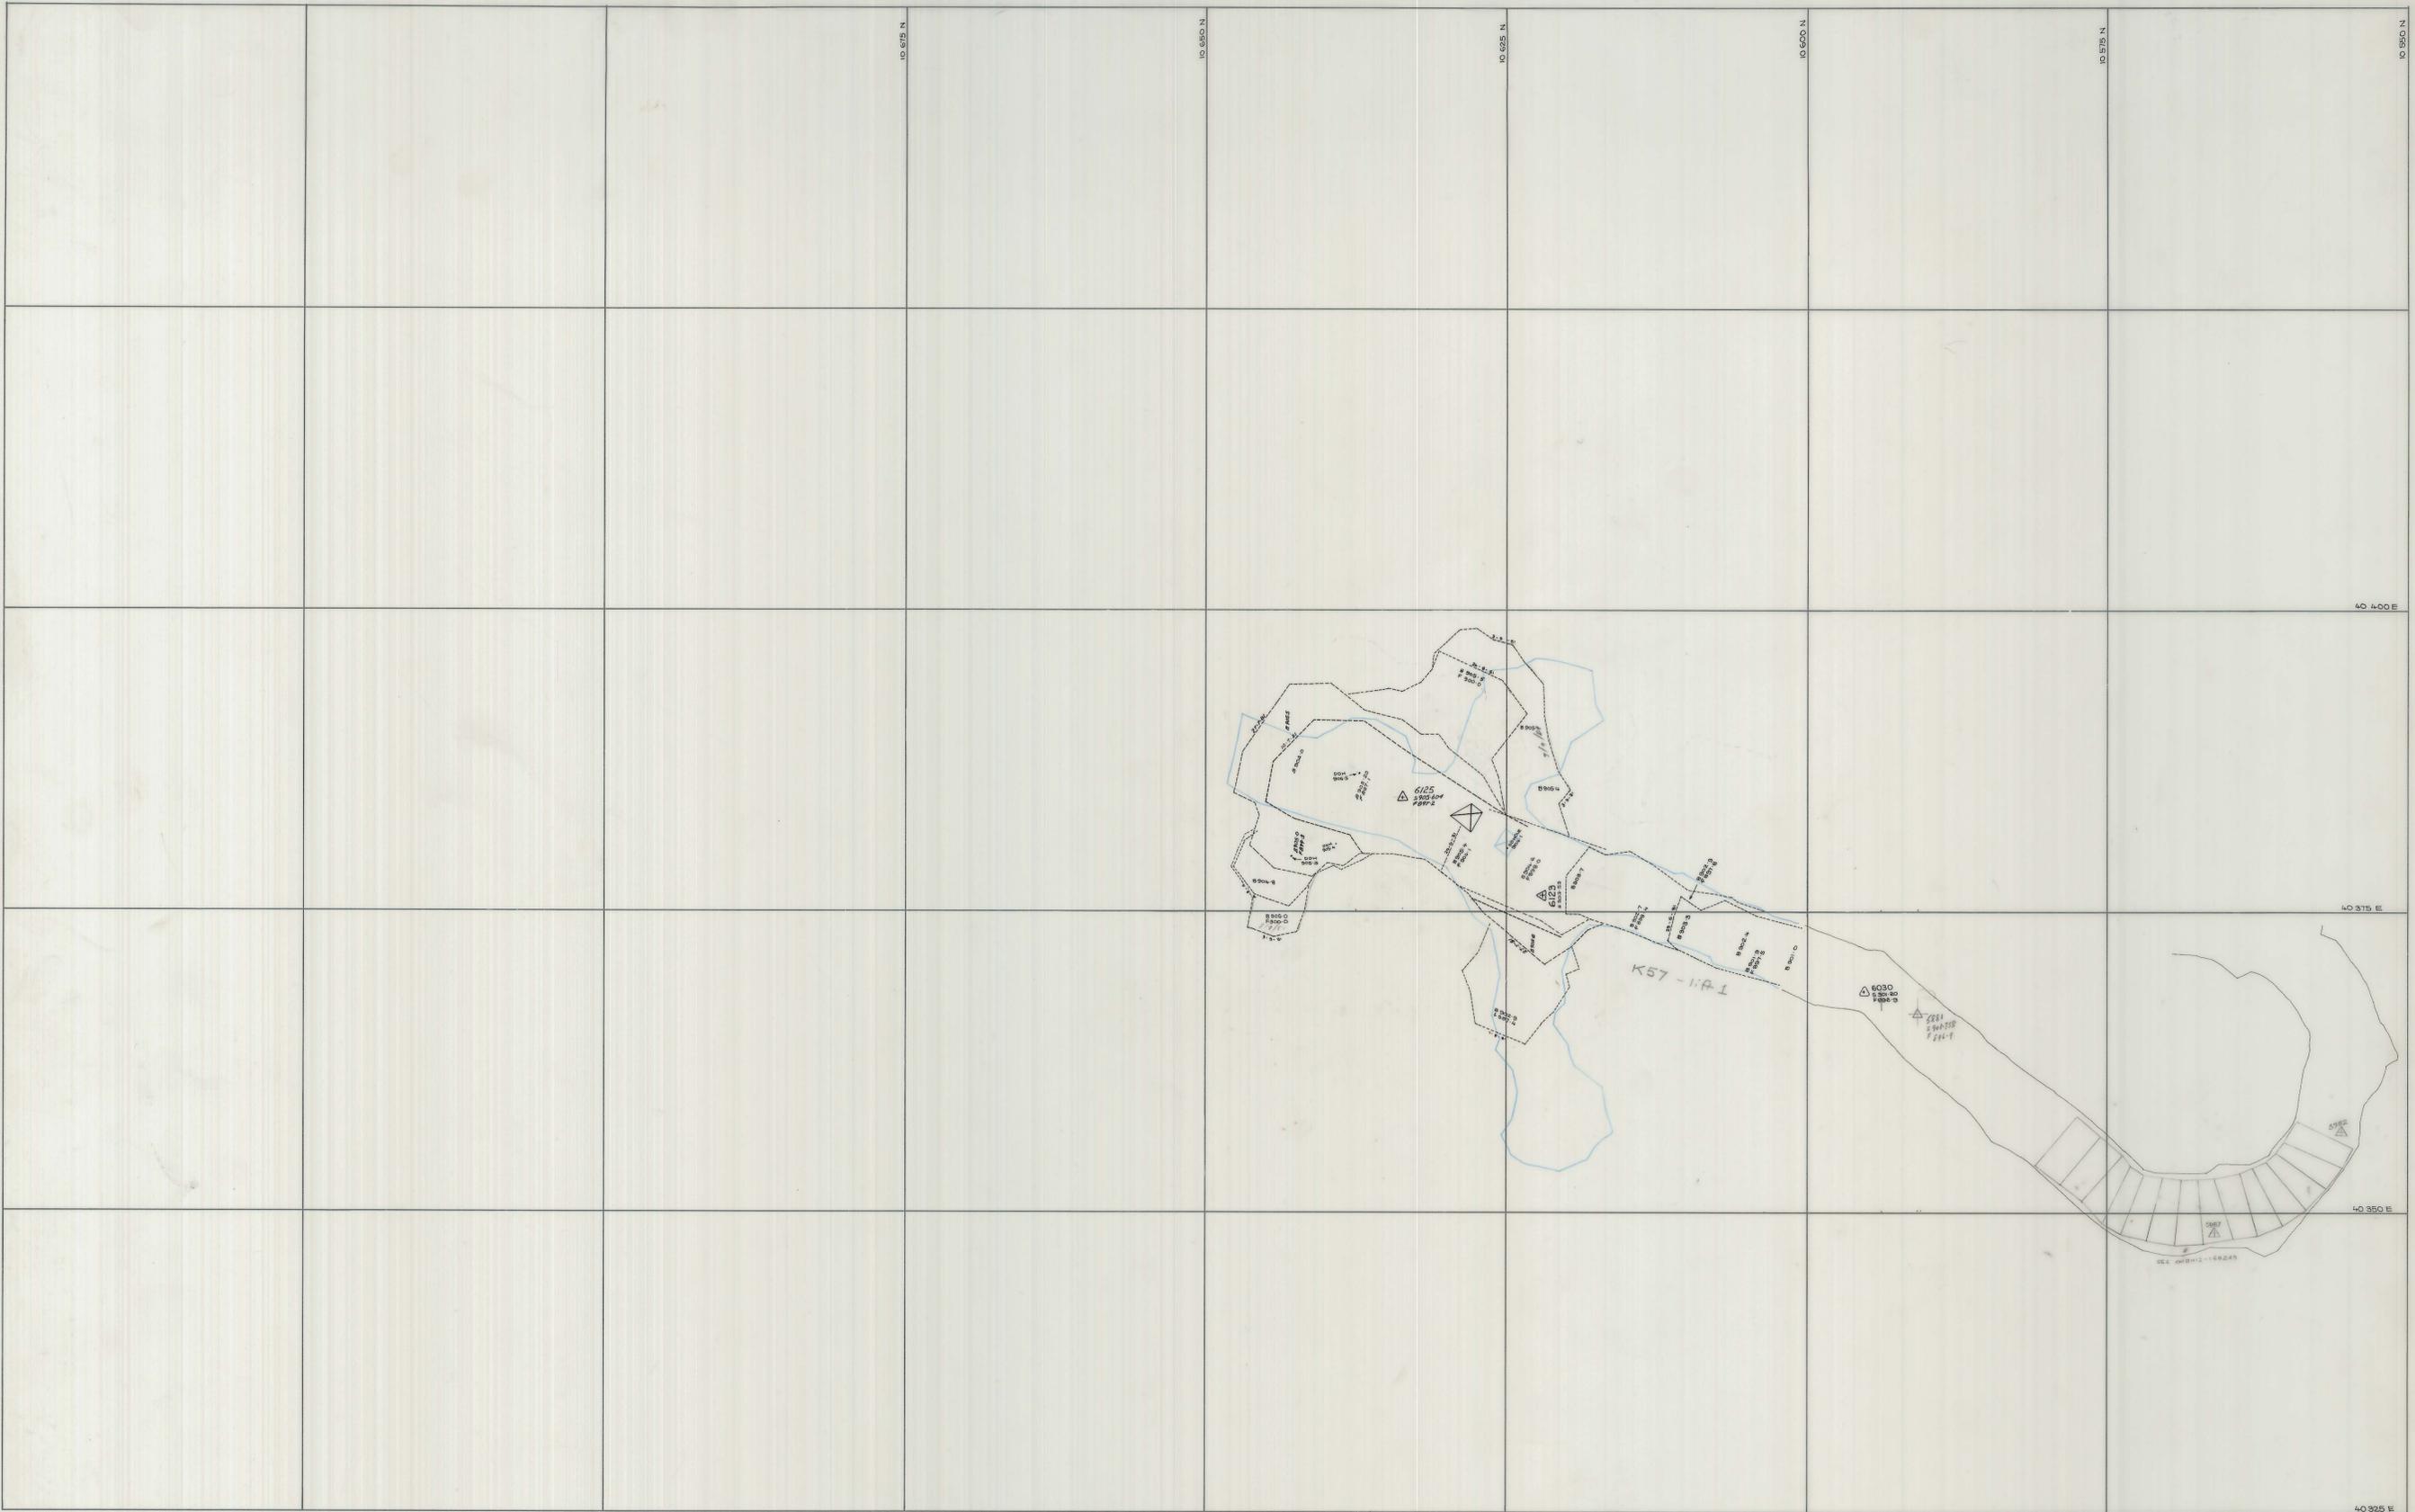

SCALE 1: 250

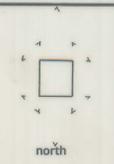

LOCATION BOLD HEAD MINE

SUBJECT

**D LENS - K 57**

**1st. lift**

**KIS KING ISLAND SCHEELITE**  
A DIVISION OF WARMAN INTERNATIONAL

GRASSY KING ISLAND

PLAN NUMBER **04BH13 - 166 248**