
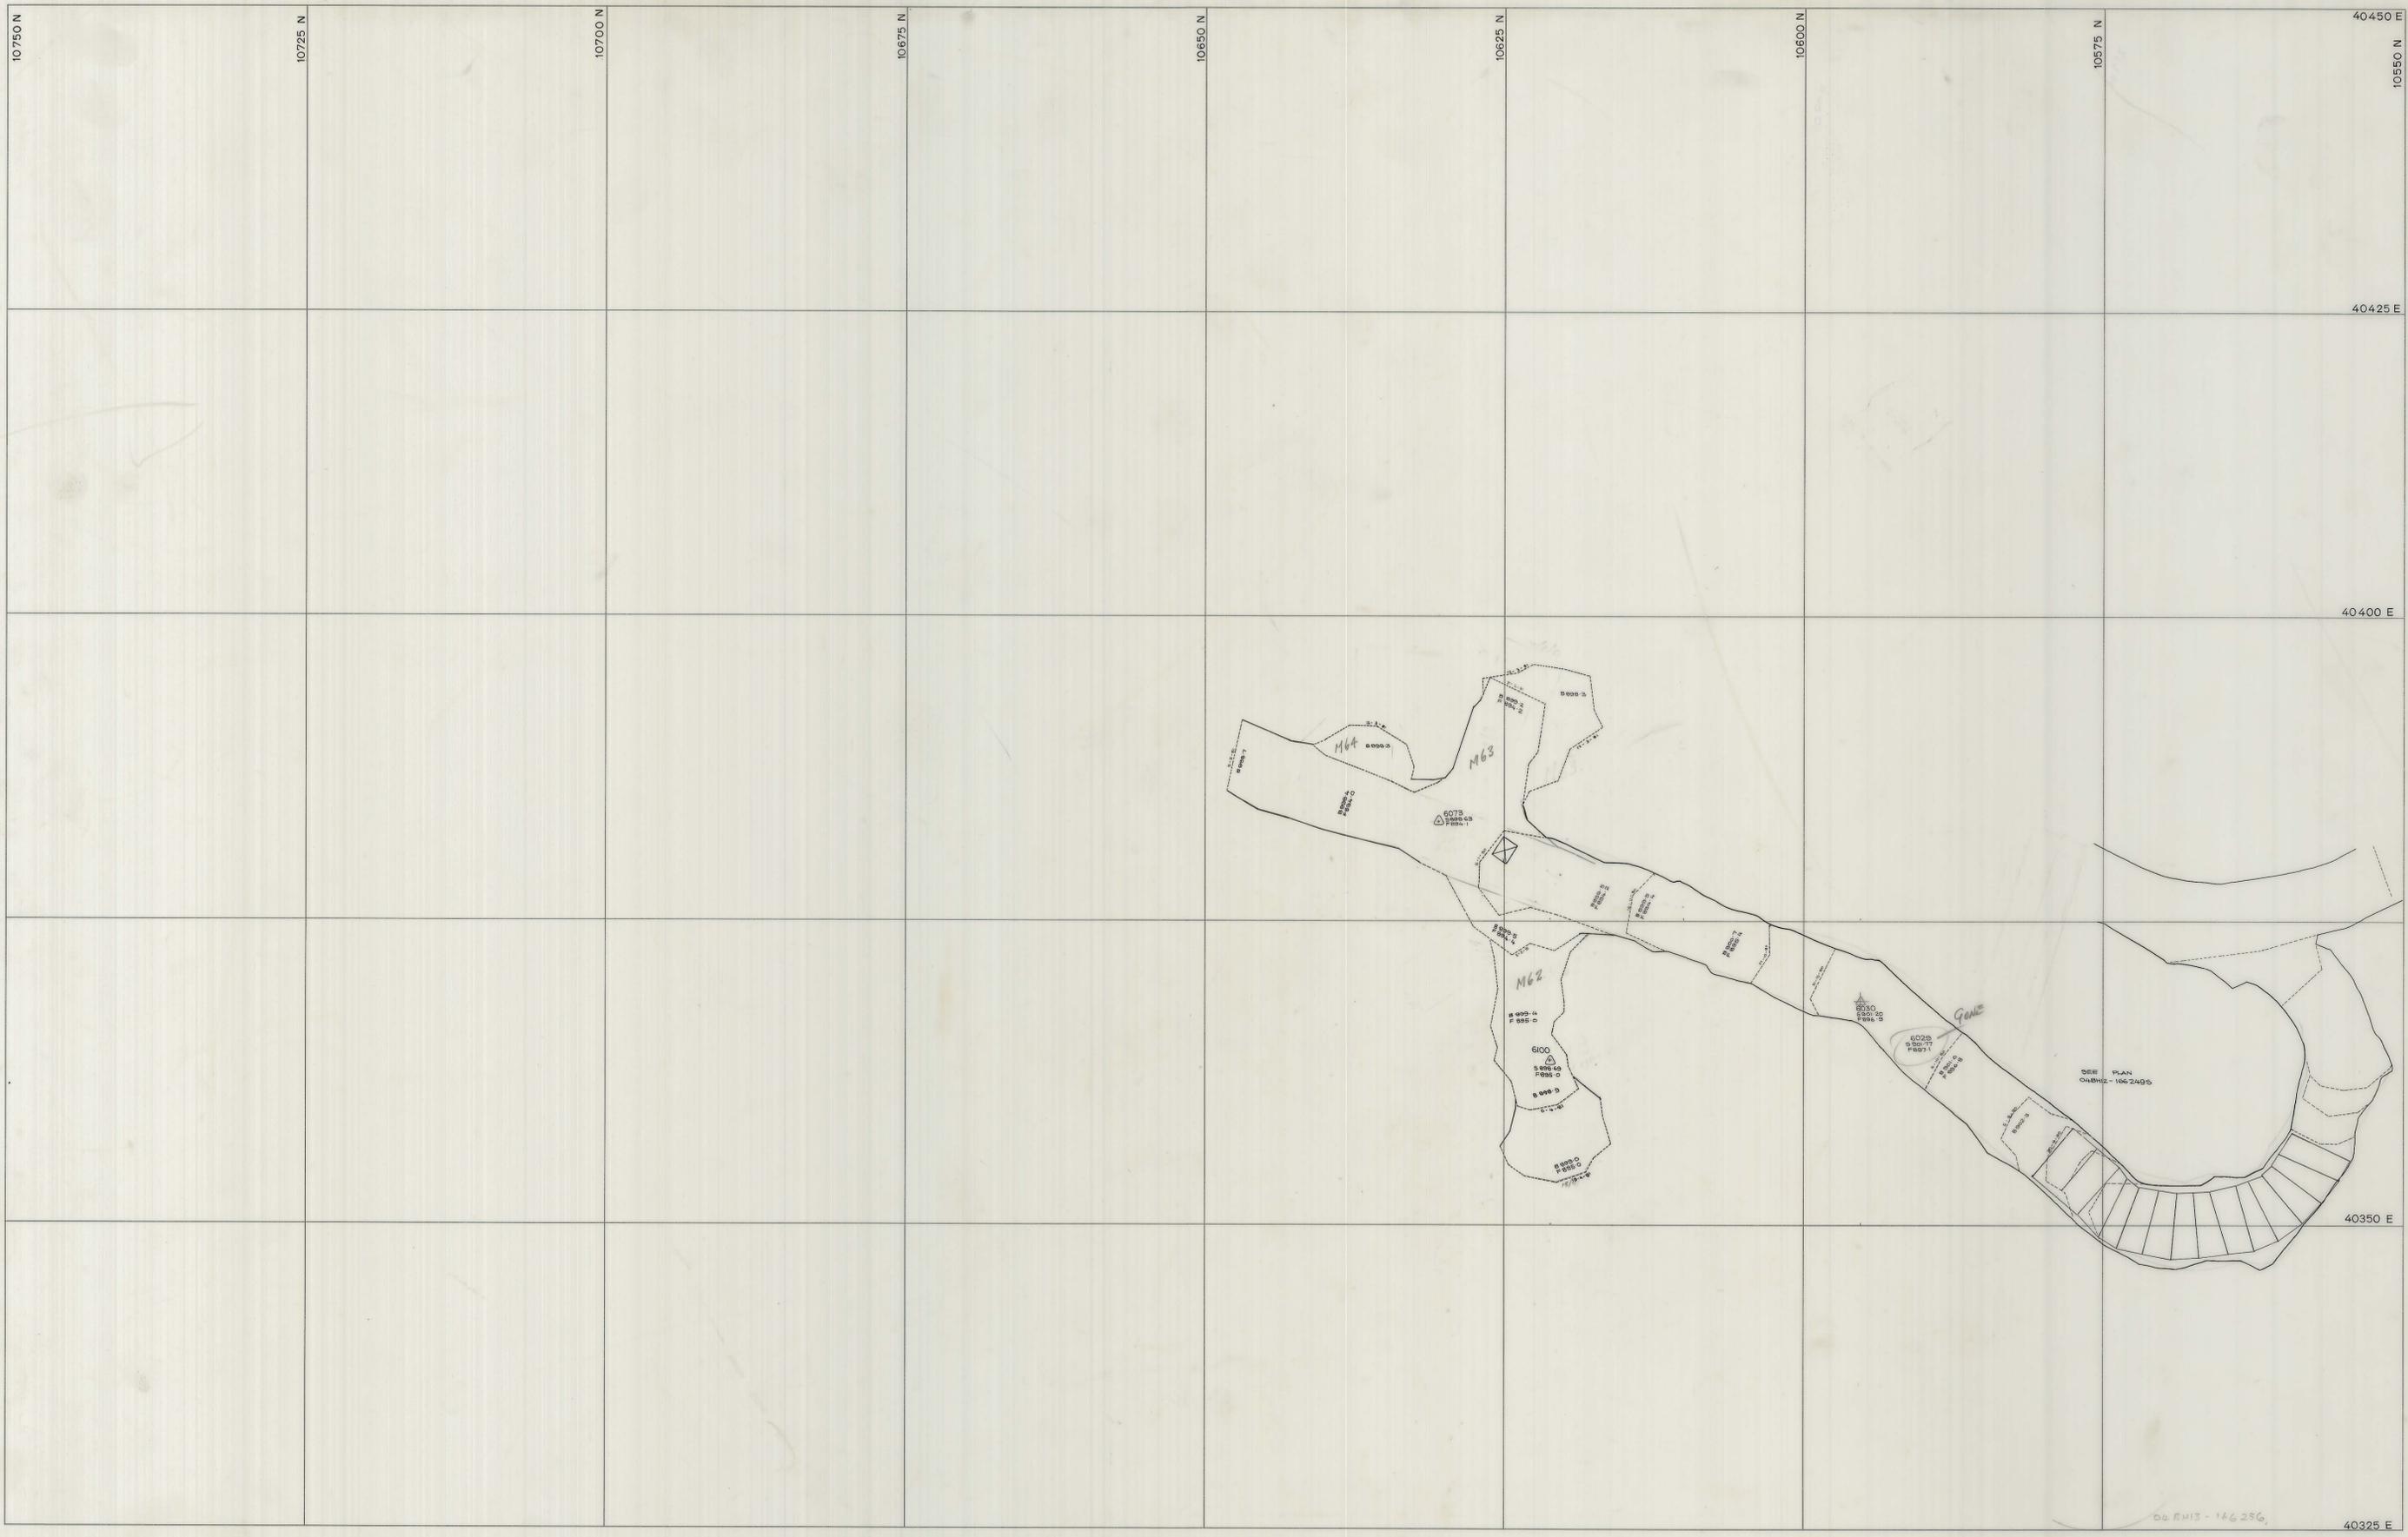


5 cm

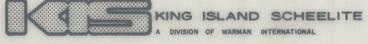

<p>M64 M63 M62</p>	SCALE 1: 250	north	LOCATION BOLD HEAD MINE	 <p>KING ISLAND SCHEELITE A DIVISION OF WARMAN INTERNATIONAL</p>