



BH 29 2007.

L56  
RISE.

0374\_4553

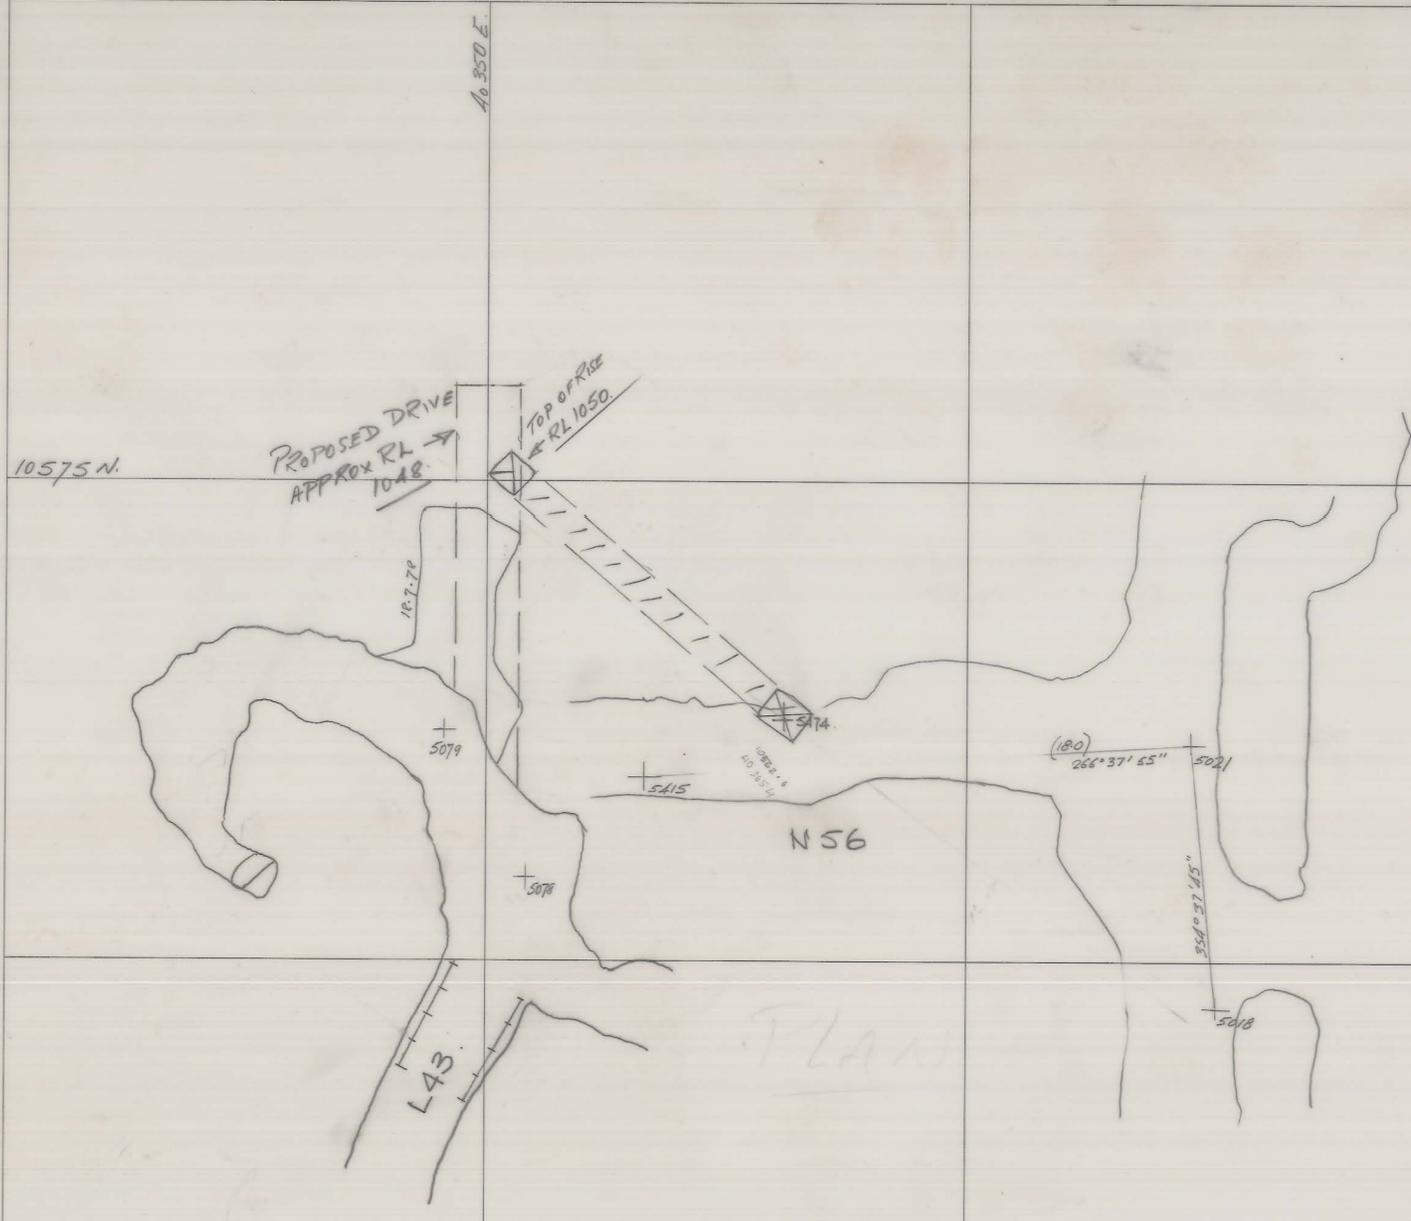

PLAN

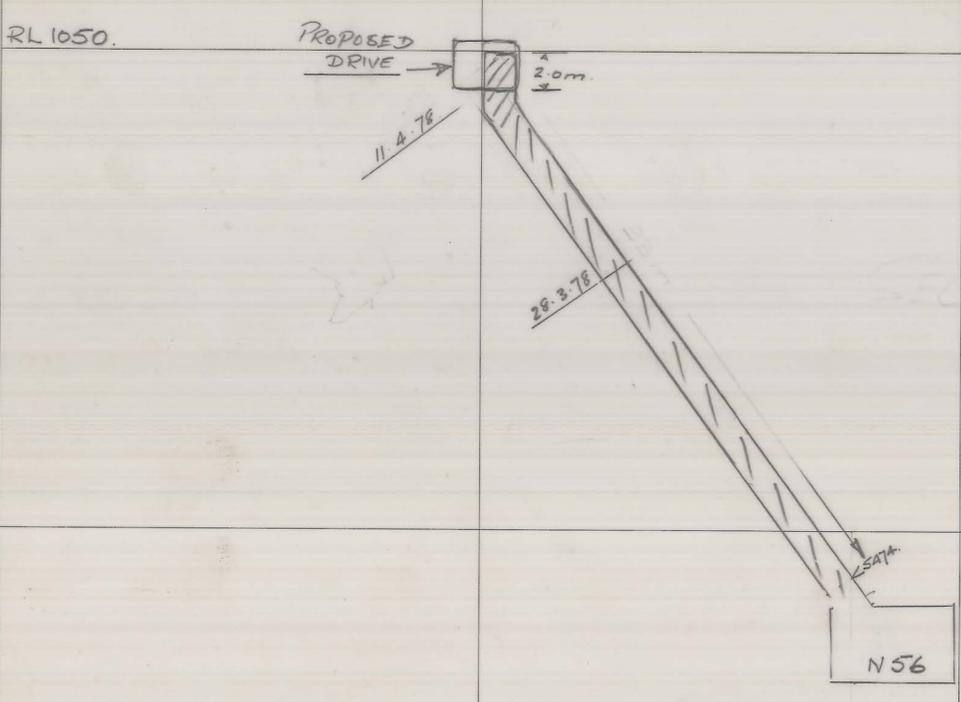

SECTION

L56 ORE PASS RISE.

29.3.78. JL

Scale 250