


04BH13 - 166 196 S

R 60  
LIFT 9

0374\_4557

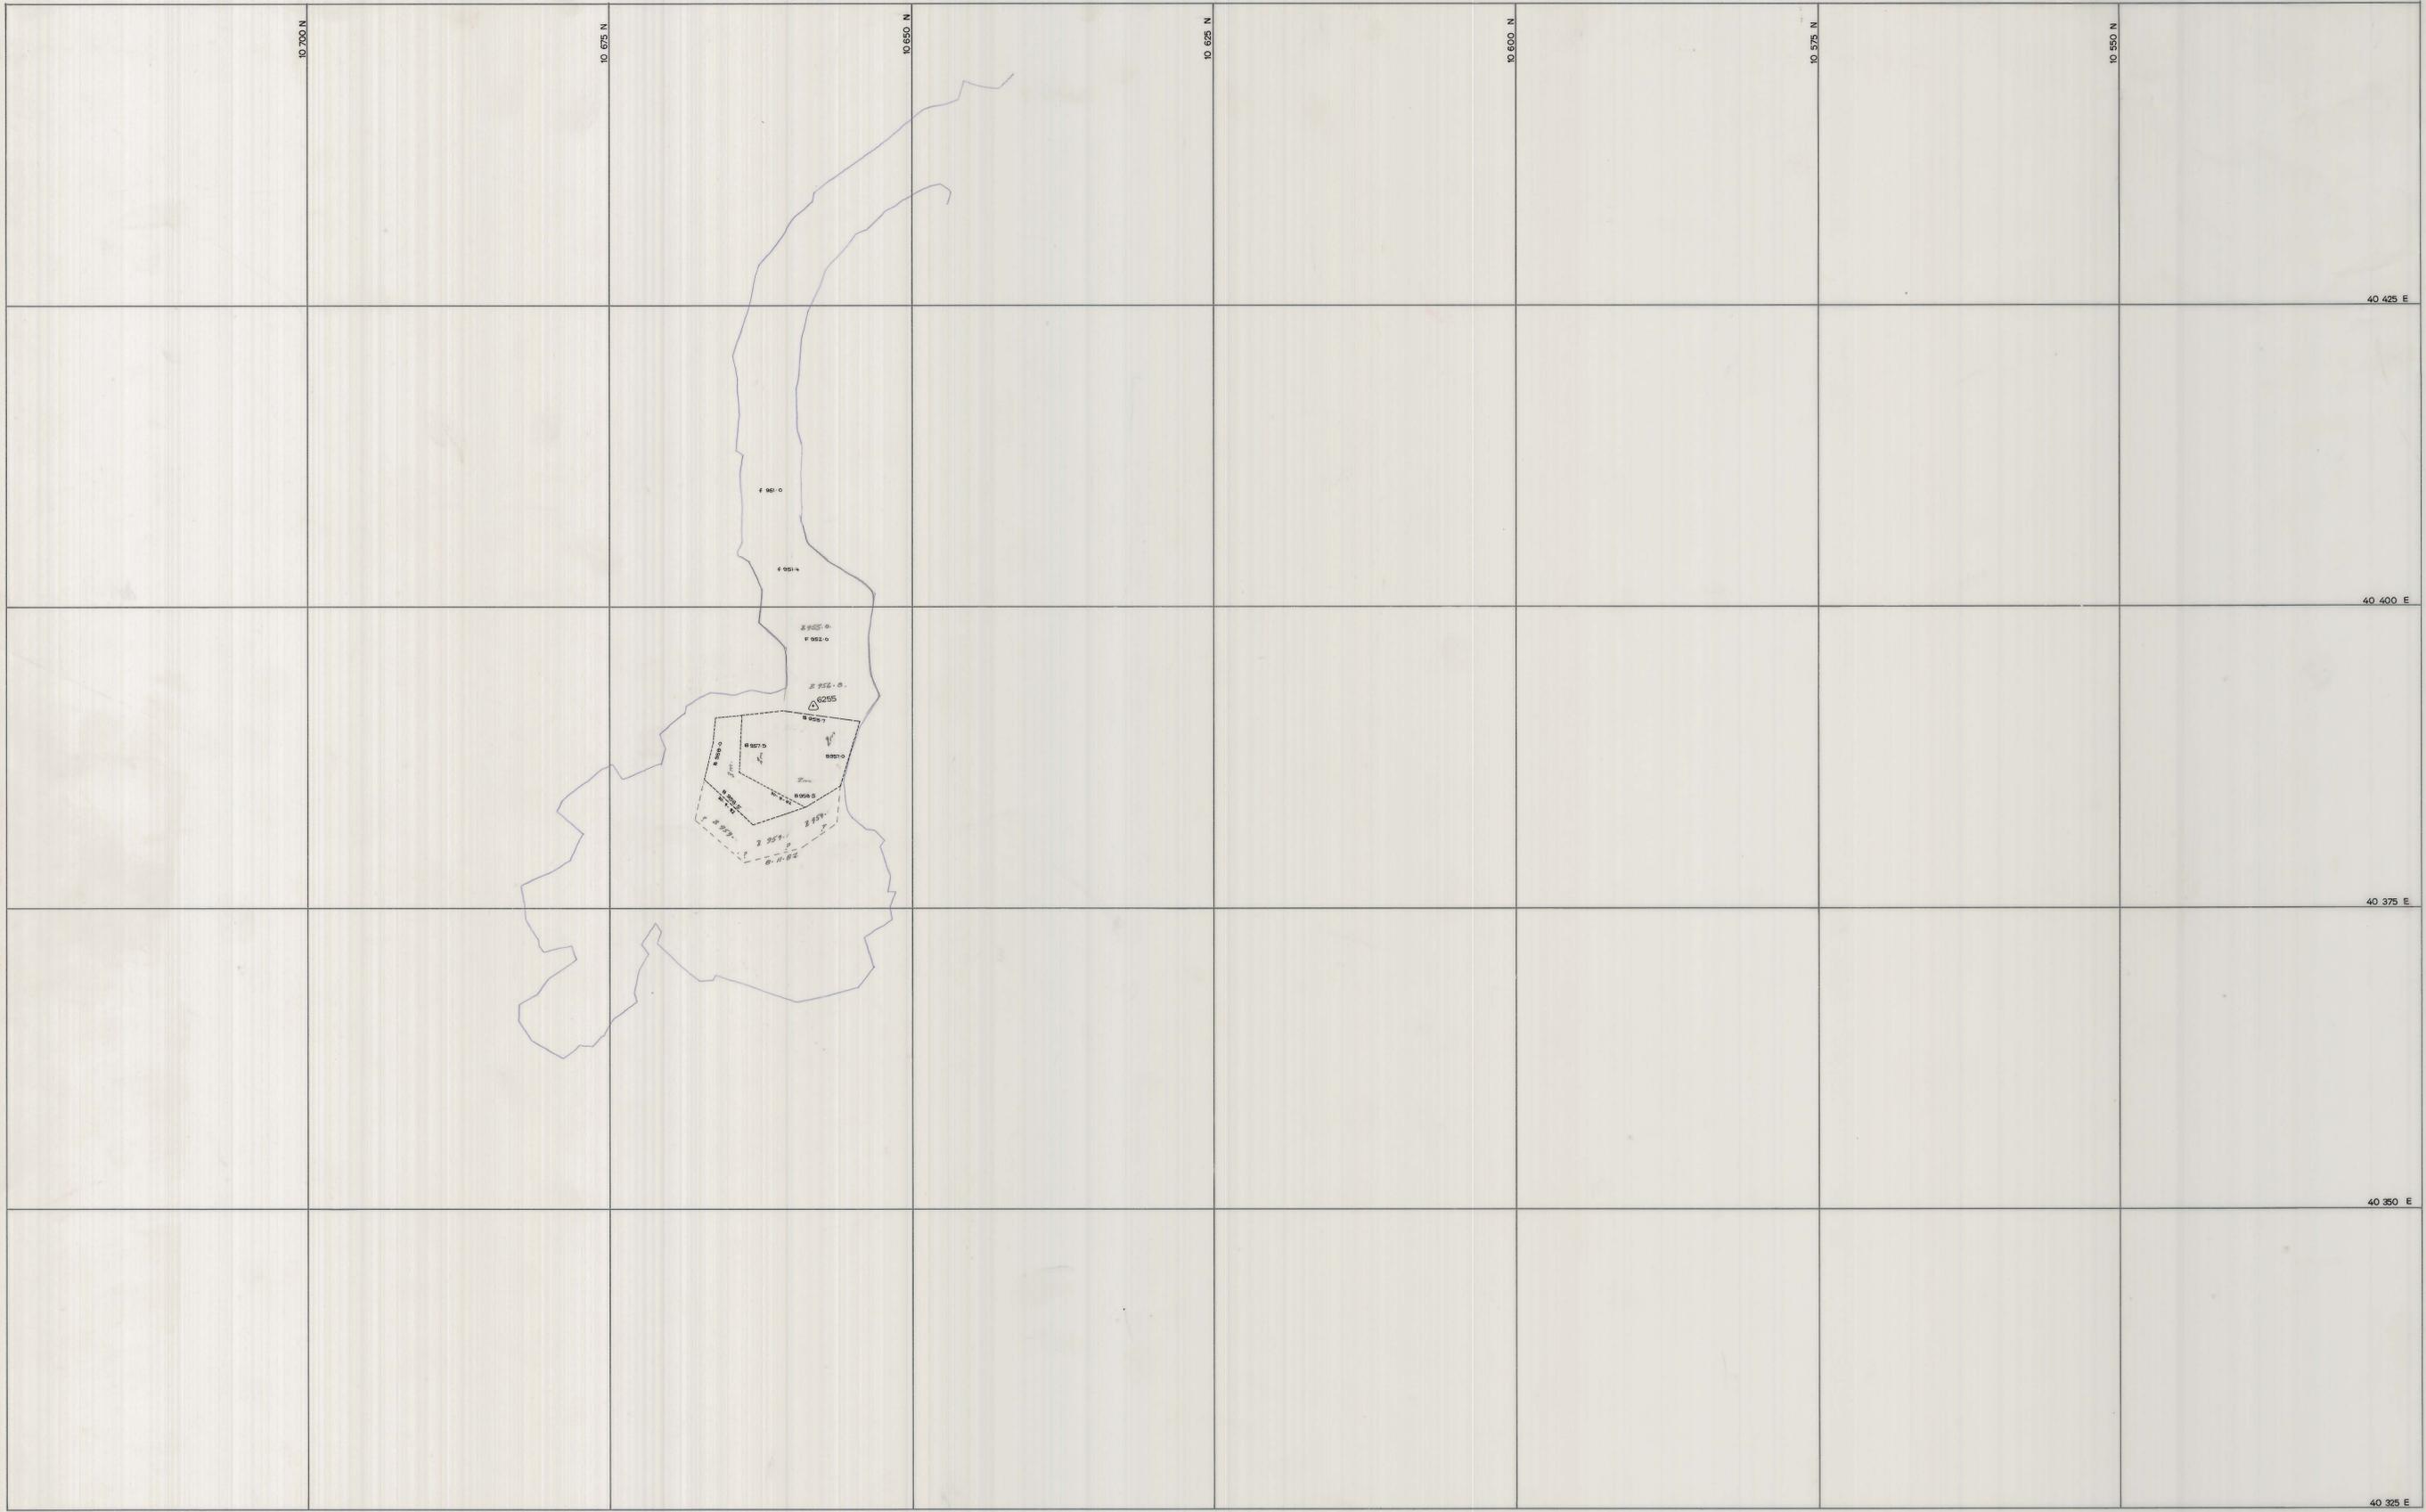

SCALE 1:250



LOCATION BOLD HEAD MINE

SUBJECT  
R 60 STOPE  
9th lift



GRASSY KING ISLAND

PLAN NUMBER 04BH13 - 166 196 S