
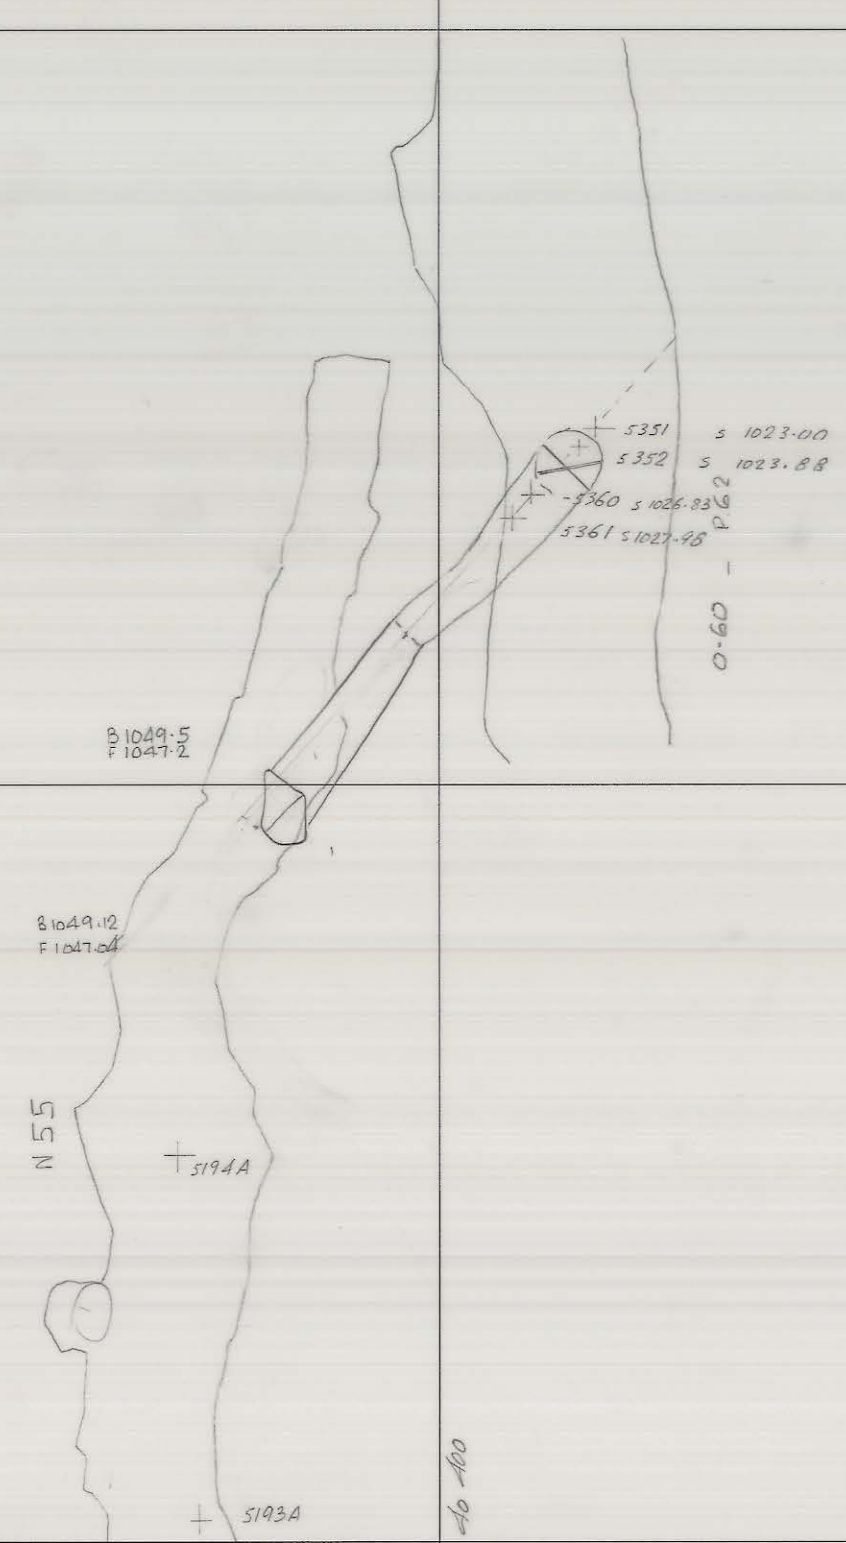


04 BH 29 - 2001 29- 2001

0374-4561

5 cm

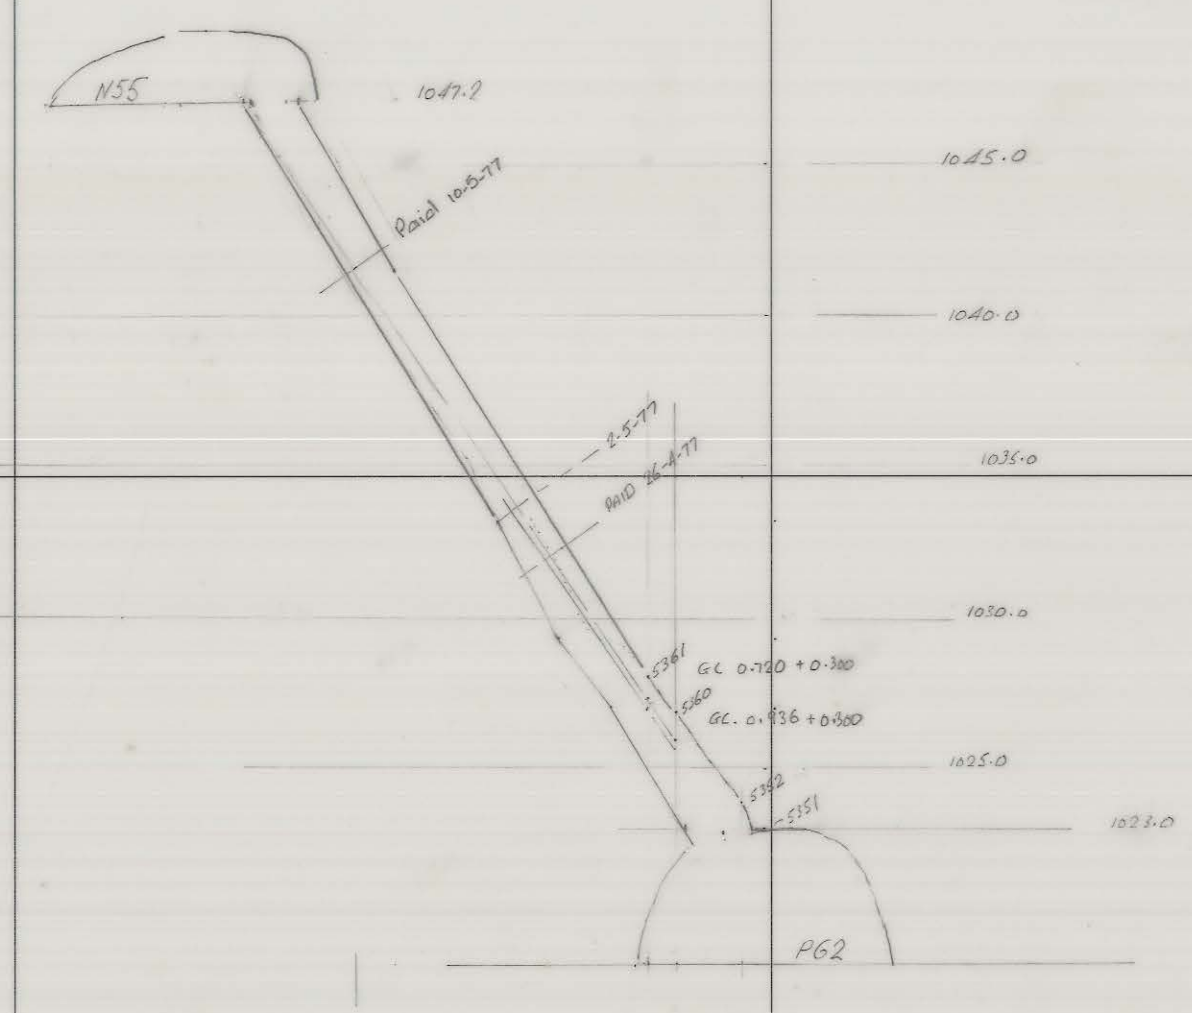

063 RISE
1 in 250