
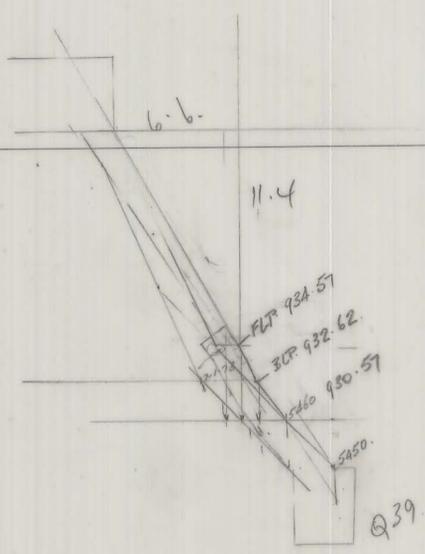


5 cm

0374_4565

048H29-2006

Q39
DRAINAGE
RISE

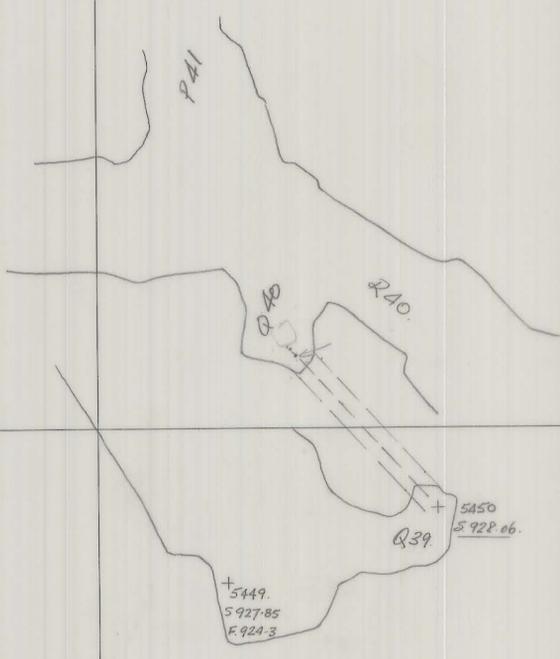

SCALE 1

LOCATION

SUBJECT

north

KIS KING ISLAND SCHEELITE
A DIVISION OF WARMAN INTERNATIONAL

GRASSY KING ISLAND

PLAN NUMBER