


0374-459

O4DM15-1070
SHEELITE PLAN 28-8-79

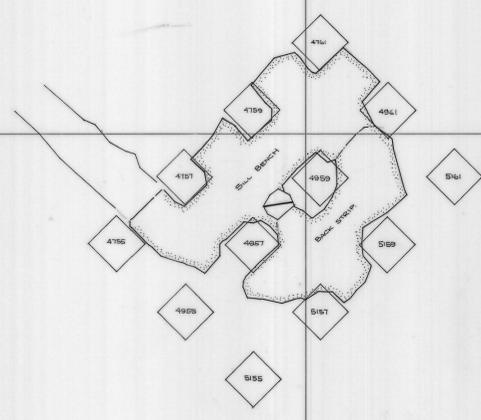

220 1800 E

220 1900 E

220 2000 E



563 800 N

563 850 N

563 900 N

563 950 N

SCALE 1:500

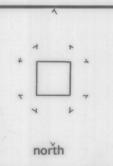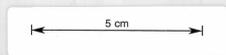

LOCATION

DOLPHIN MINE

SUBJECT

SWAN STOPE
3rd lift



KING ISLAND SCHEELITE
A DIVISION OF WARMAN INTERNATIONAL

PLAN NUMBER

O4DM15 - 1070