


0374-462

04DM15 - 1077
SECTION 2018 28-8-78

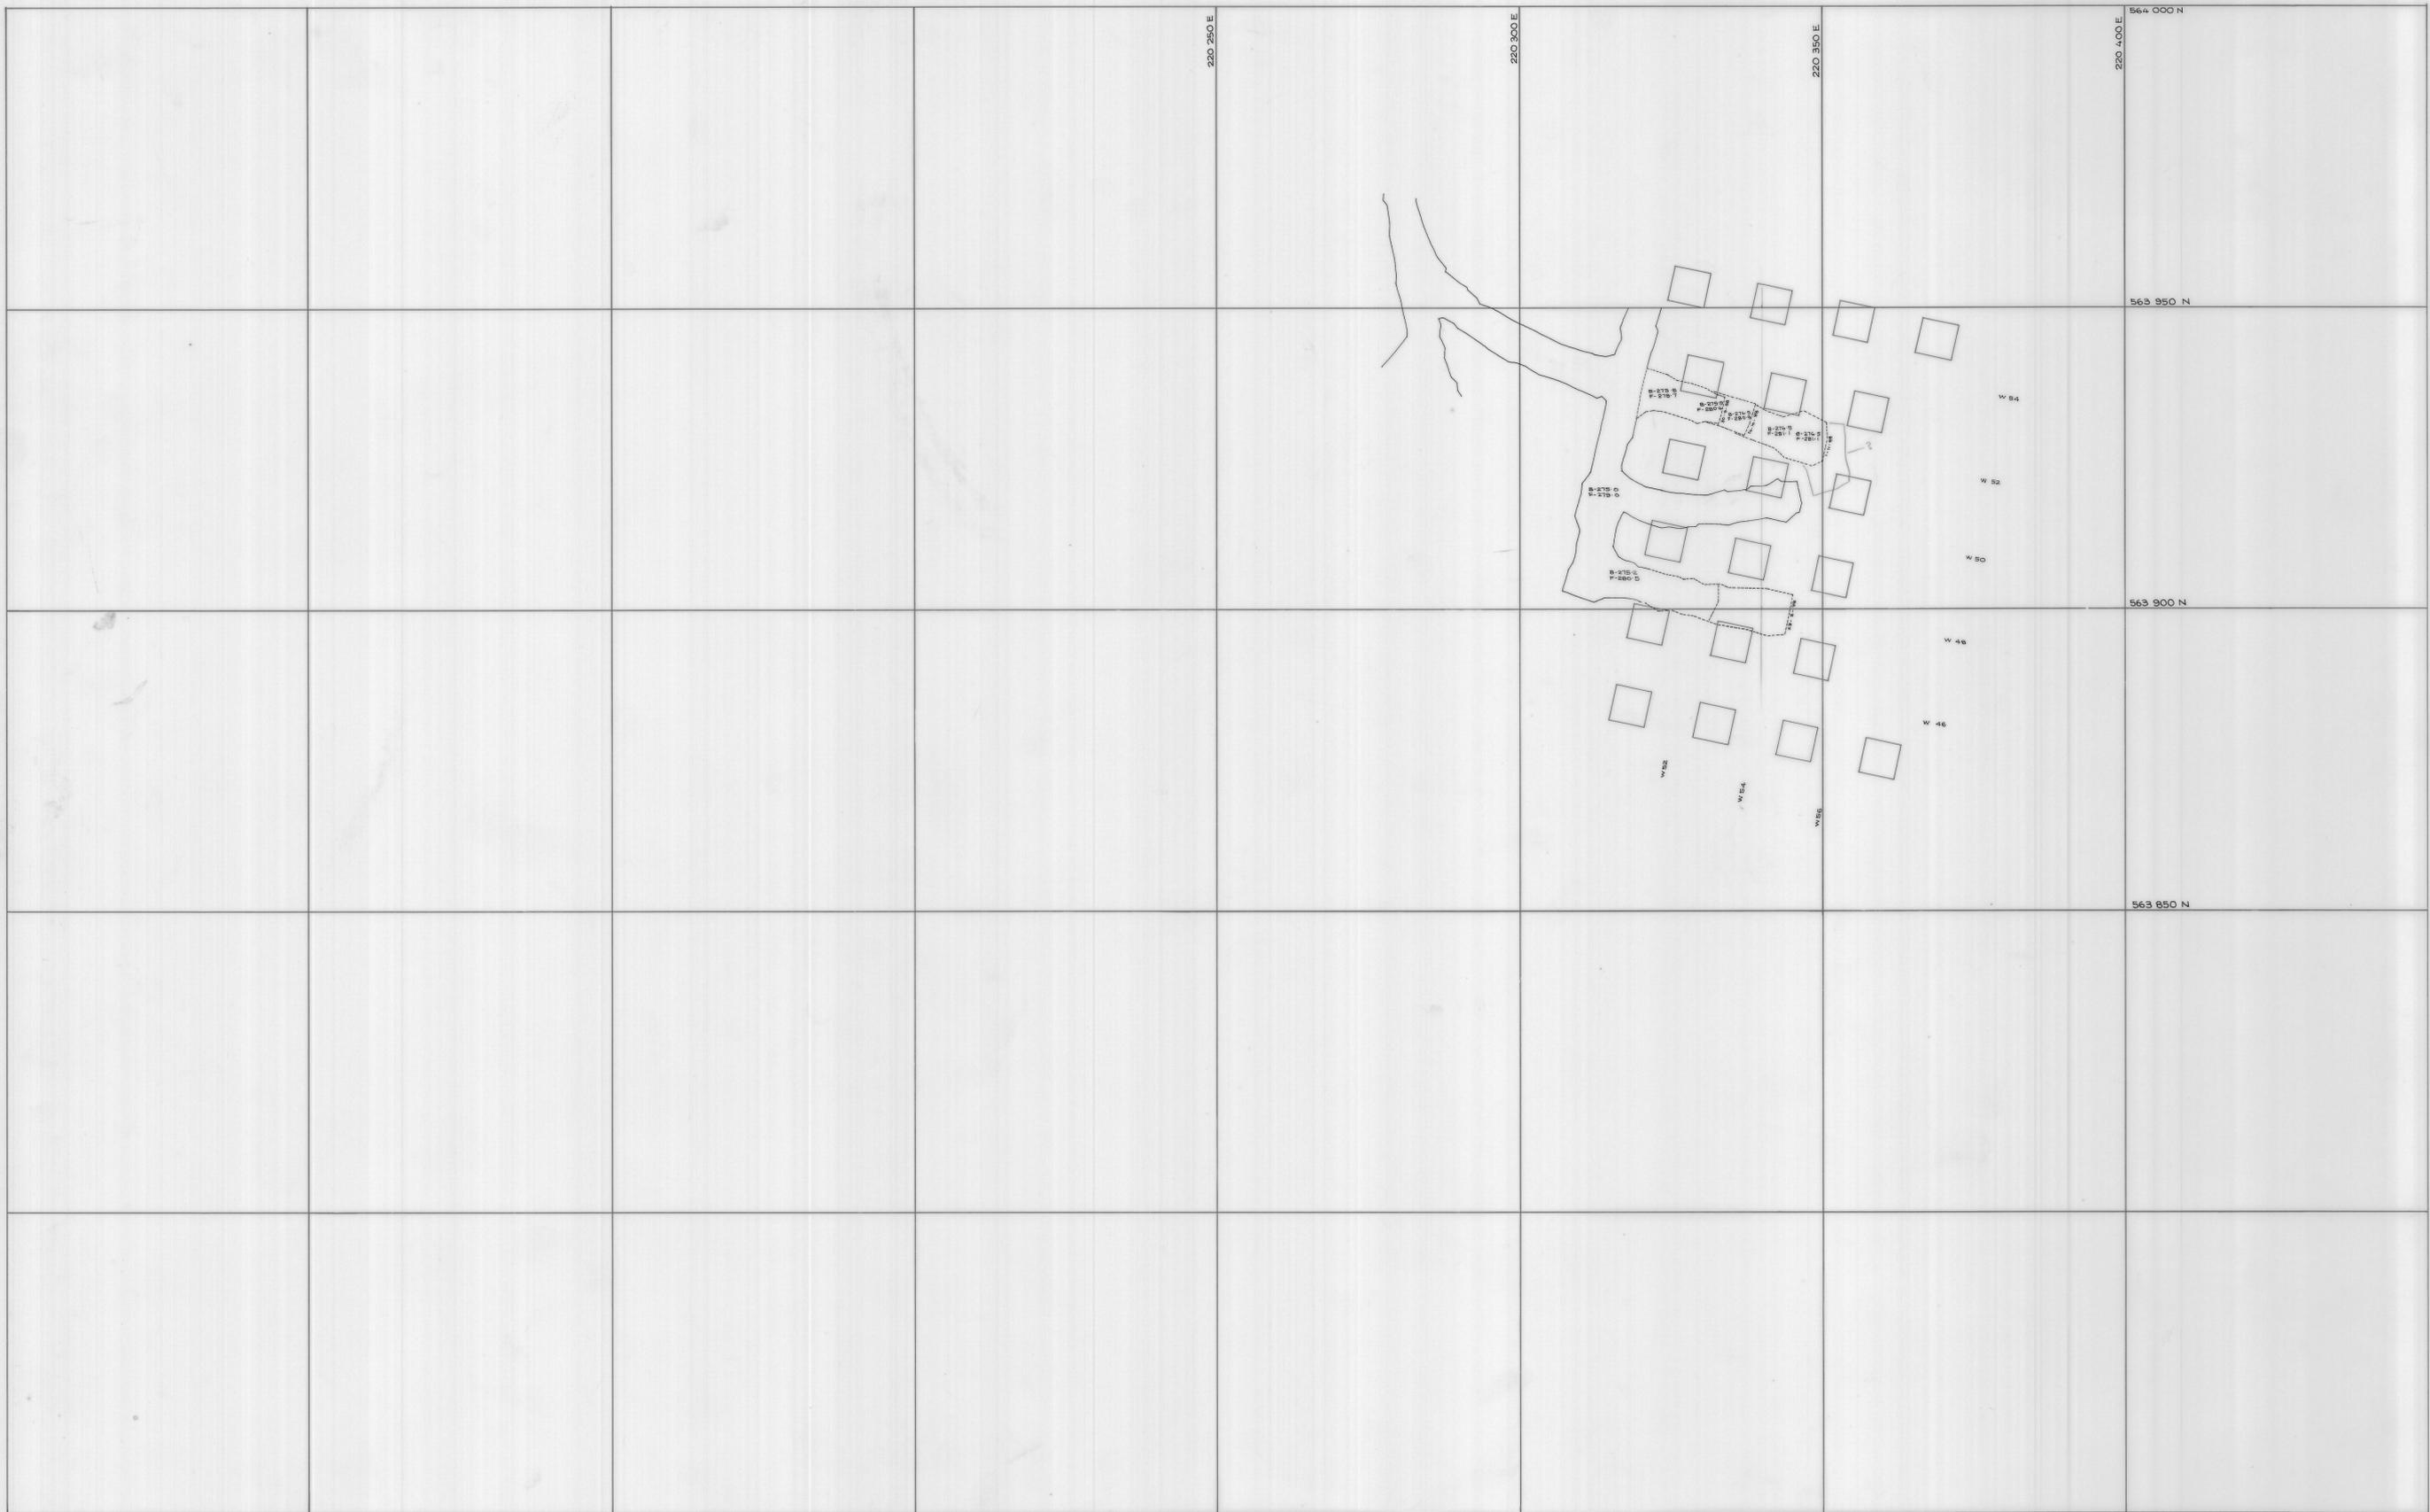

SCALE 1:500

5 cm



LOCATION

DOLPHIN MINE

SUBJECT

WEDGE REMNANT STOPE
lift n° 2

KIS KING ISLAND SCHEELITE
A DIVISION OF WARMAN INTERNATIONAL

GRASSY KING ISLAND

PLAN NUMBER

04DM15 - 1077