


27 JUN 1981

0374-467

1:500
Open Cut
C-2

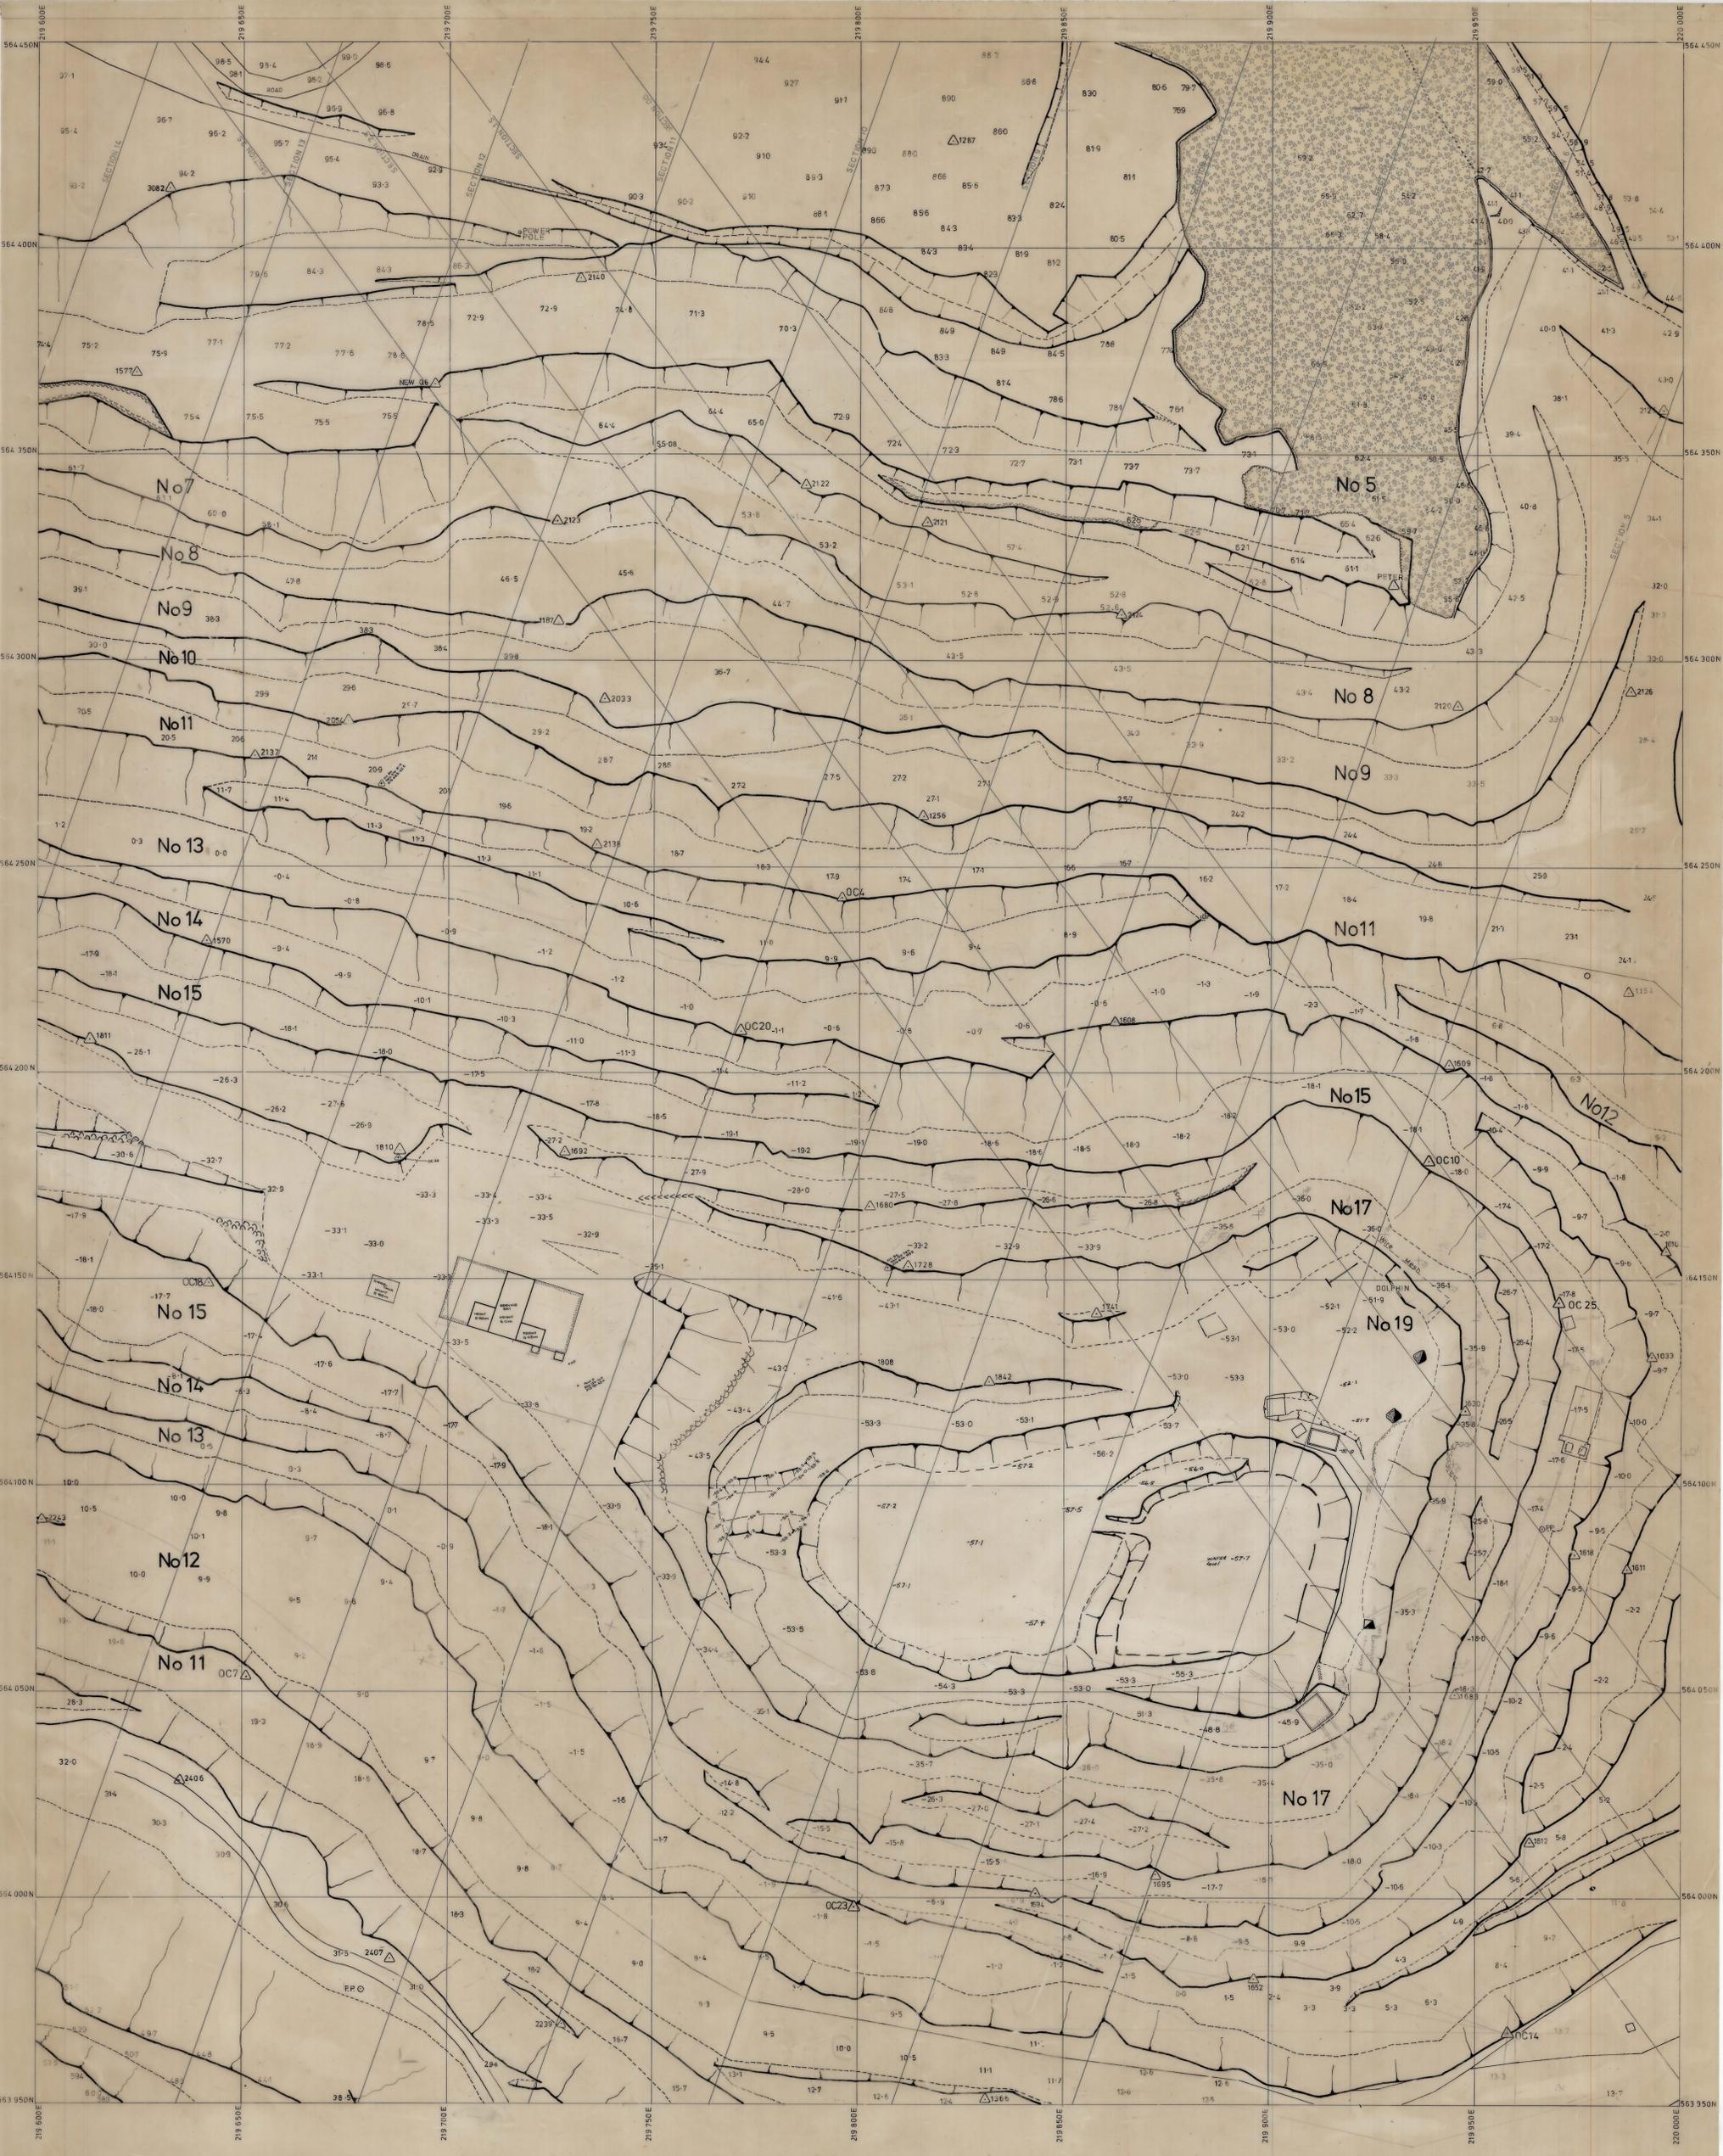

KING ISLAND SCHEELITE LTD.

No 1 AREA OPEN CUT
SCALE 1:500

