


5 cm

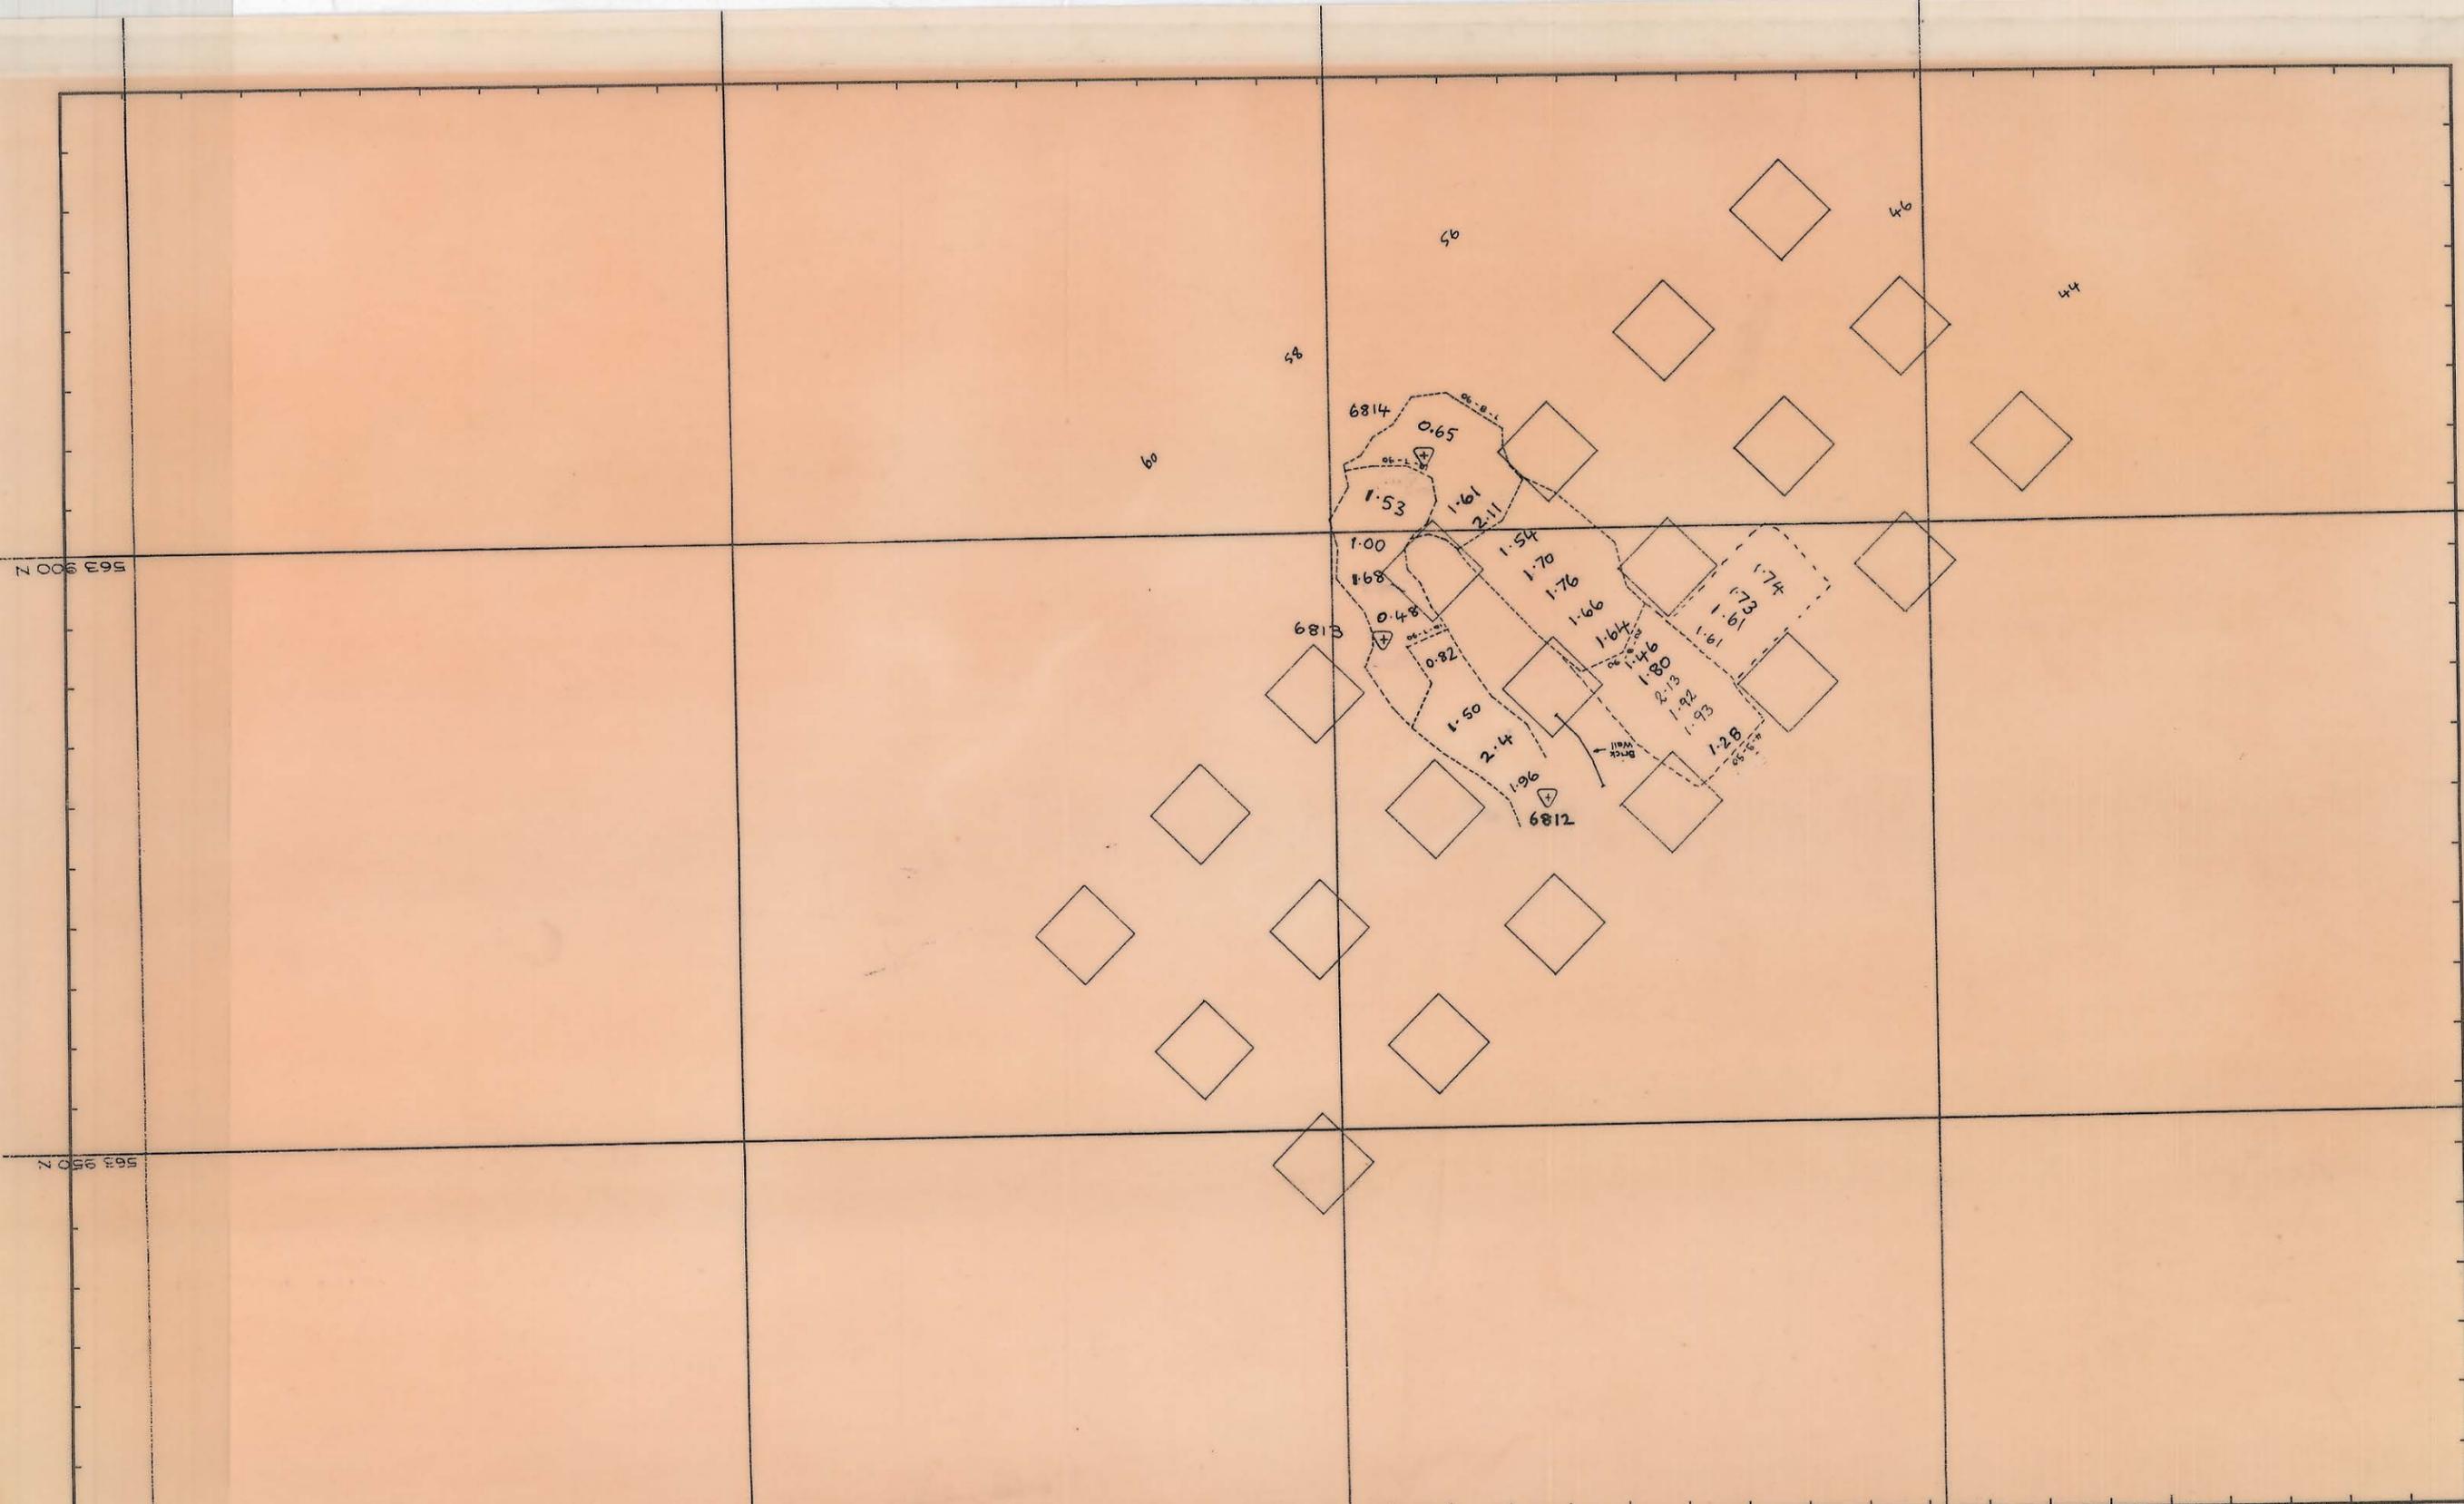

563 900 Z

565 895 Z

REF. PLAN

GEOLOGY	
SURVEY	
PLANNING	
ROCK MEC.	
GRADE CON.	
DRAFTING	
T.S.S.	

SCALE 1:500

KIS KING ISLAND SCHEELITE
GRASSY KING ISLAND

S. SWAN LIFT 06

DRAWING NUMBER