


0374_4676

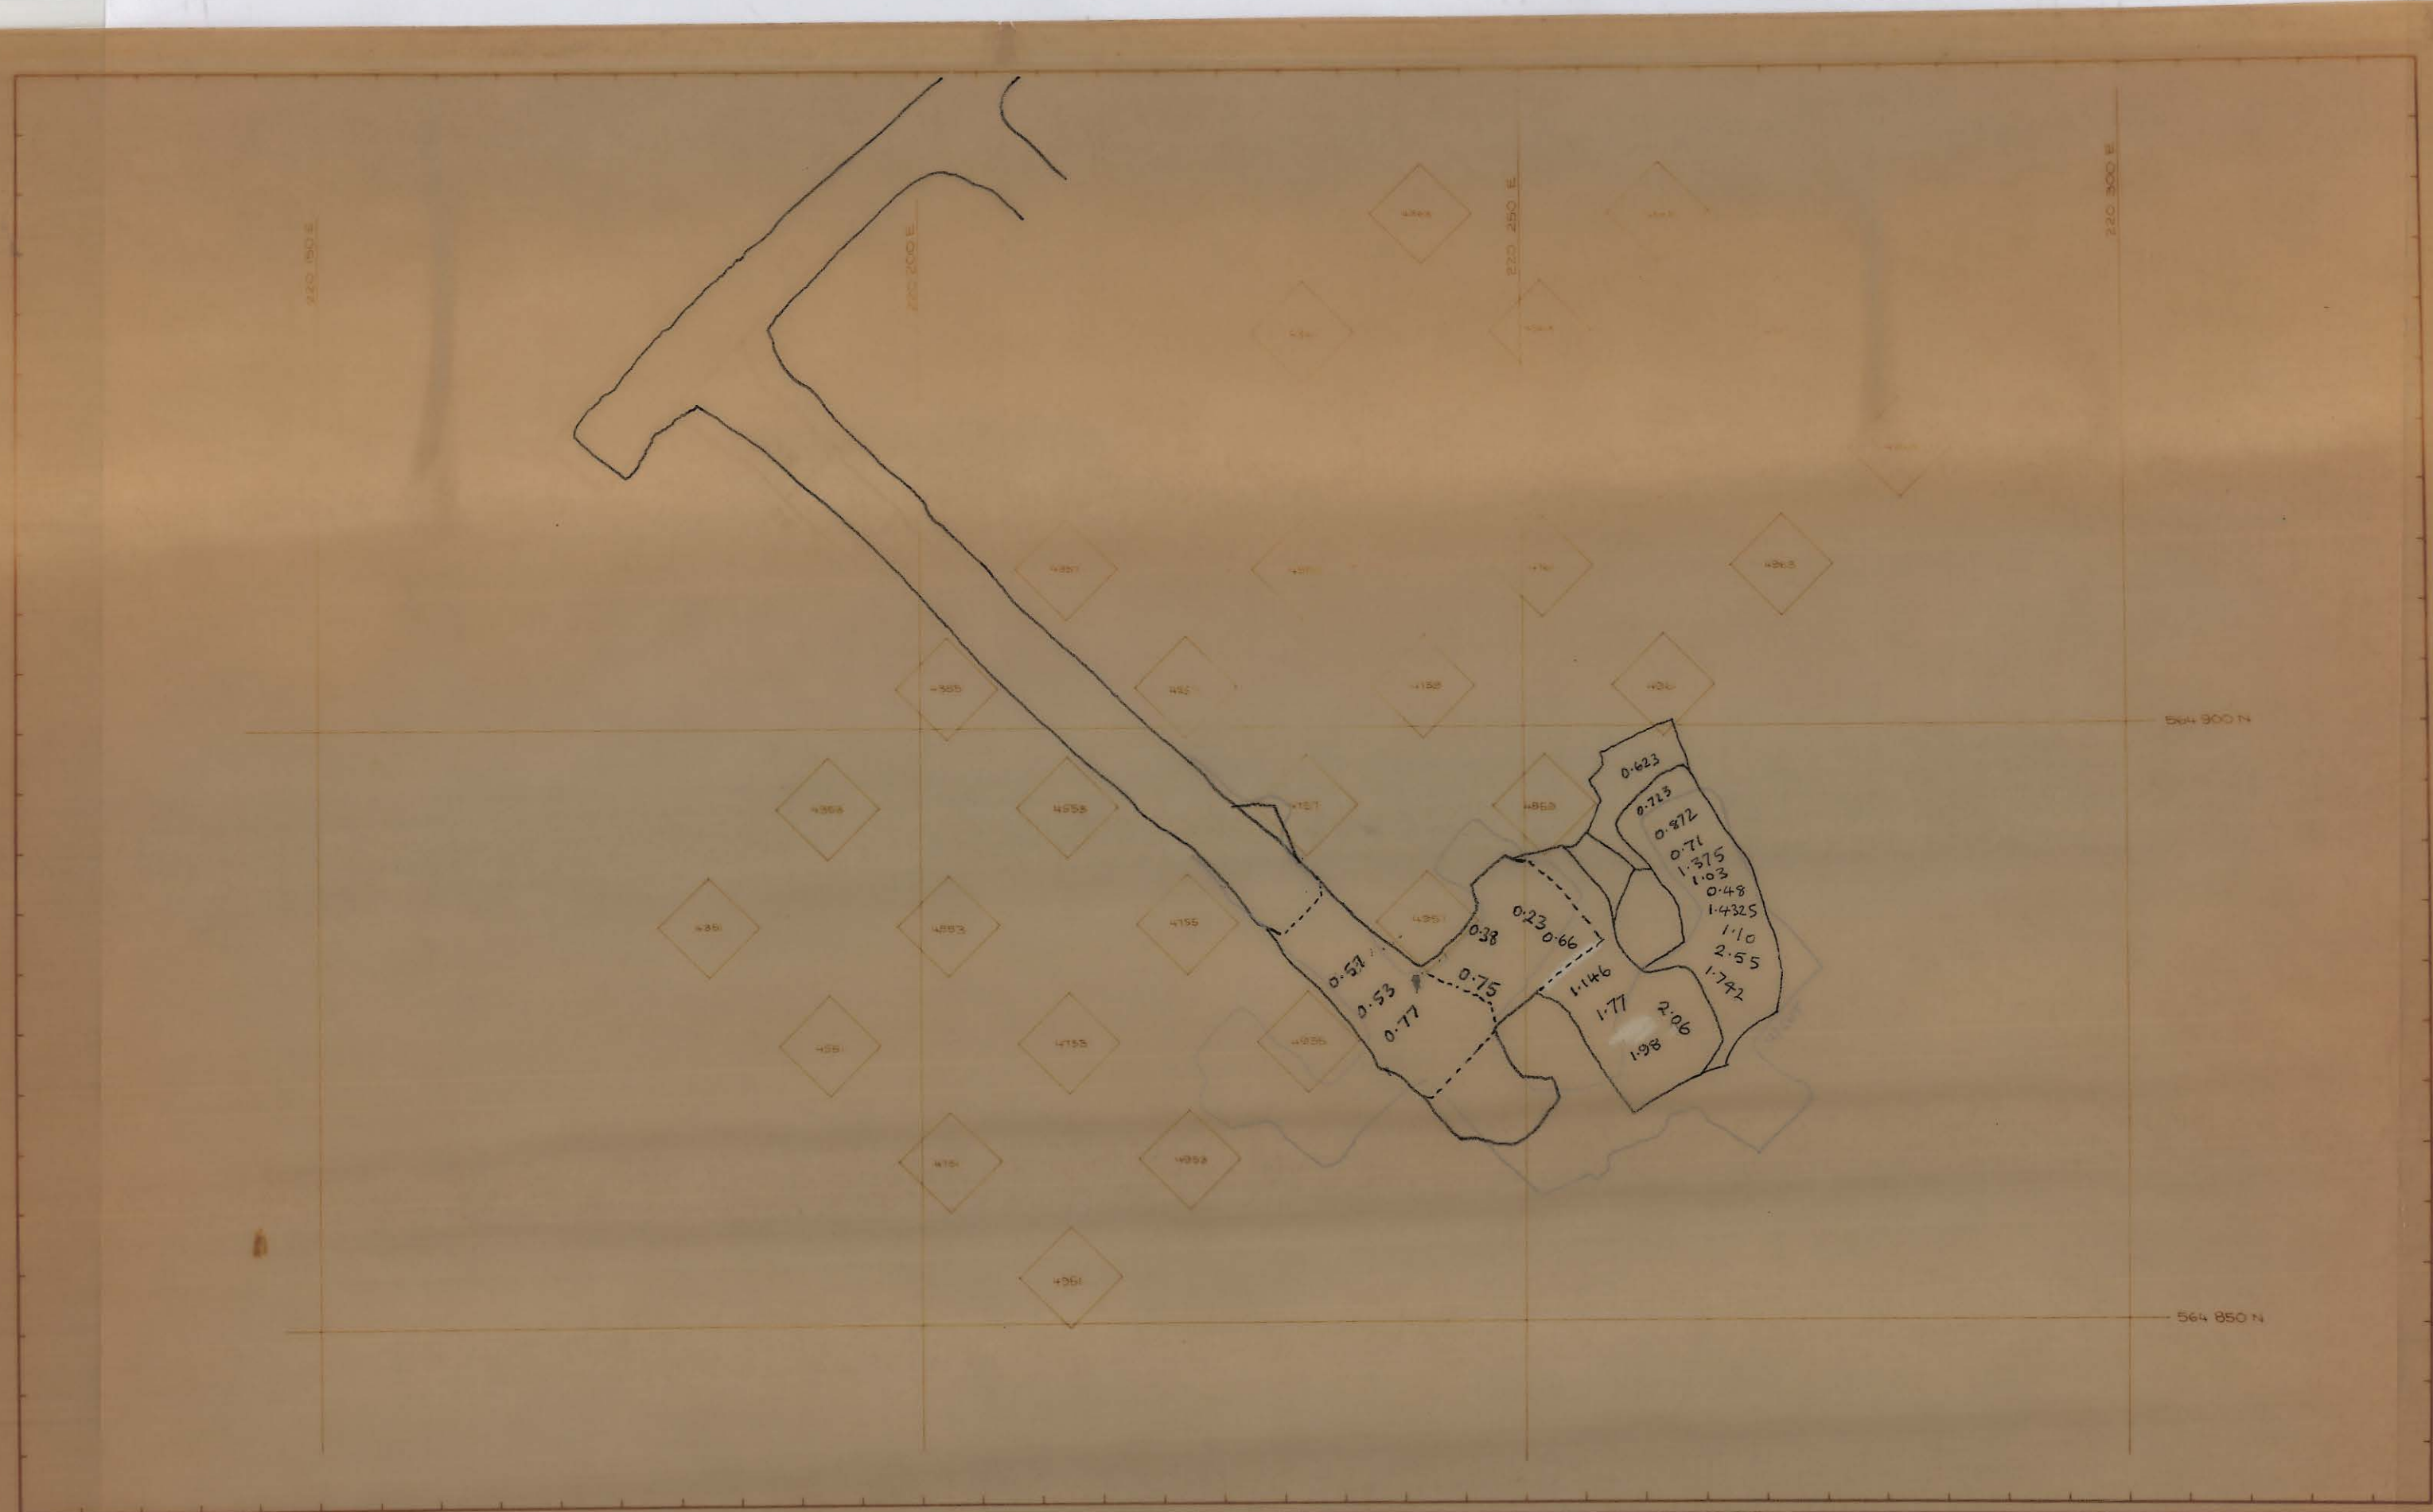

REF PLAN Back - 265.5 Floor - 270.0	GEOLOGY		SCALE 1: 500 KING ISLAND SCHEELITE GRASSY KING ISLAND
	SURVEY		
	PLANNING		
	ROCK MEC.		
	GRADE CON	ADKudg 1987	
	DRAFTING		
	T.S.S		
LOWER CENTRAL & SWAN (SOUTHERN) STOPES			
LIFT 01			
DRAWING NUMBER			