


0874_4704

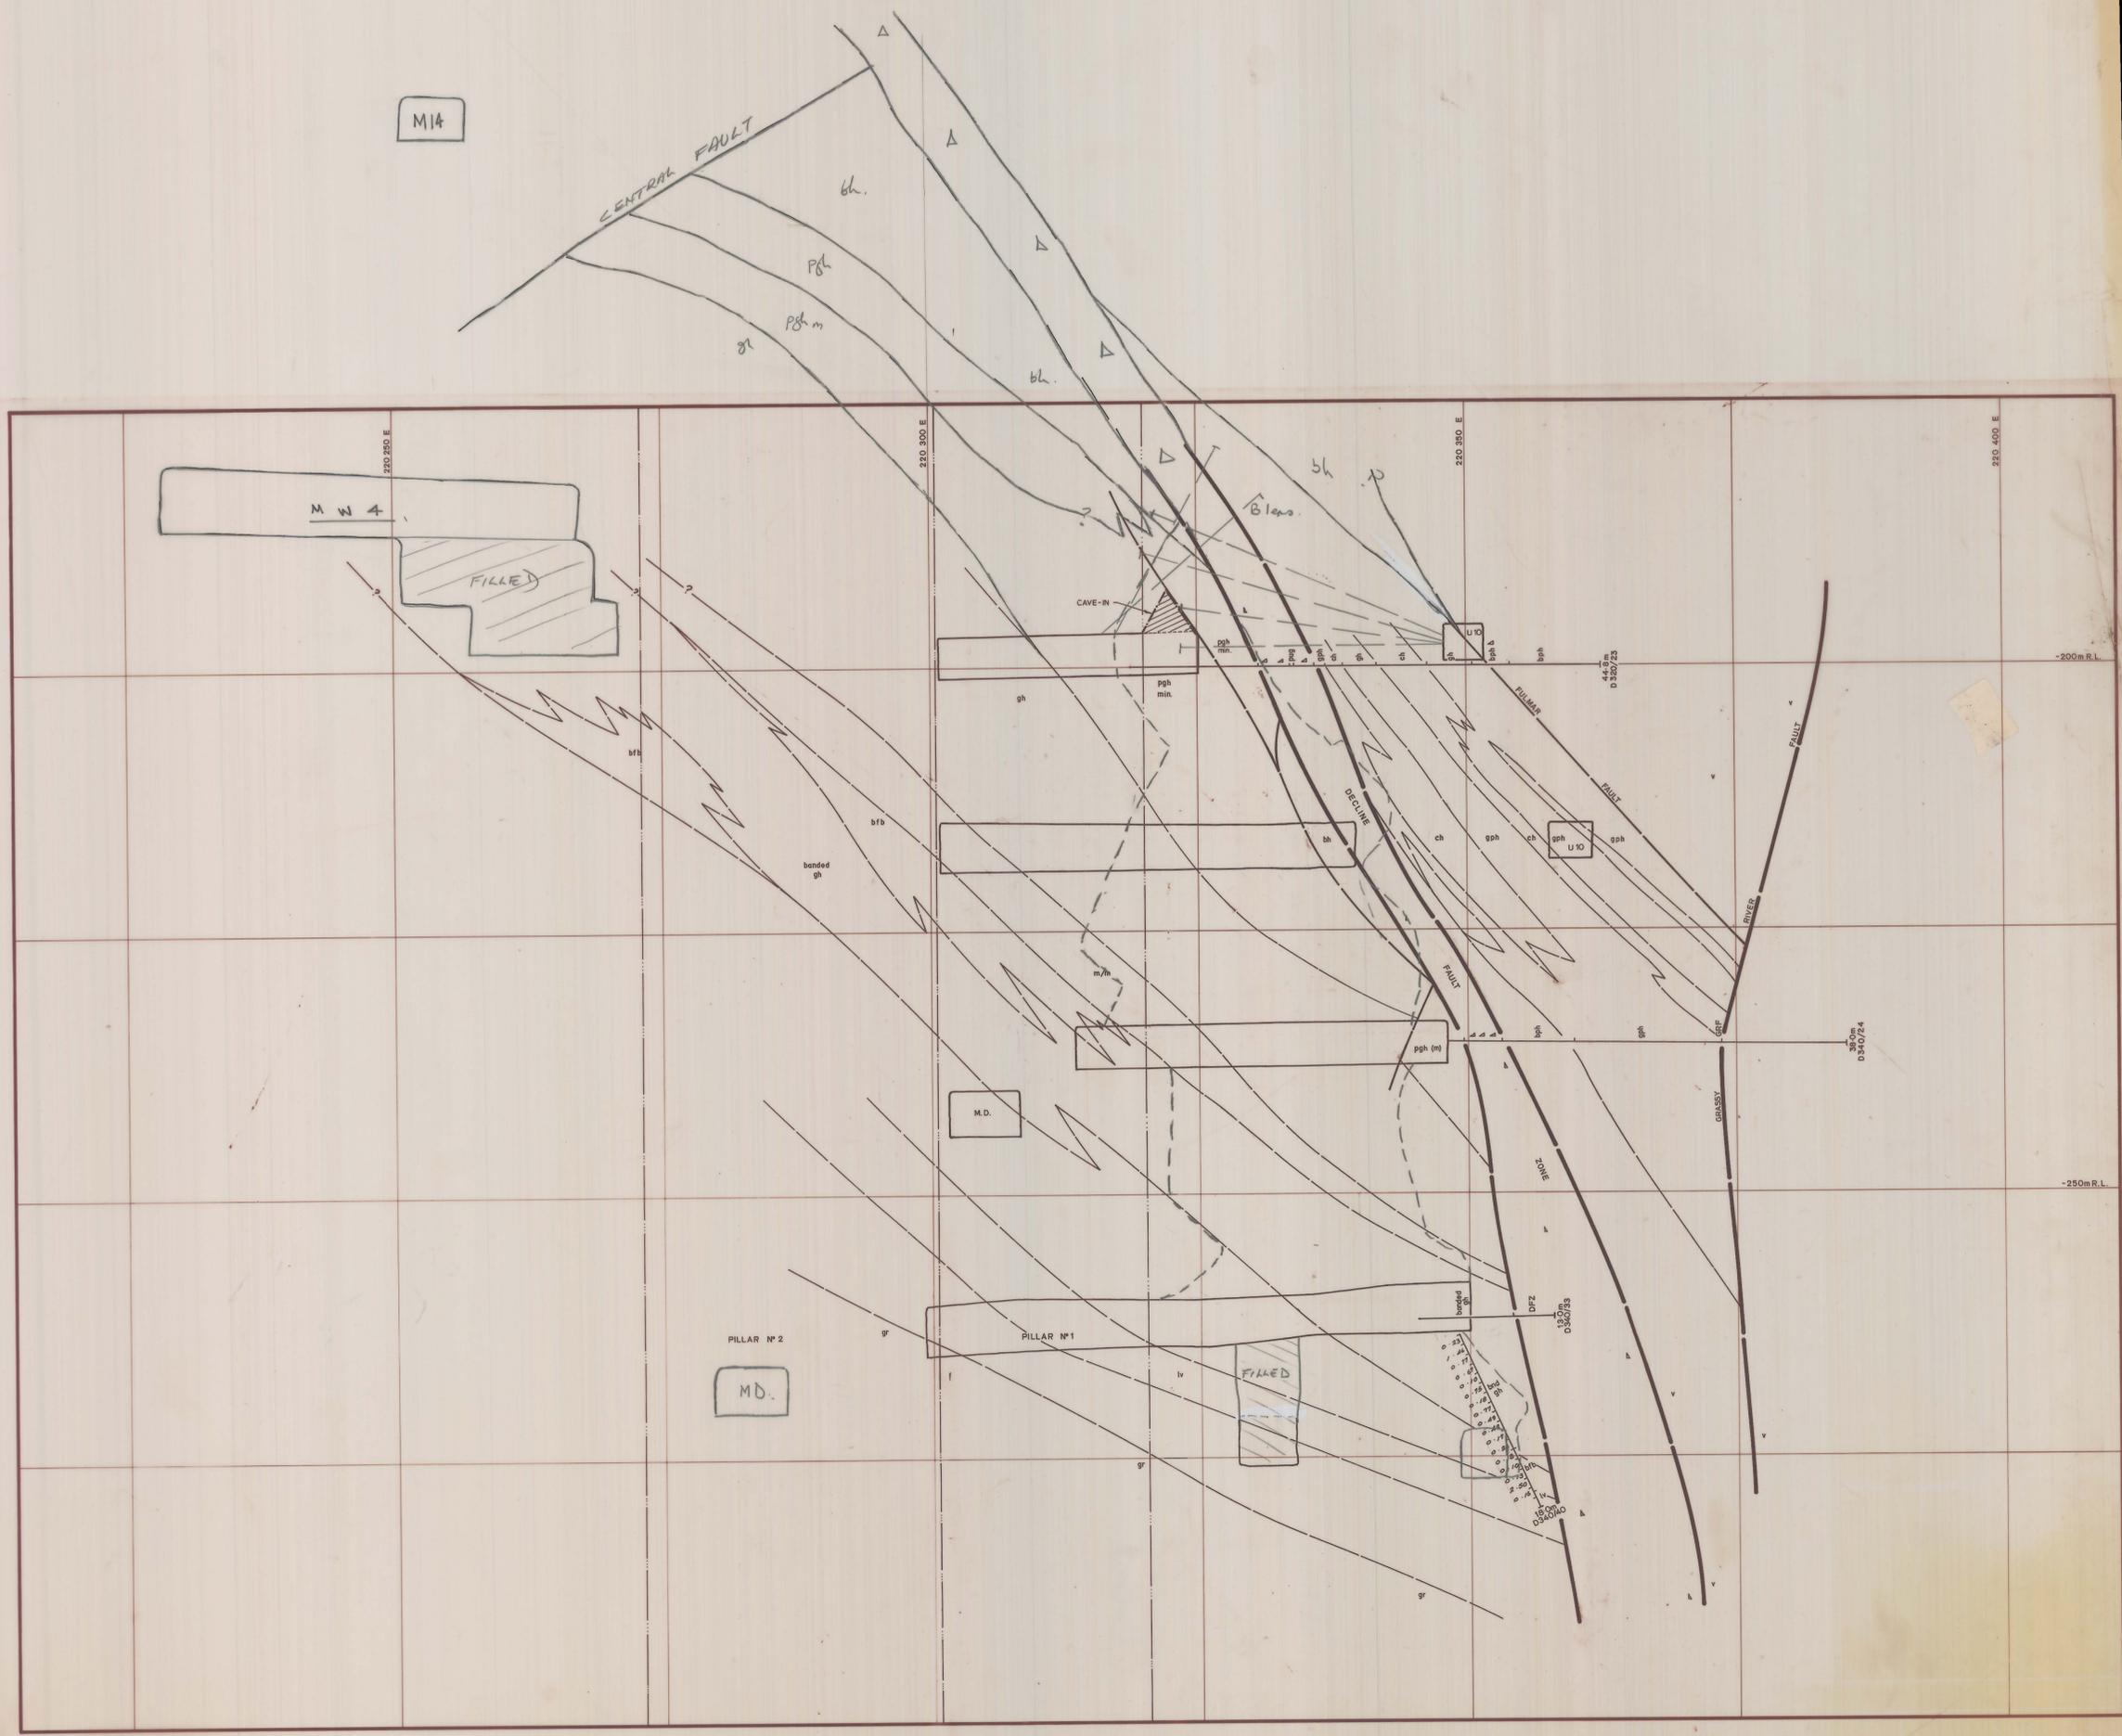

LEGEND v Upper metavolcanics bh/pn Banded hornfels ch Marble bh Biotite hornfels pgh Pyroxene garnet hornfels gh Garnet hornfels		bfb Banded footwall beds bph Biotite pyroxene hornfels lv Lower metavolcanics q Quartzite ap Aplite gr Granite	
---	--	---	--

GRID BEARING
 102°00'

SCALE 1:250

KING ISLAND SCHEELITE
 DWG. No. KG2-05-062
 DOLPHIN MINE
 LOWER WEDGE AREA
 W62 STOPE

DATE: 1-8-81
 DRAWN: R.S.D.
 RECHECKED: R.S.D.
 CHECKED: