



5 cm

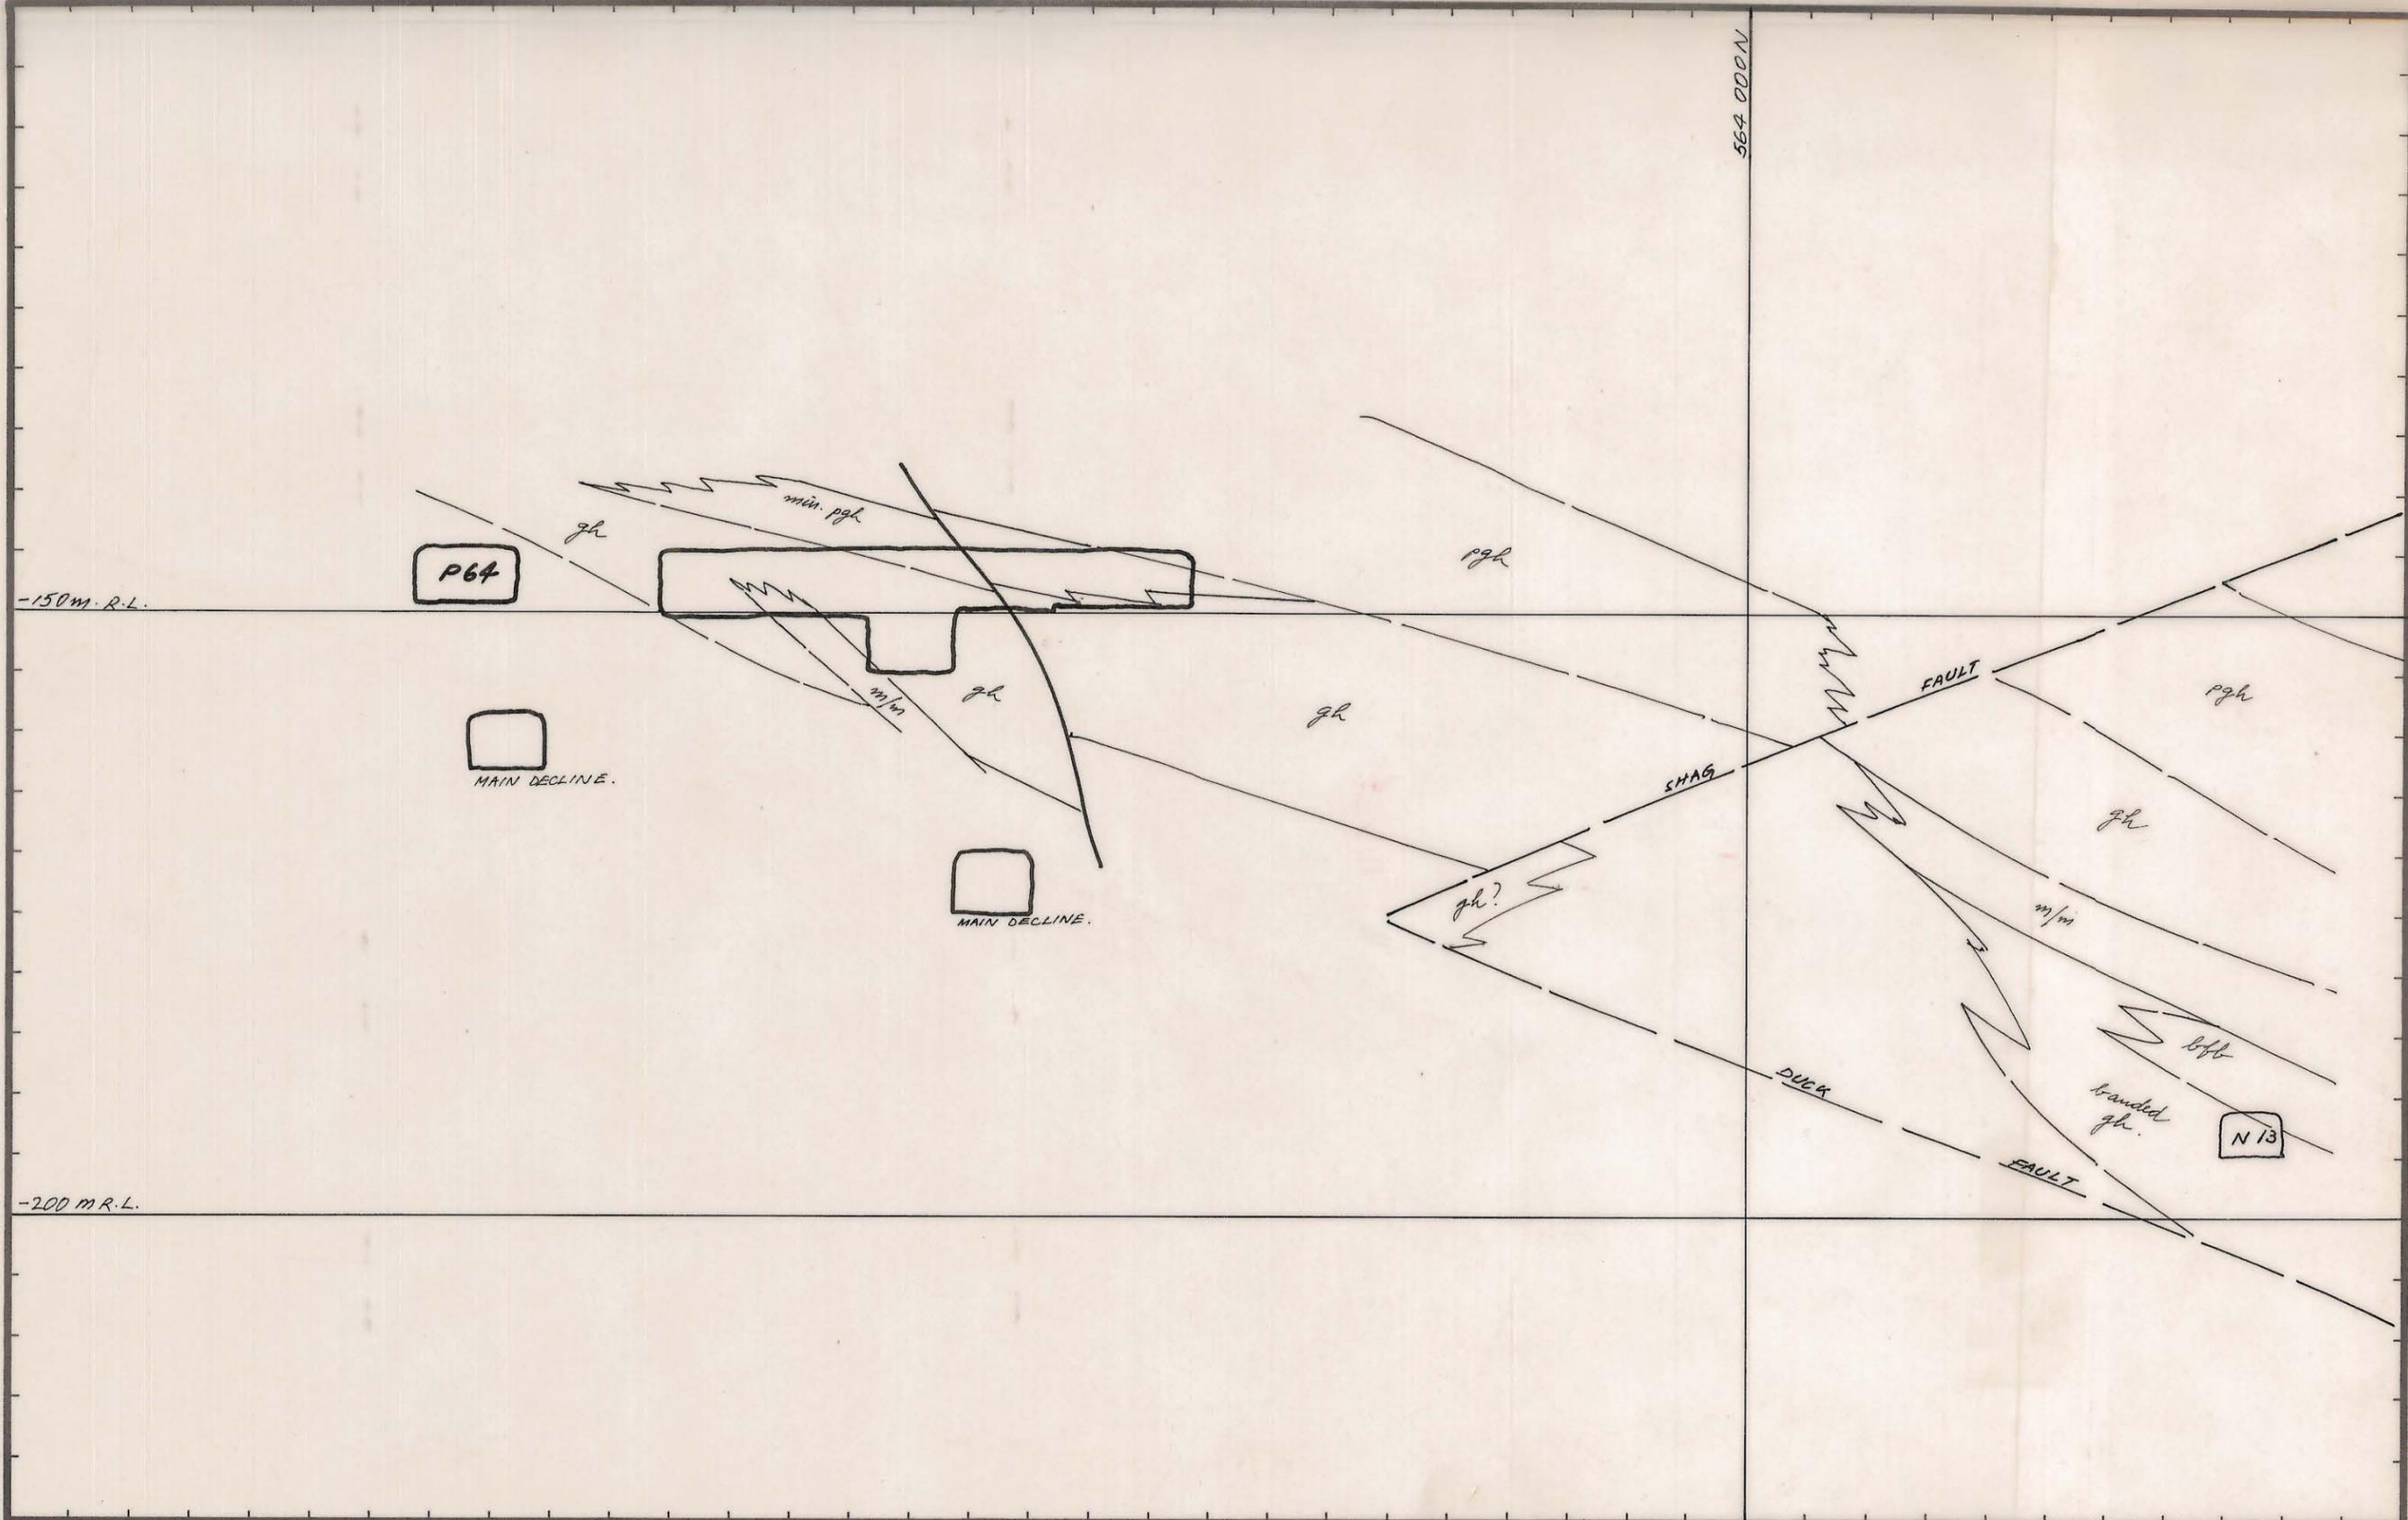

LEGEND:

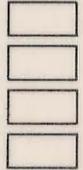

  
 DATE:  
 GEOL:  
 DWN:  
 CHKD:

GEOPEKO LIMITED  
 KING ISLAND  
 Scale: 1:500  
 No K  
**S 58 STOPE**