
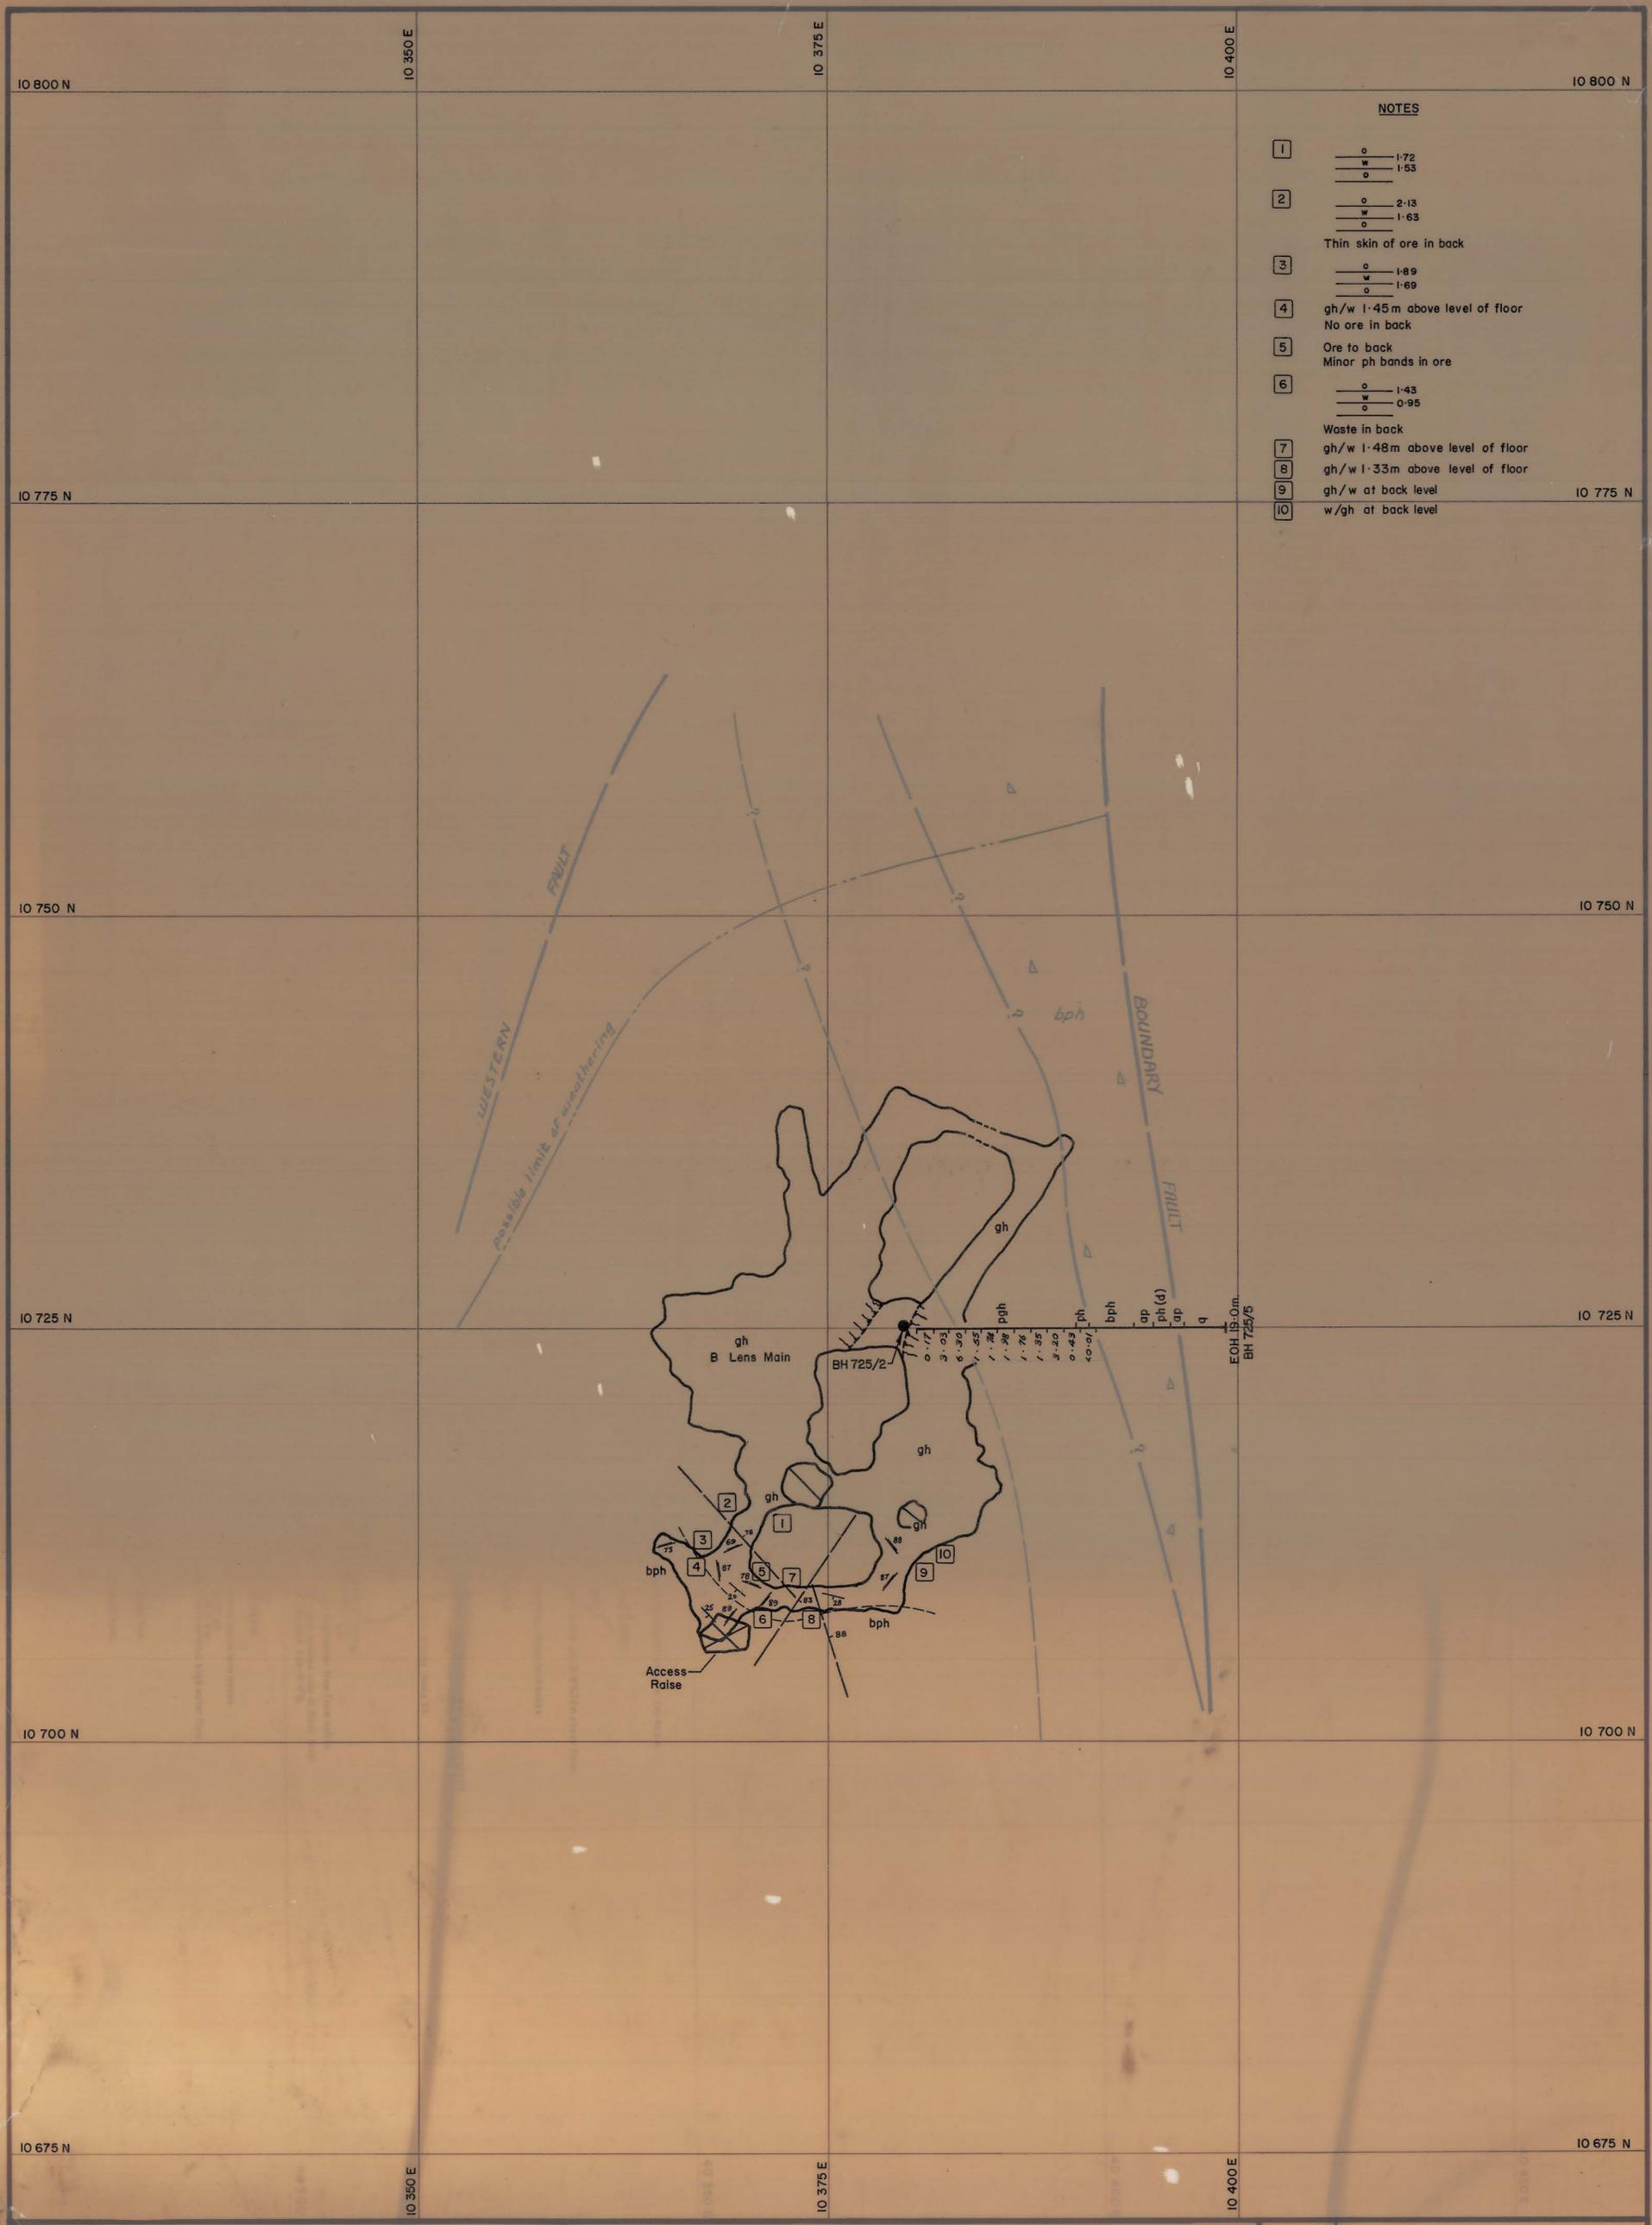


27 JUN 1981

KG3-262
Geological Floor
Plan
M71 STOPE
First Sub-Level
1:250

0374_4765

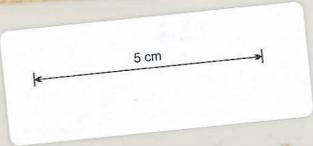

NOTES

- 1

o	1.72
w	1.53
o	
- 2

o	2.13
w	1.63
o	
- Thin skin of ore in back
- 3

o	1.89
w	1.69
o	
- 4 gh/w 1.45m above level of floor
No ore in back
- 5 Ore to back
Minor ph bands in ore
- 6

o	1.43
w	0.95
o	
- Waste in back
- 7 gh/w 1.48m above level of floor
- 8 gh/w 1.33m above level of floor
- 9 gh/w at back level
- 10 w/gh at back level

	GEOPEKO LIMITED KING ISLAND	
	Scale: 1:250	No. _____
	BOLD HEAD MINE	
	M71 STOPE First Sub - Level	
DATE: Oct 76		
GEOLOGIST: S.G.B.		
DRAWN: L.G.		
CHECKED: M.C.R.		