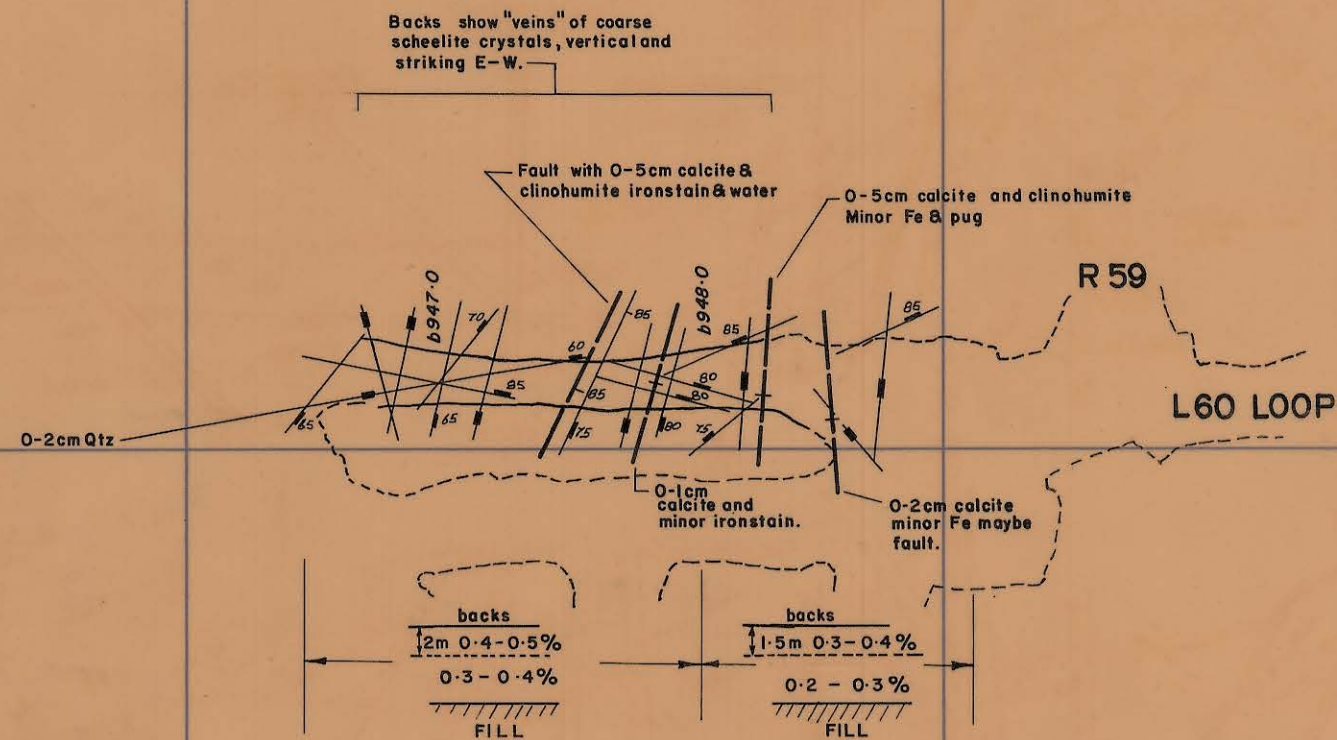
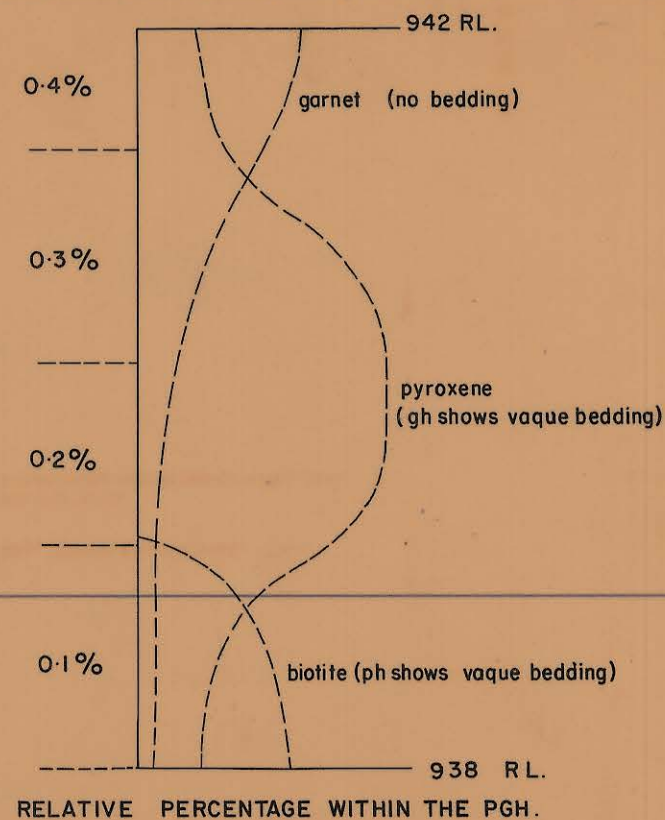


27 JUN 1981

C1 LENS
L 60 STOPE 1st Lift

0374_4772

5 cm

DIAGRAMATIC SECTION
OF NORTH WALL AT
40 365 E

Mapped 1.5m above fill.

REF. PLAN

GEOLOGY

SURVEY

PLANNING

ROCK MEC.

GRADE CON.

DRAFTING M.vdS.

T.S.S.

SCALE 1:500

KIS KING ISLAND SCHEELITE
GRASSY KING ISLANDBOLD HEAD MINE
C1 LENS
L60 STOPE 1st Lift

DRAWING NUMBER