


0374_4773

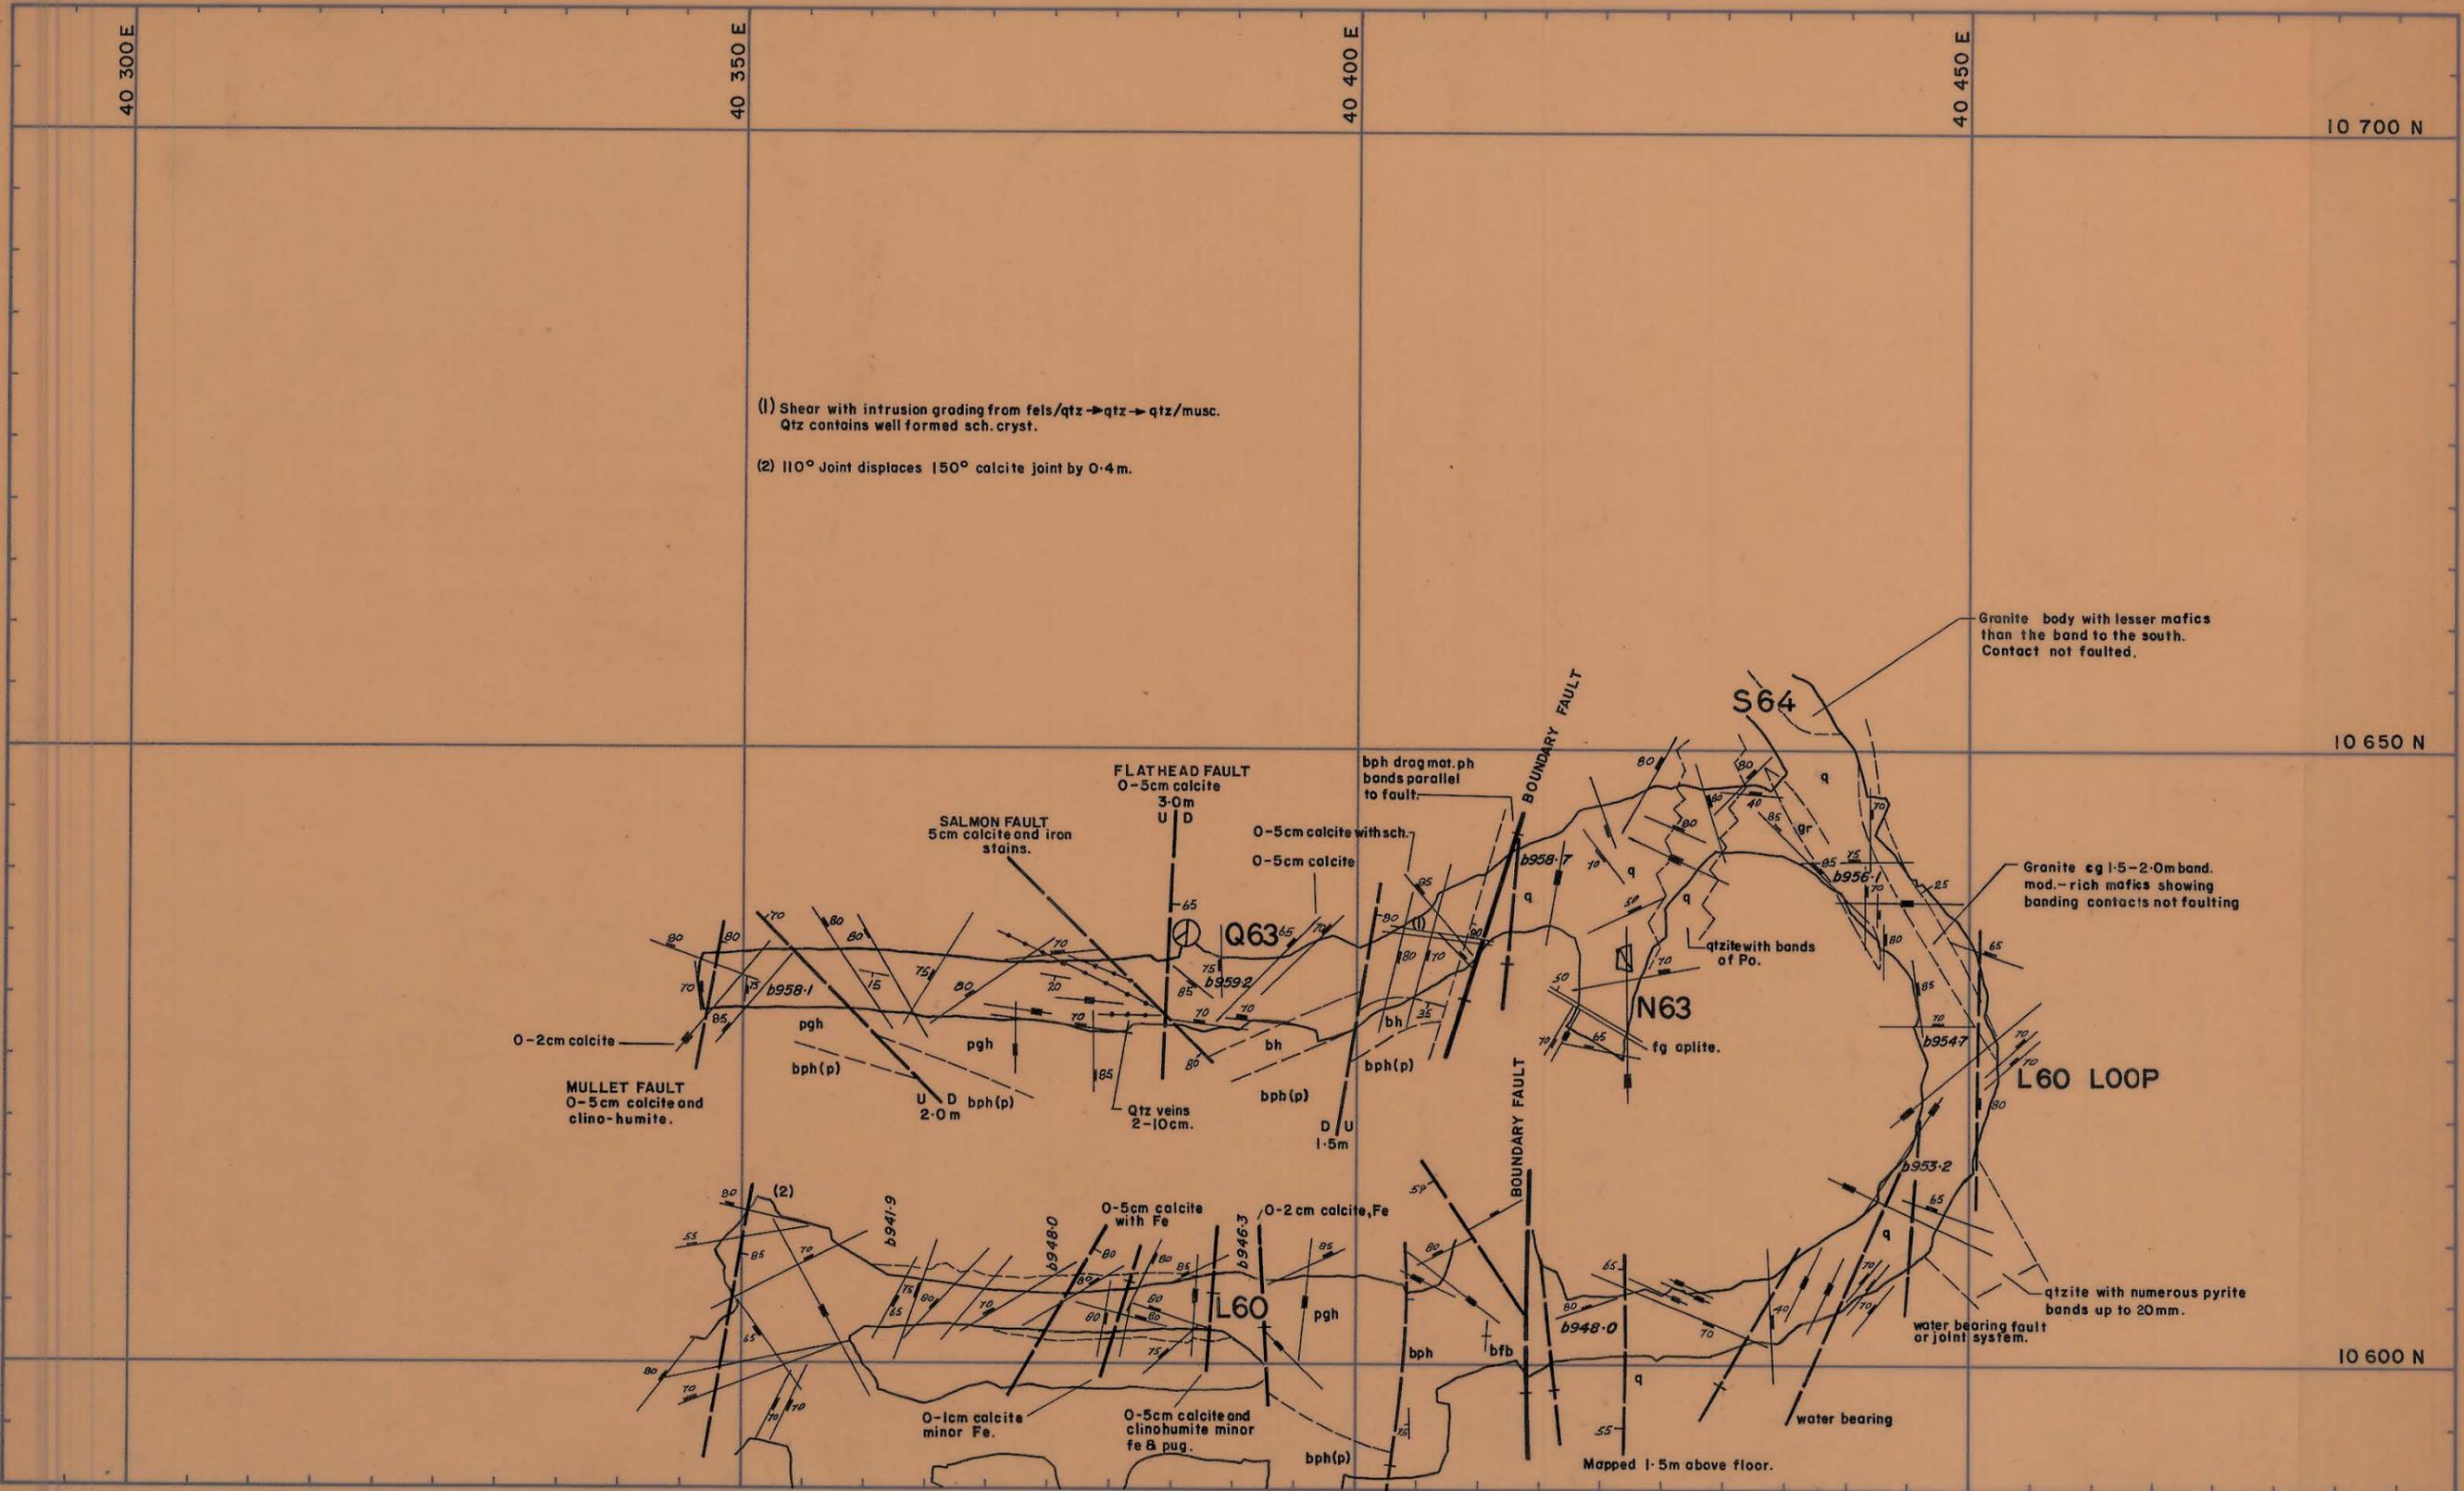

- (1) Shear with intrusion grading from fels/qtz → qtz → qtz/musc. Qtz contains well formed sch. cryst.
- (2) 110° Joint displaces 150° calcite joint by 0.4 m.

REF PLAN

5-10cm calcite
qtz, chlorite.

GEOLGY	<i>Terry P. Pollock</i>	Mar '81
SURVEY		
PLANNING		
ROCK MEC.		
GRADE CON.		
DRAFTING	M.vdS.	
T.S.S.		

SCALE 1:500



**BOLD HEAD MINE
C1 Lens
DEVELOPMENT DRIVES
L60, Q63, & L60 LOOP**