


Ci LENS
T47 1st Lift

0374_4778

5 cm

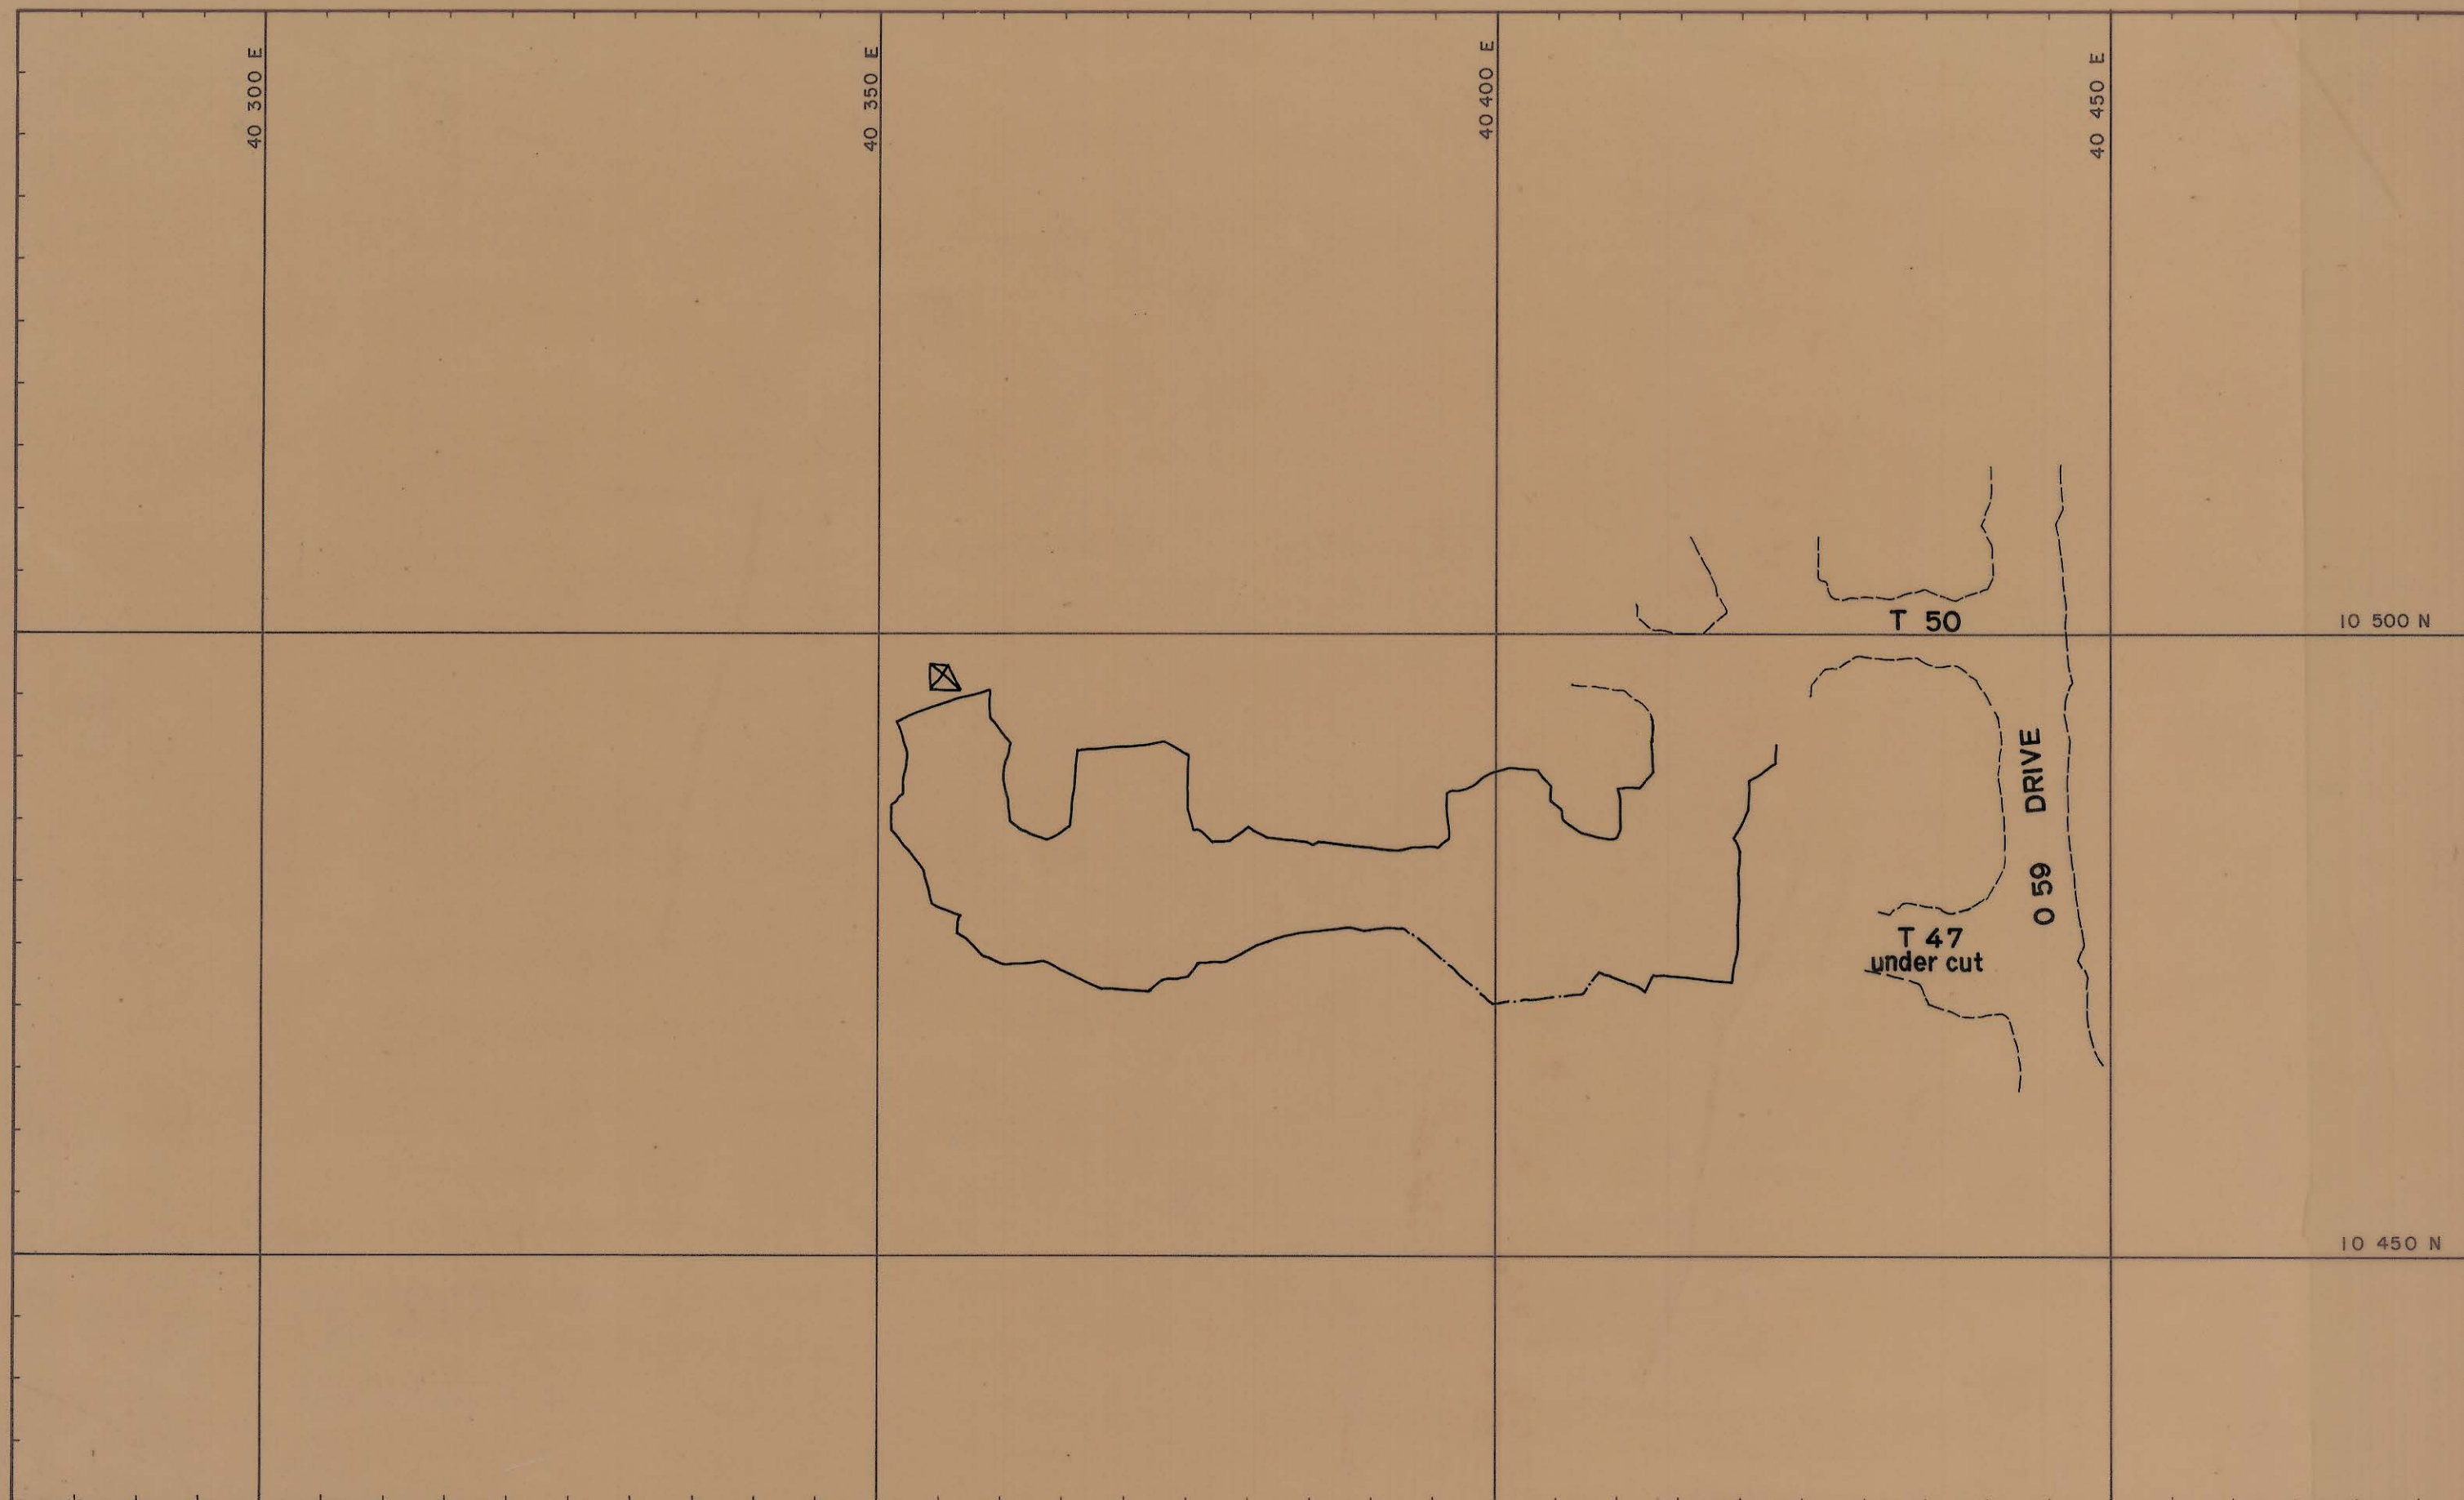

REF. PLAN

GEOLOGY

SURVEY

PLANNING

ROCK MEC.

GRADE CON.

DRAFTING

T.S.S.

SCALE 1:500

KIS KING ISLAND SCHEELITE
GRASSY KING ISLAND

BOLD HEAD MINE

Ci Lens
T47 STOPE - 1st Lift

DRAWING NUMBER