


27 JUN 1981

C II LENS
P53 STOPE 4th LIFT
R59 DRIVE

0374_4781

5 cm

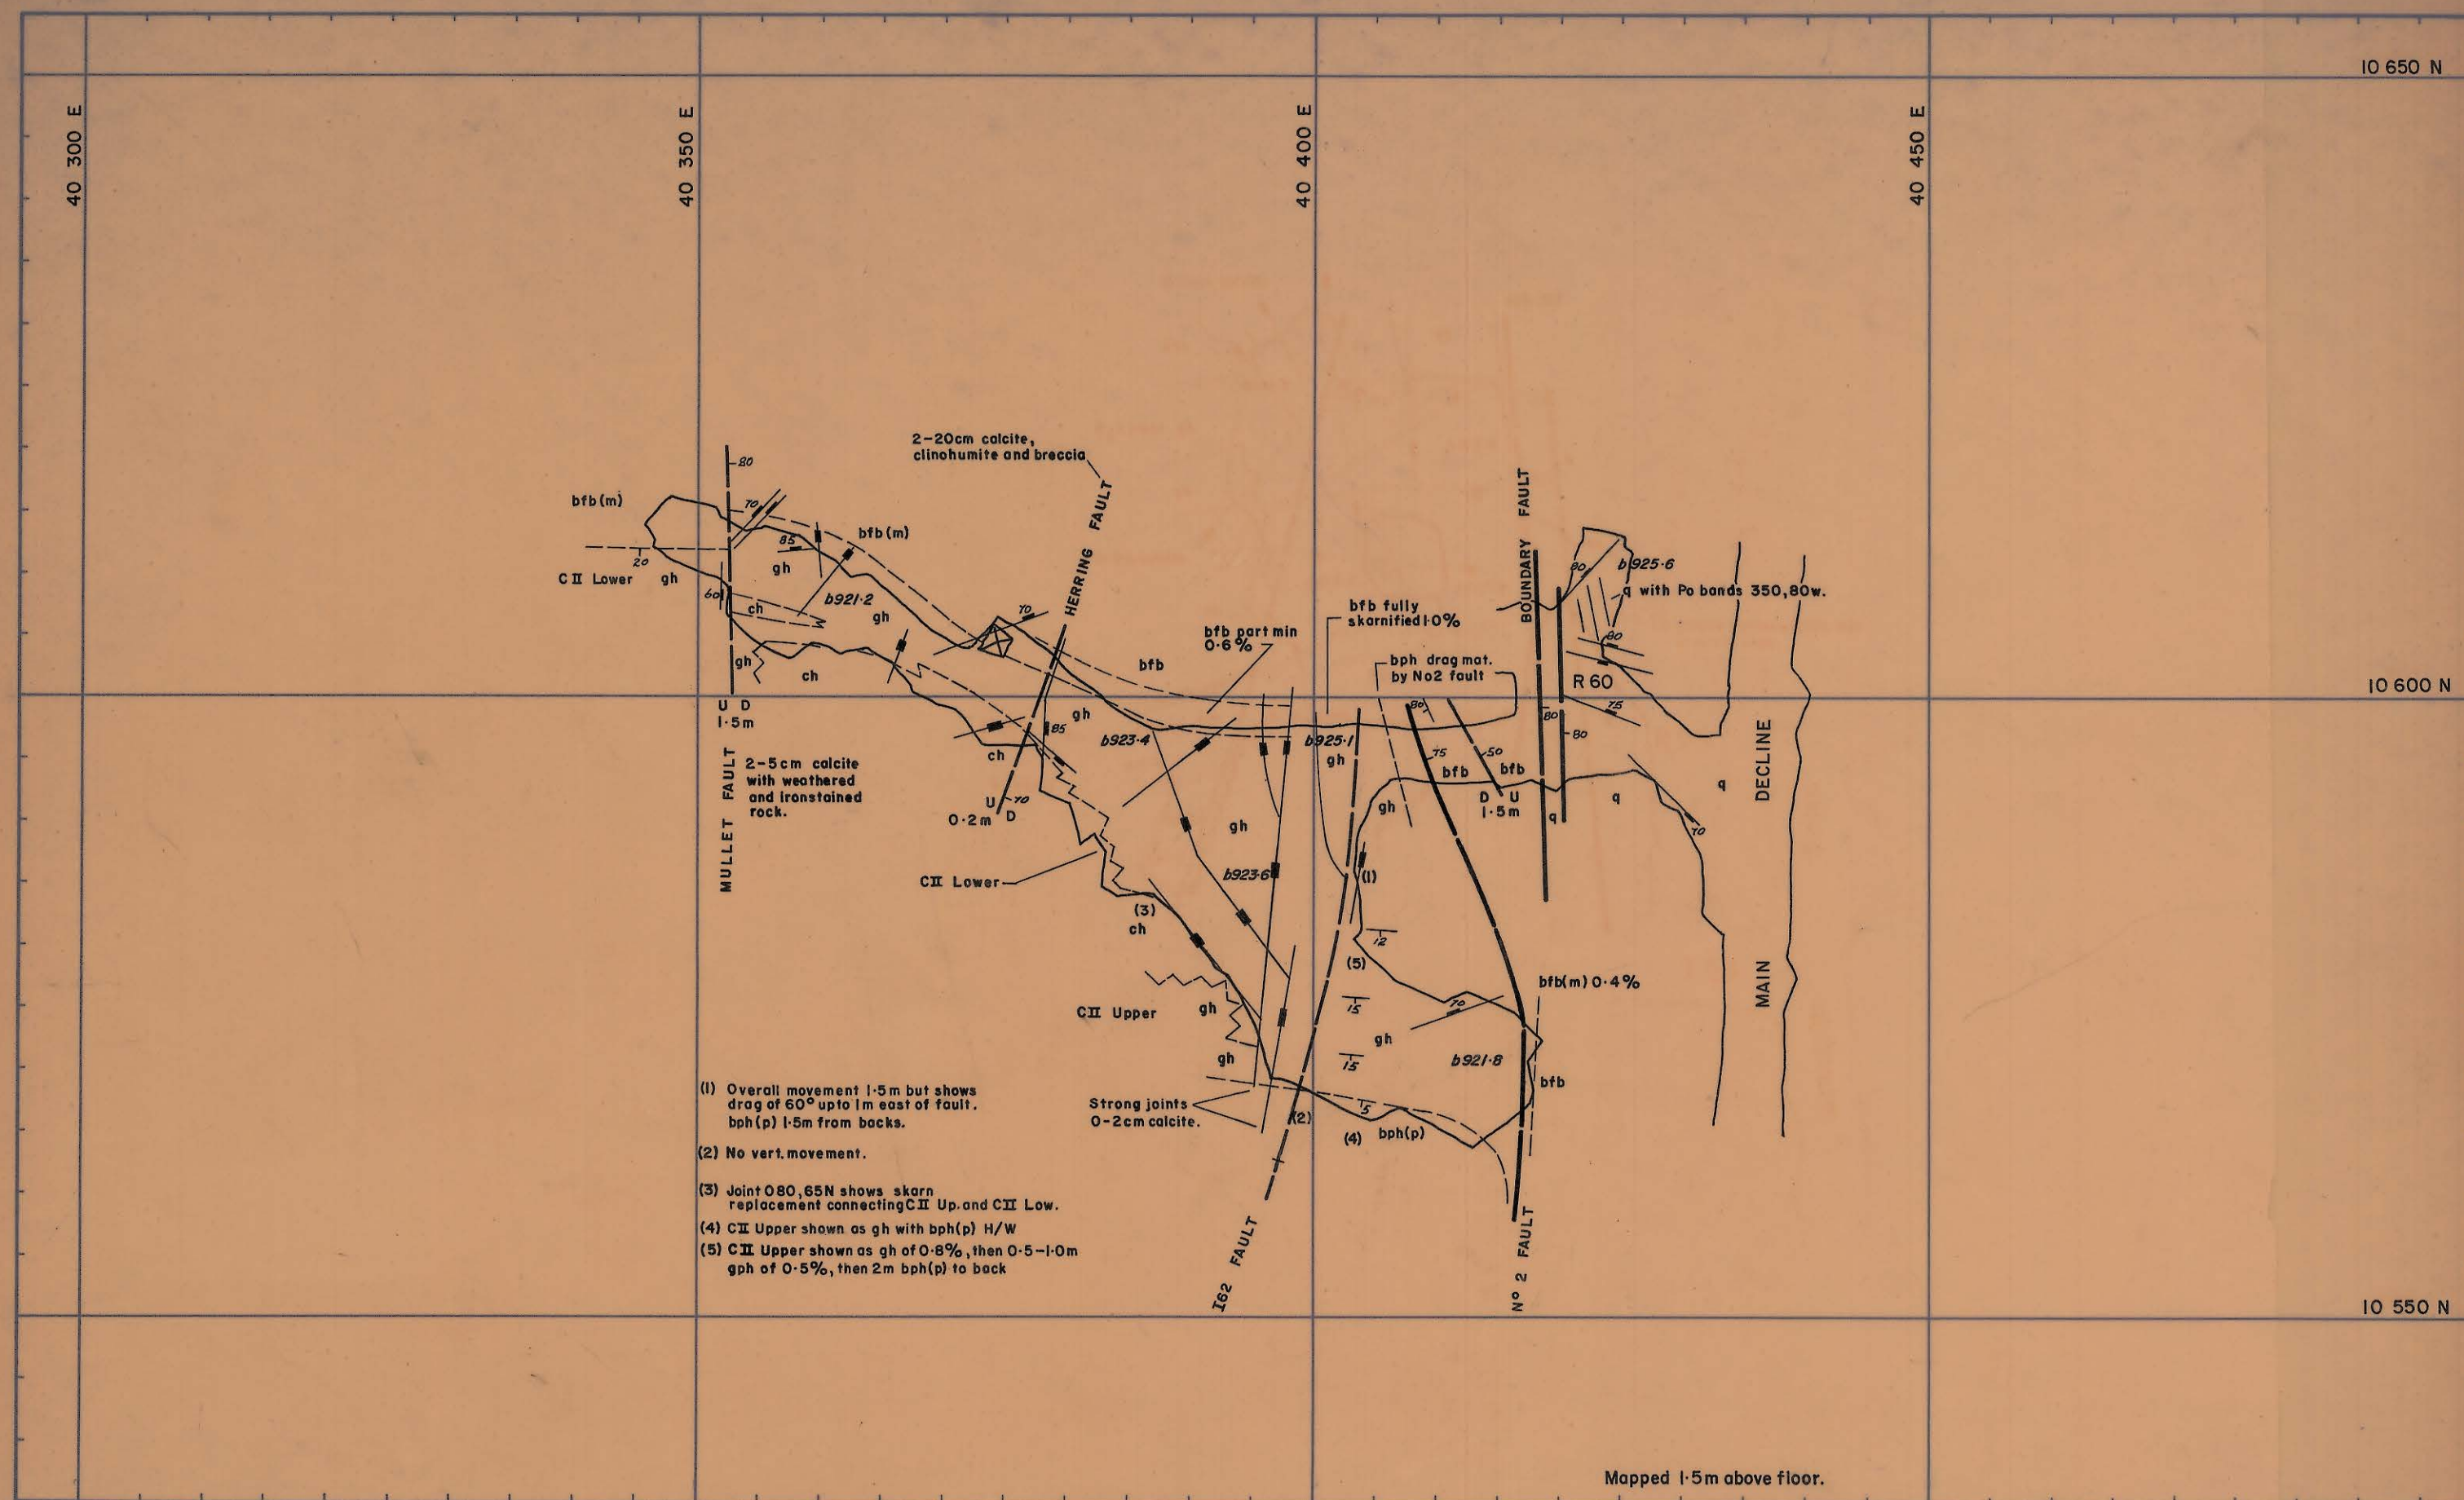

REF. PLAN

GEOLOGY	Terry J. Potter. MAR '81
SURVEY	
PLANNING	
ROCK MEC.	
GRADE CON.	
DRAFTING	M.vdS.
T.S.S.	

SCALE 1:500

KIS KING ISLAND SCHEELITE
GRASSY KING ISLAND

BOLD HEAD MINE
C II LENS
P53 STOPE 4th Lift & R59 DRIVE

DRAWING NUMBER