


5 cm

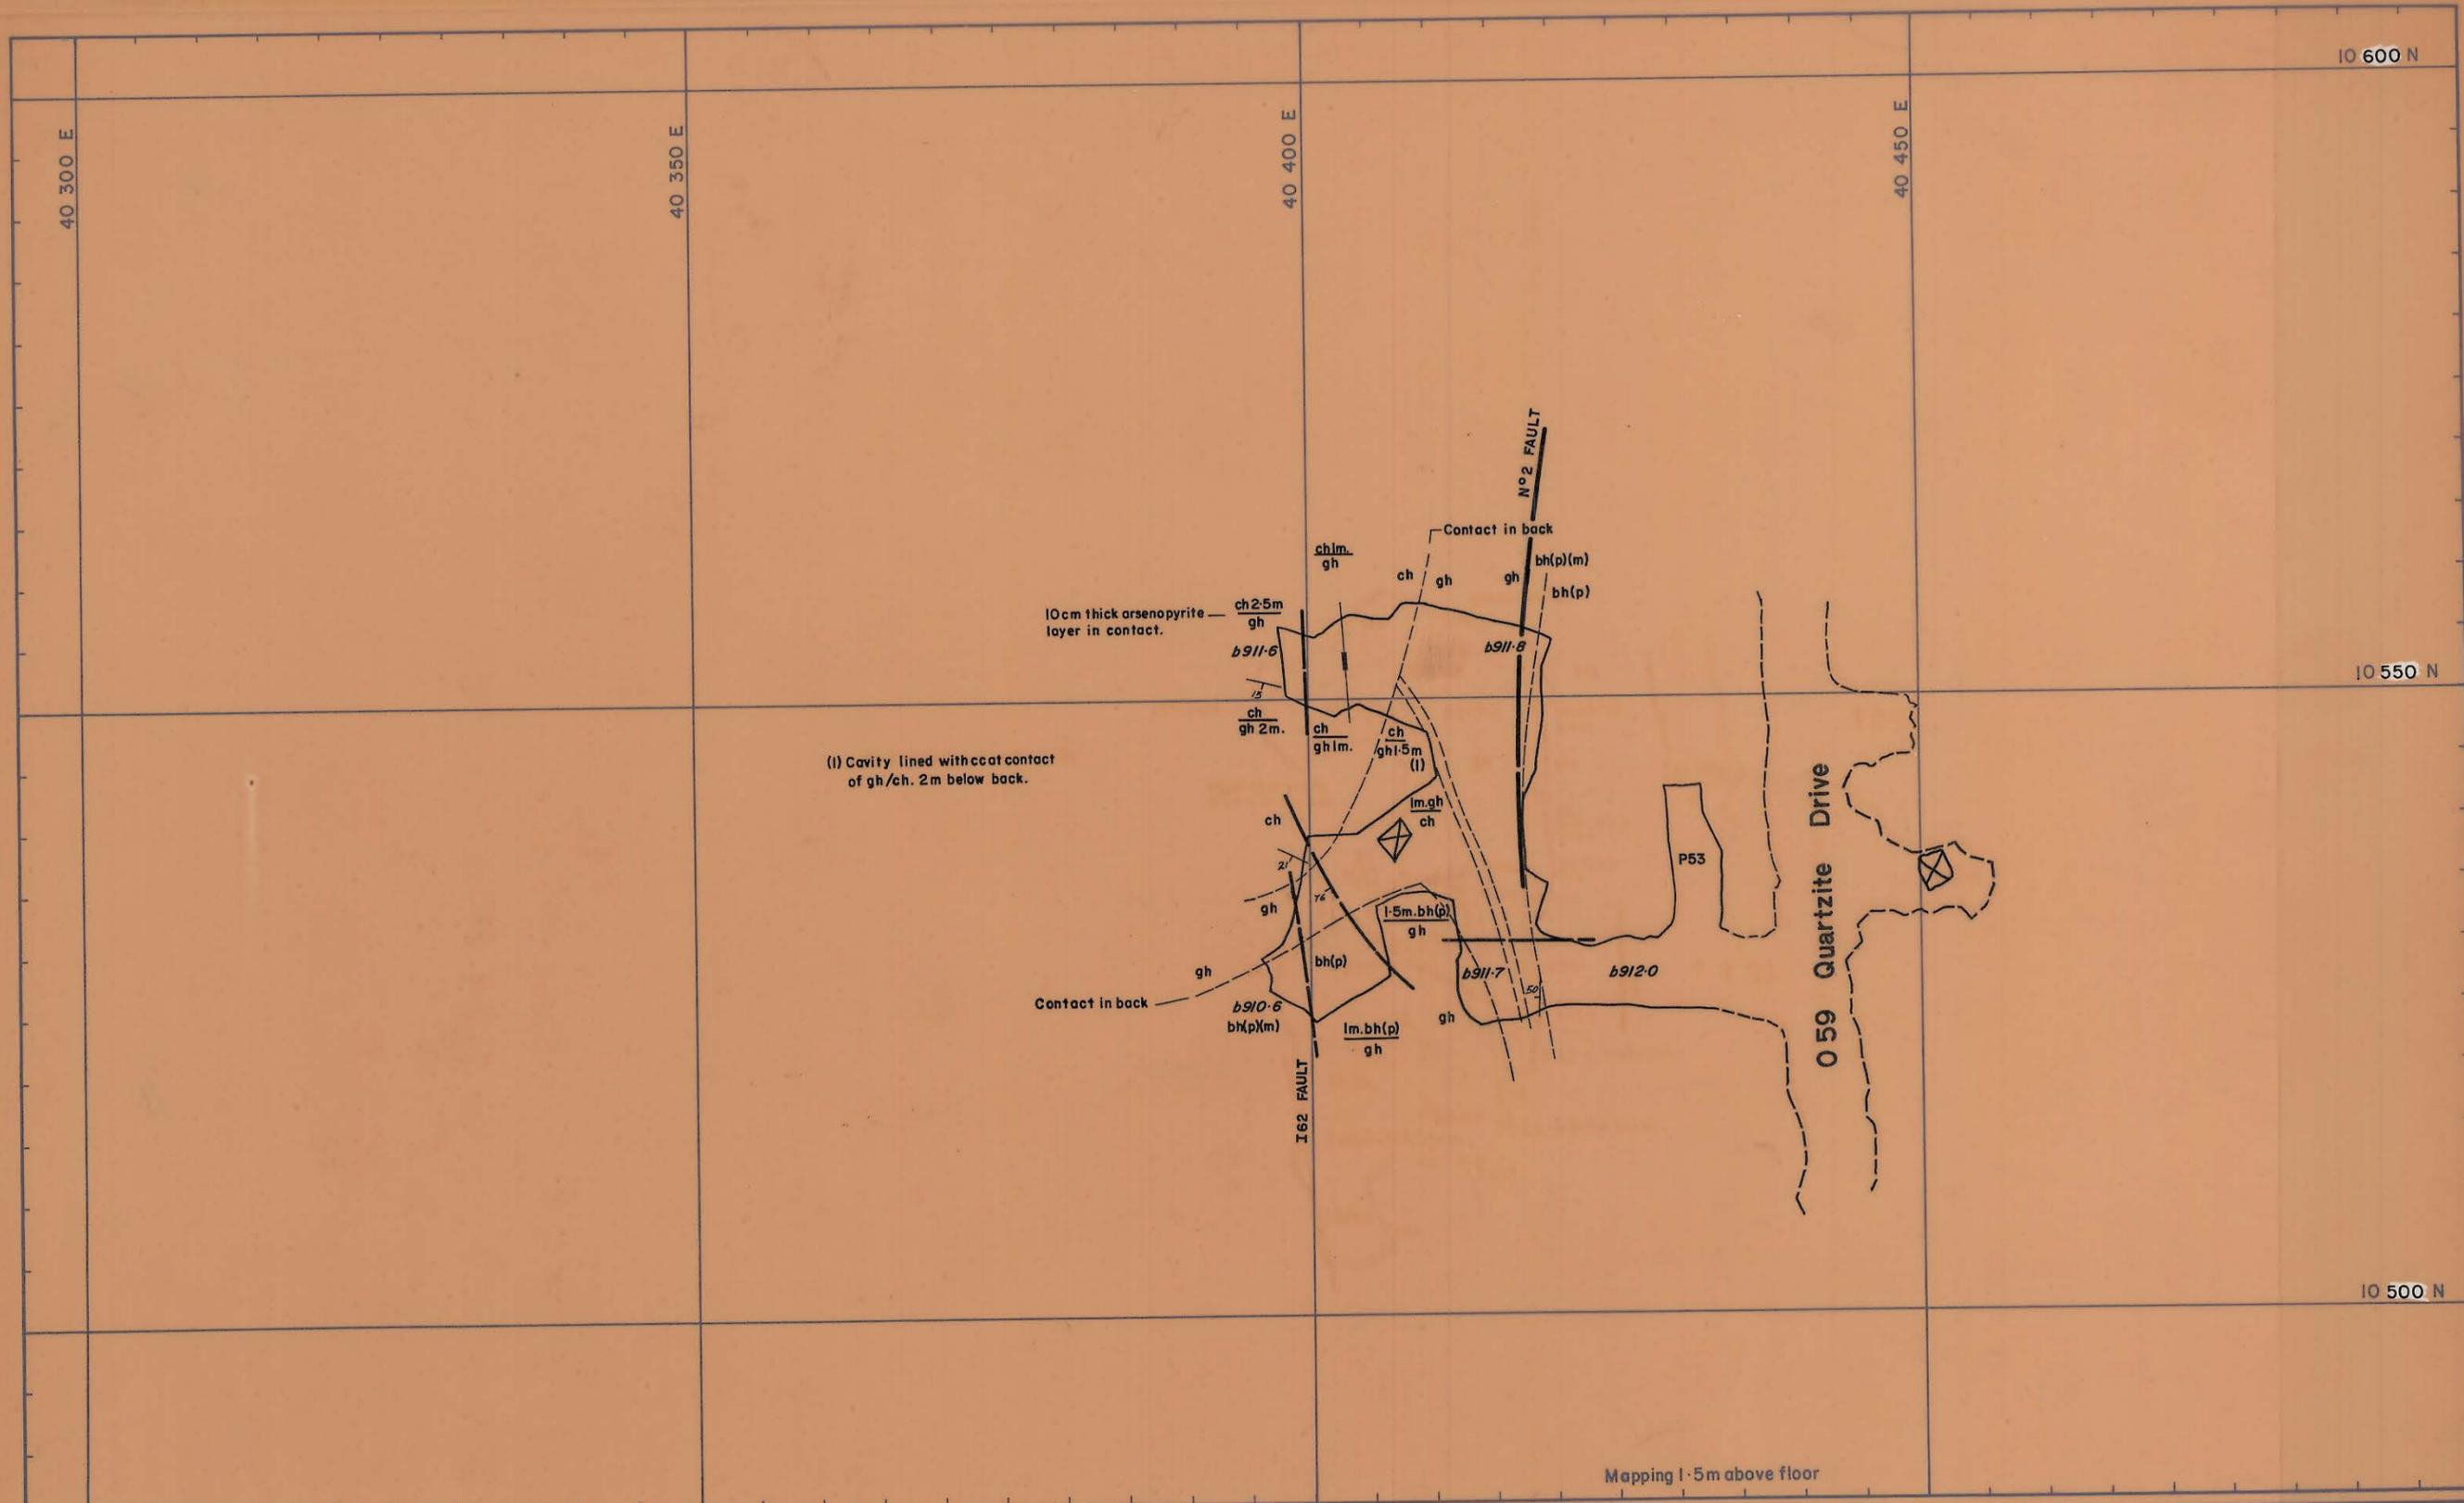

REF. PLAN

NOTE

eg. ch means ch/gh contact is 1.5m above floor.  
gh 1.5m  
ch 1.5m means ch/gh contact is 1.5m below back.  
gh

GEOLOGY R.E.S-D

SURVEY	
PLANNING	
ROCK MEC.	
GRADE CON	
DRAFTING	M.vdS.
T.S.S.	

SCALE 1:500

KIS KING ISLAND SCHEELITE  
GRASSY KING ISLAND

BOLD HEAD MINE

C II LENS  
P53 1st lift

DRAWING NUMBER