


27 JUN 1981

CII LENS
P53 UNDER CUT

0374_4785

5 cm

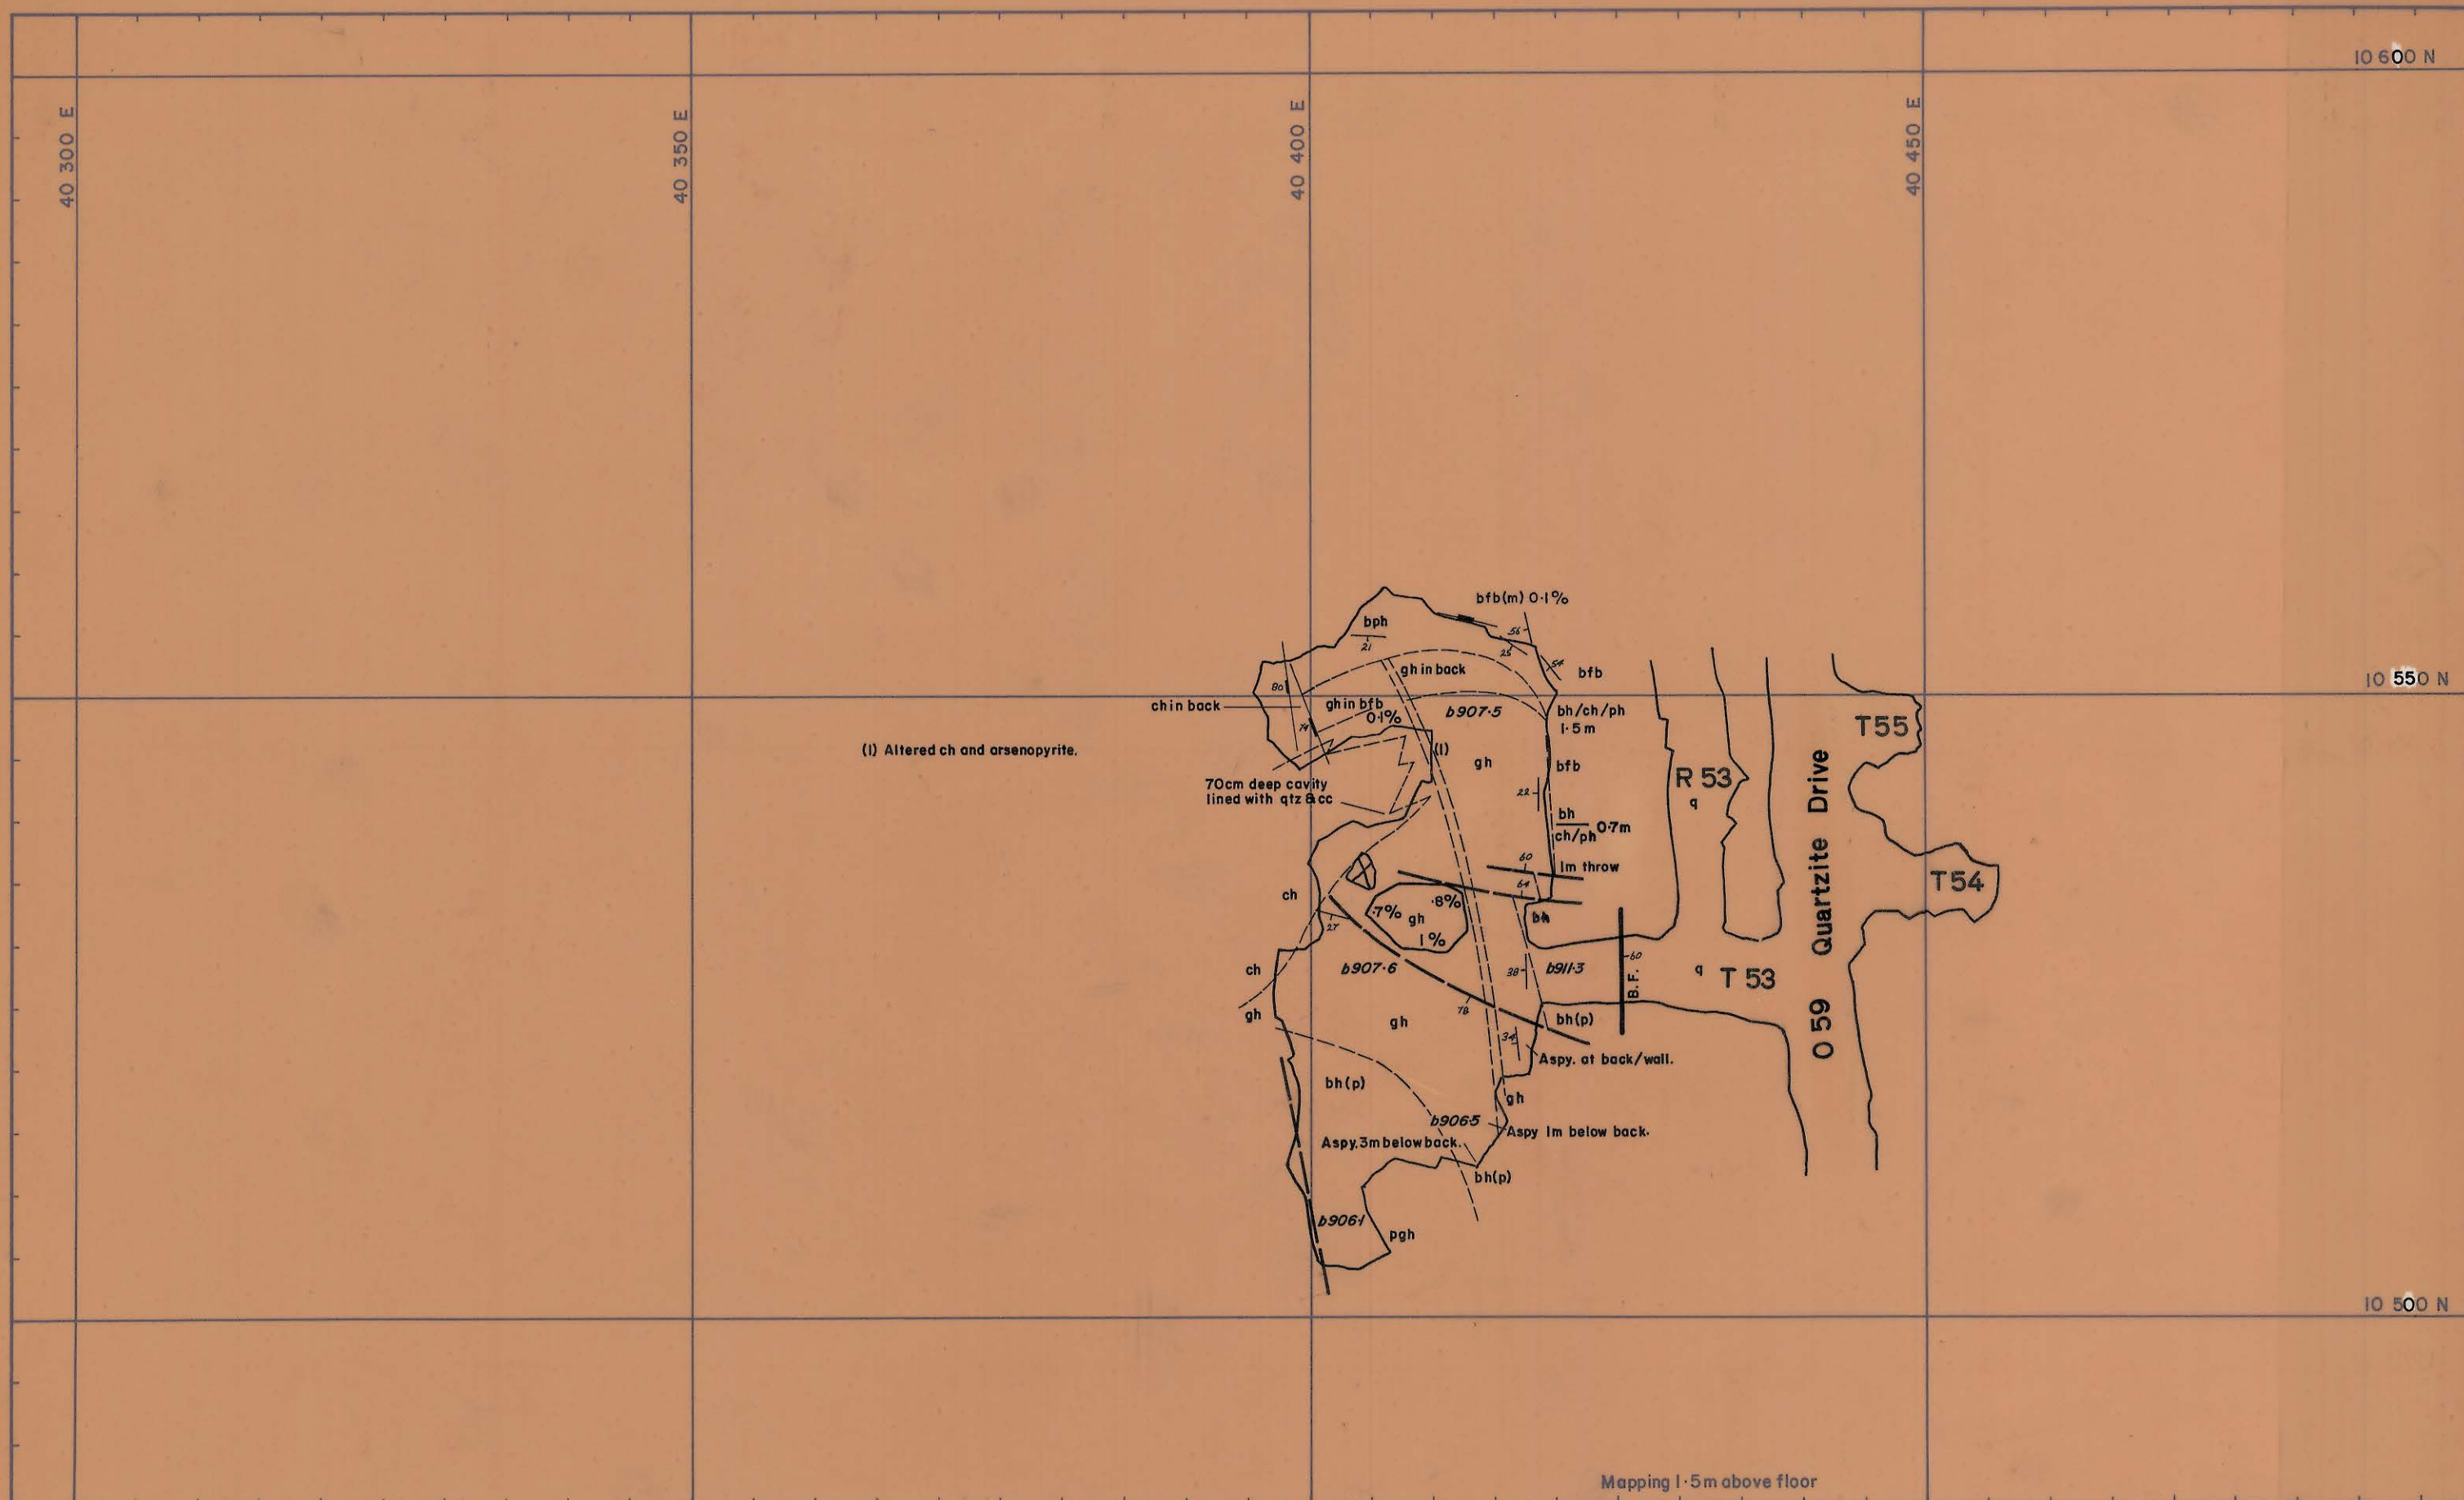

REF. PLAN

GEOLOGY

R.E.S-D

SURVEY

PLANNING

ROCK MEC.

GRADE CON.

DRAFTING

M.vdS.

T.S.S.

SCALE 1:500

KES KING ISLAND SCHEELITE
GRASSY KING ISLAND

BOLD HEAD MINE

CII LENS

P 53 Under Cut

DRAWING NUMBER