


0374_4788

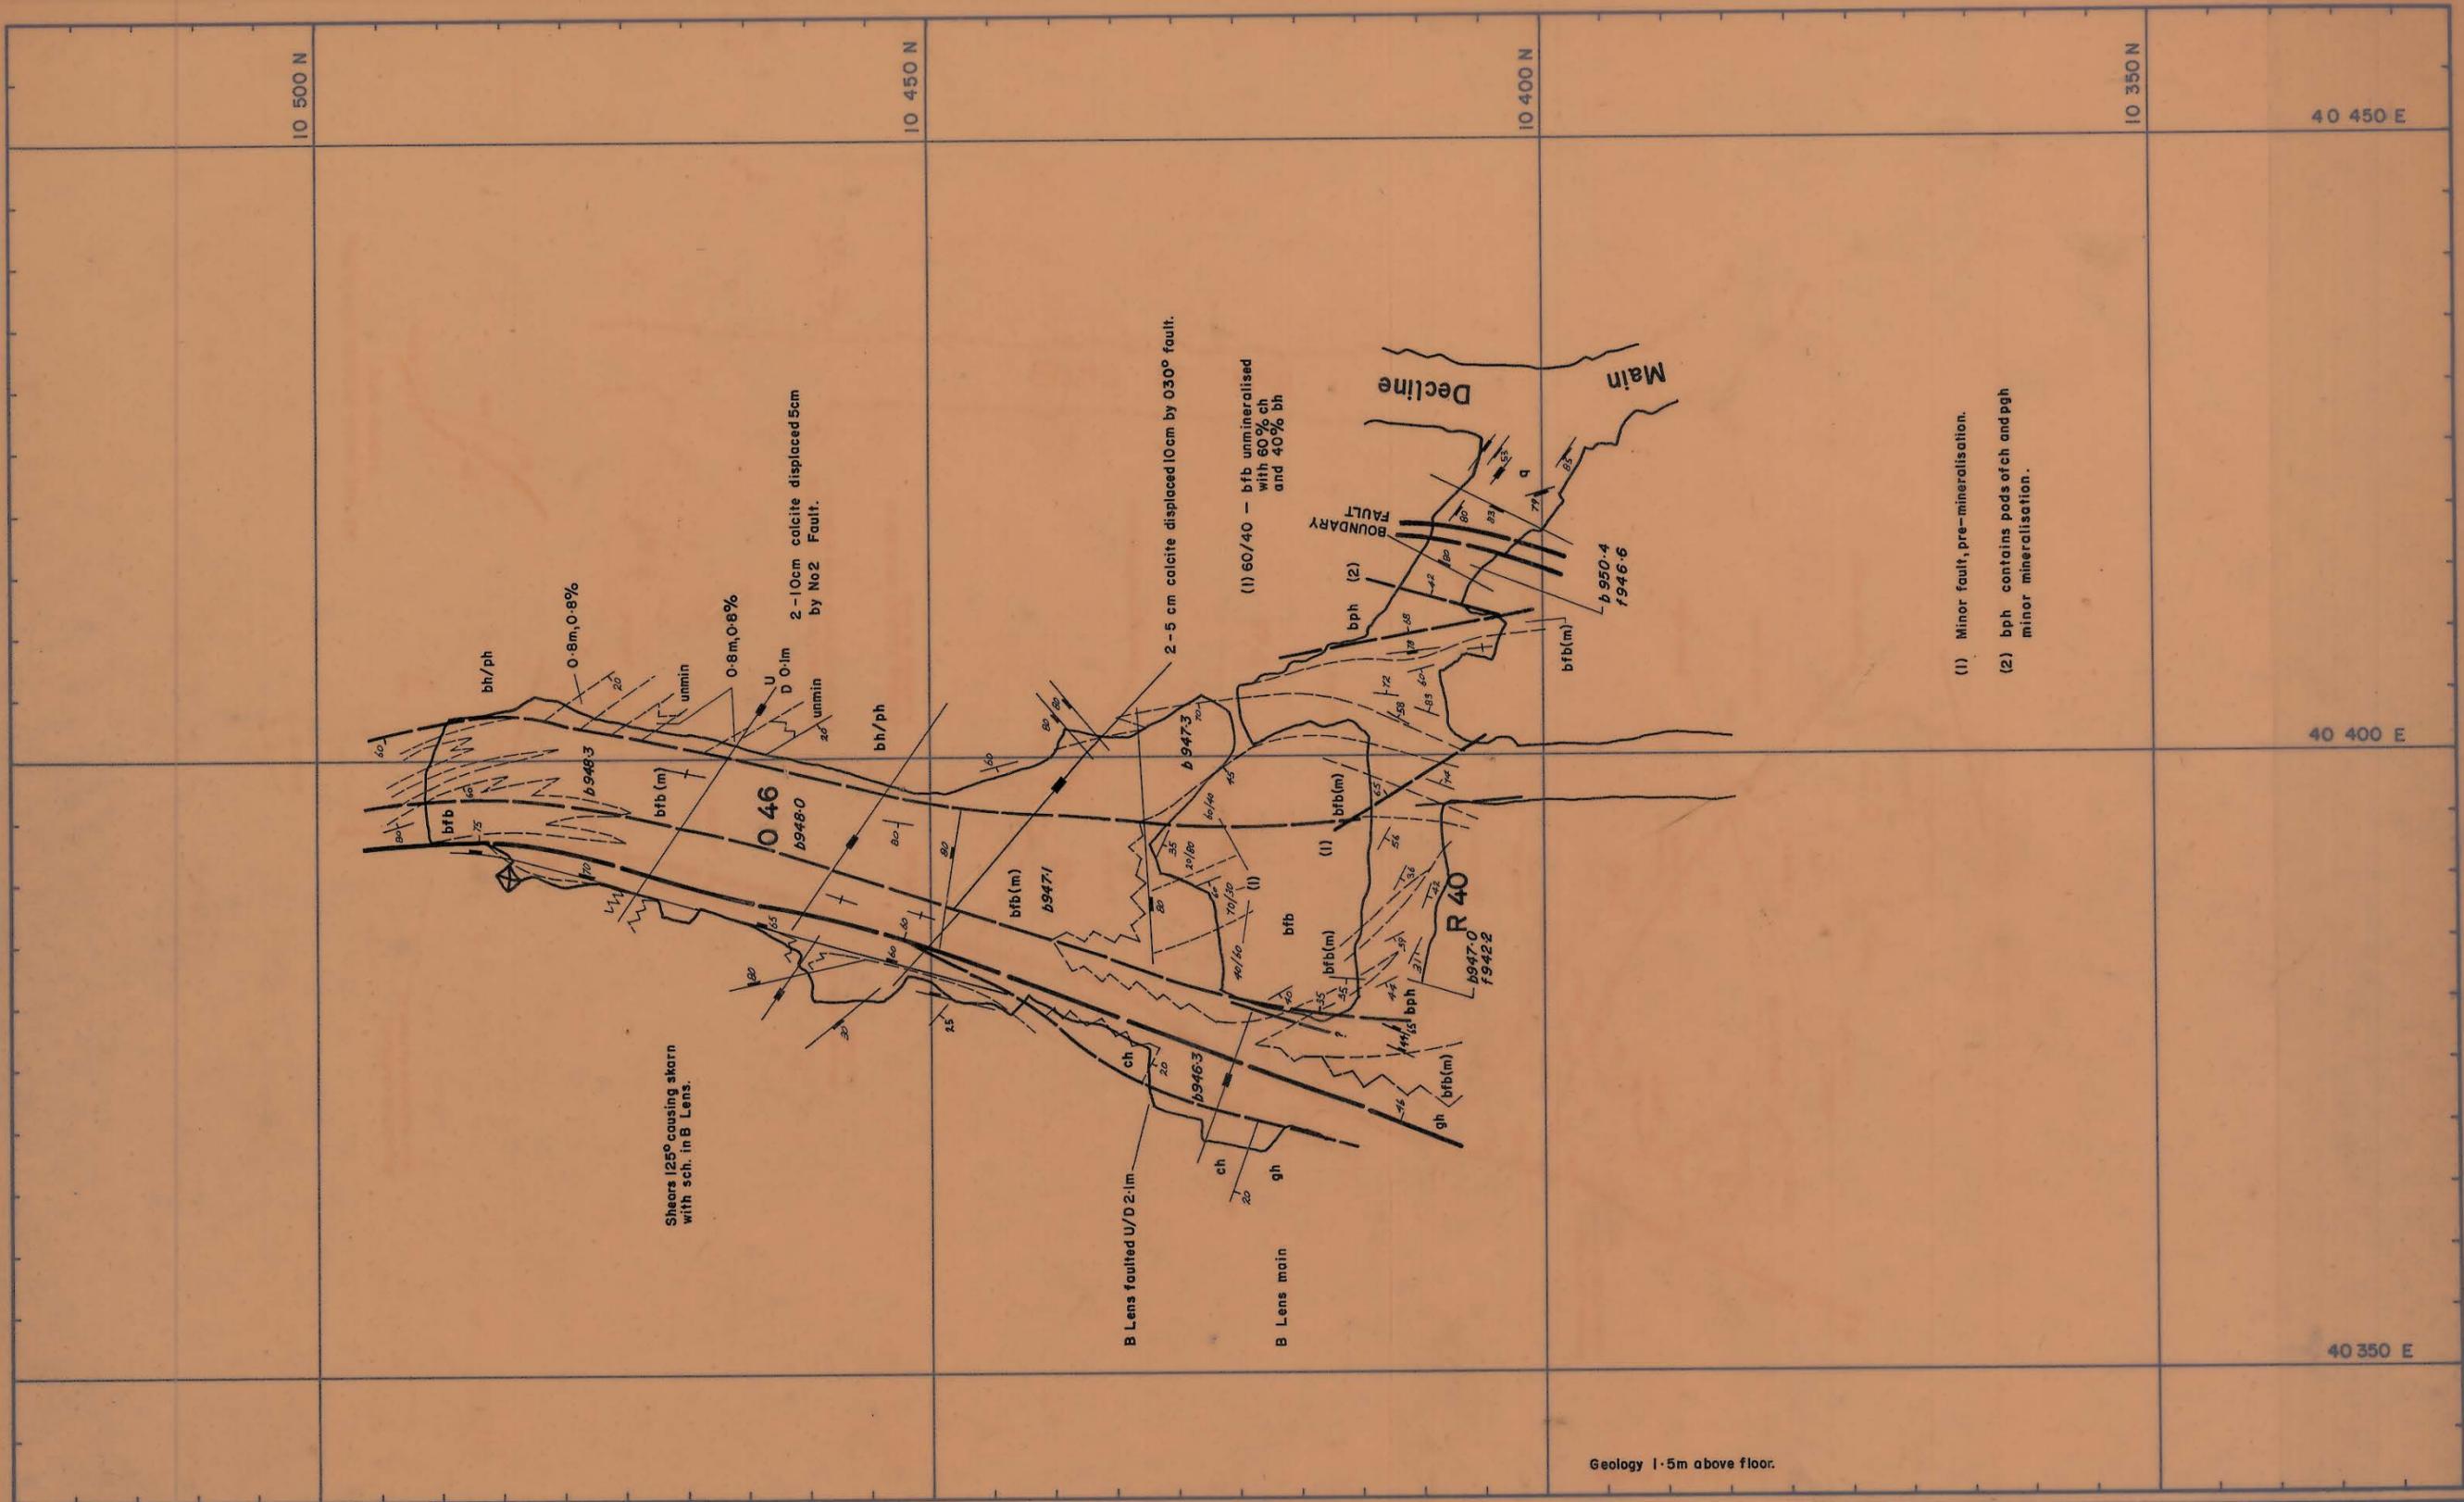

- (1) Minor fault, pre-mineralisation.
- (2) bph contains pods of ch and pgh minor mineralisation.

Geology 1.5m above floor.

REF PLAN R 40 mapped S.G.B JULY 1977 O 46 mapped T.F.P. APRIL 1981 O 39 mapped	GEOLOGY	Apr '81	SCALE 1:500		
	SURVEY				BOLD HEAD MINE FAULT BLOCK Lift n° 7
	PLANNING			DRAWING NUMBER	
	ROCK MEC.				
GRADE CON.					
DRAFTING	M.vdS.				
T.S.S.					