


27 JUN 1981

FAULT BLOCK
LIFT N°4

5 cm

0374_4791

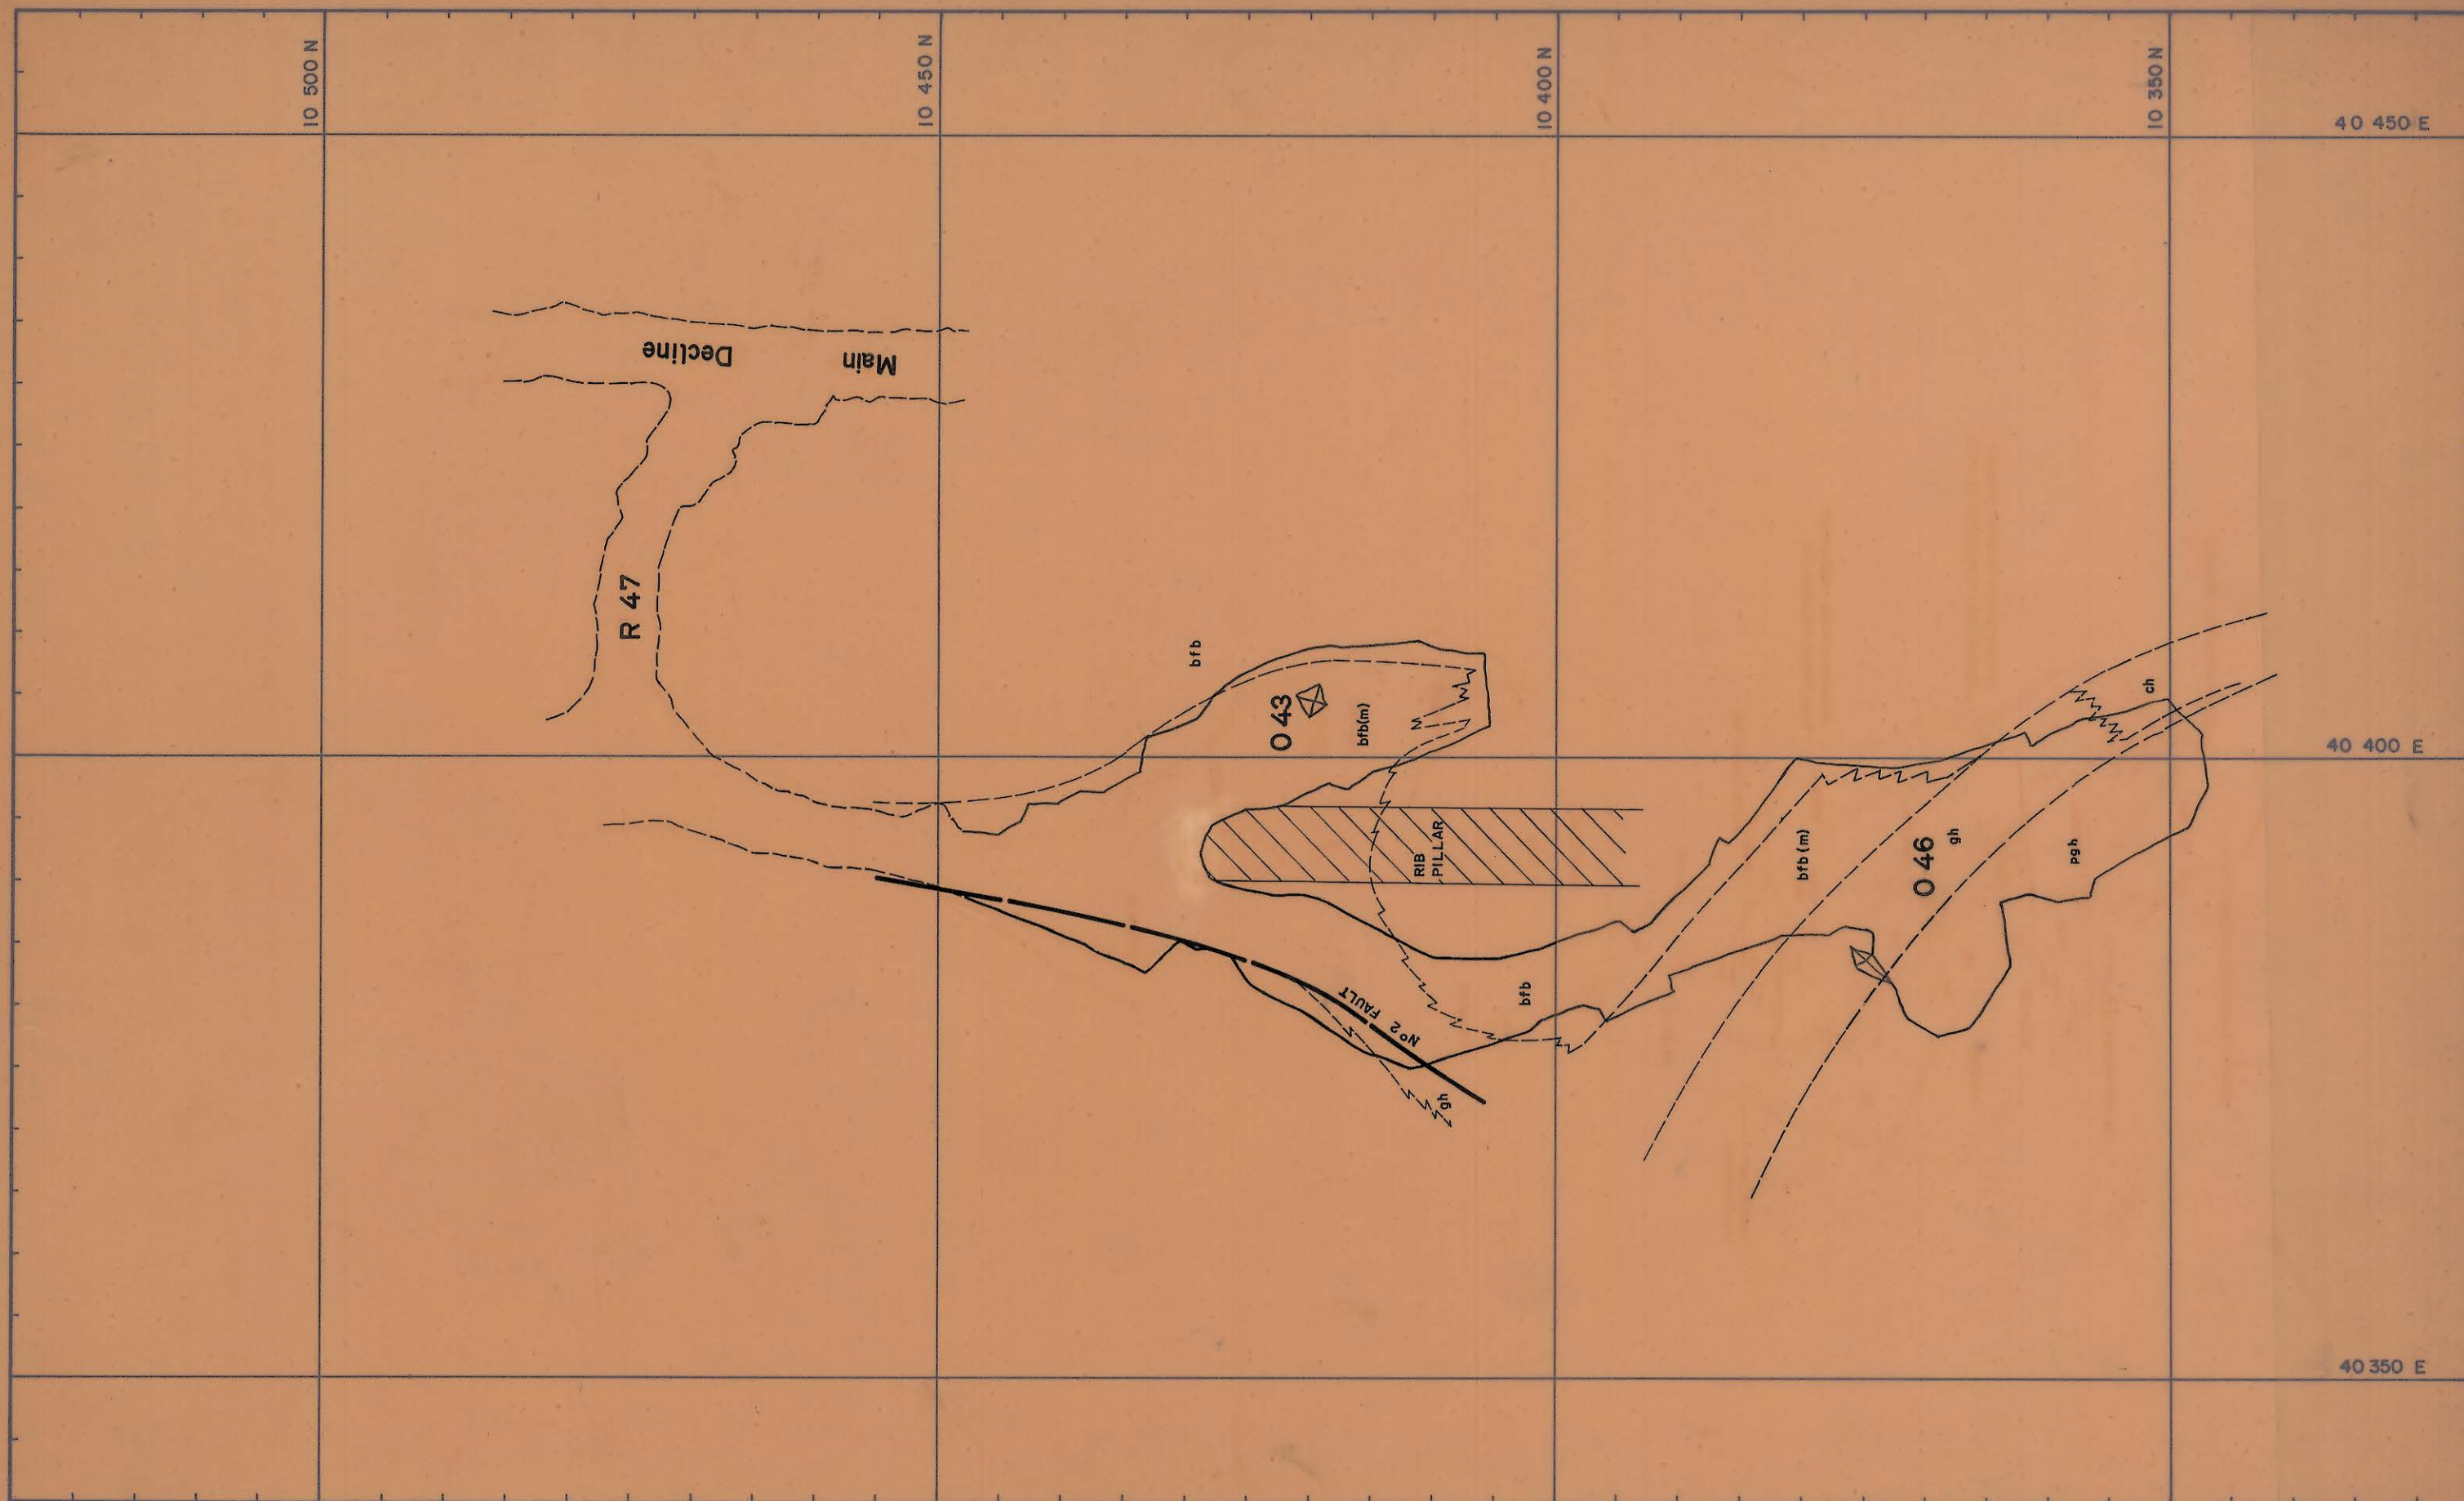

REF. PLAN

Geology from Fortnight Book only.

GEOLOGY

SURVEY

PLANNING

ROCK MEC.

GRADE CON.

DRAFTING M.vdS.

T.S.S.

SCALE 1:500

KIS KING ISLAND SCHEELITE
GRASSY KING ISLAND

BOLD HEAD MINE

FAULT BLOCK

Lift n° 4

DRAWING NUMBER