


27 JUN 1981

FAULT BLOCK
LIFT N°3

0374_4792

5 cm

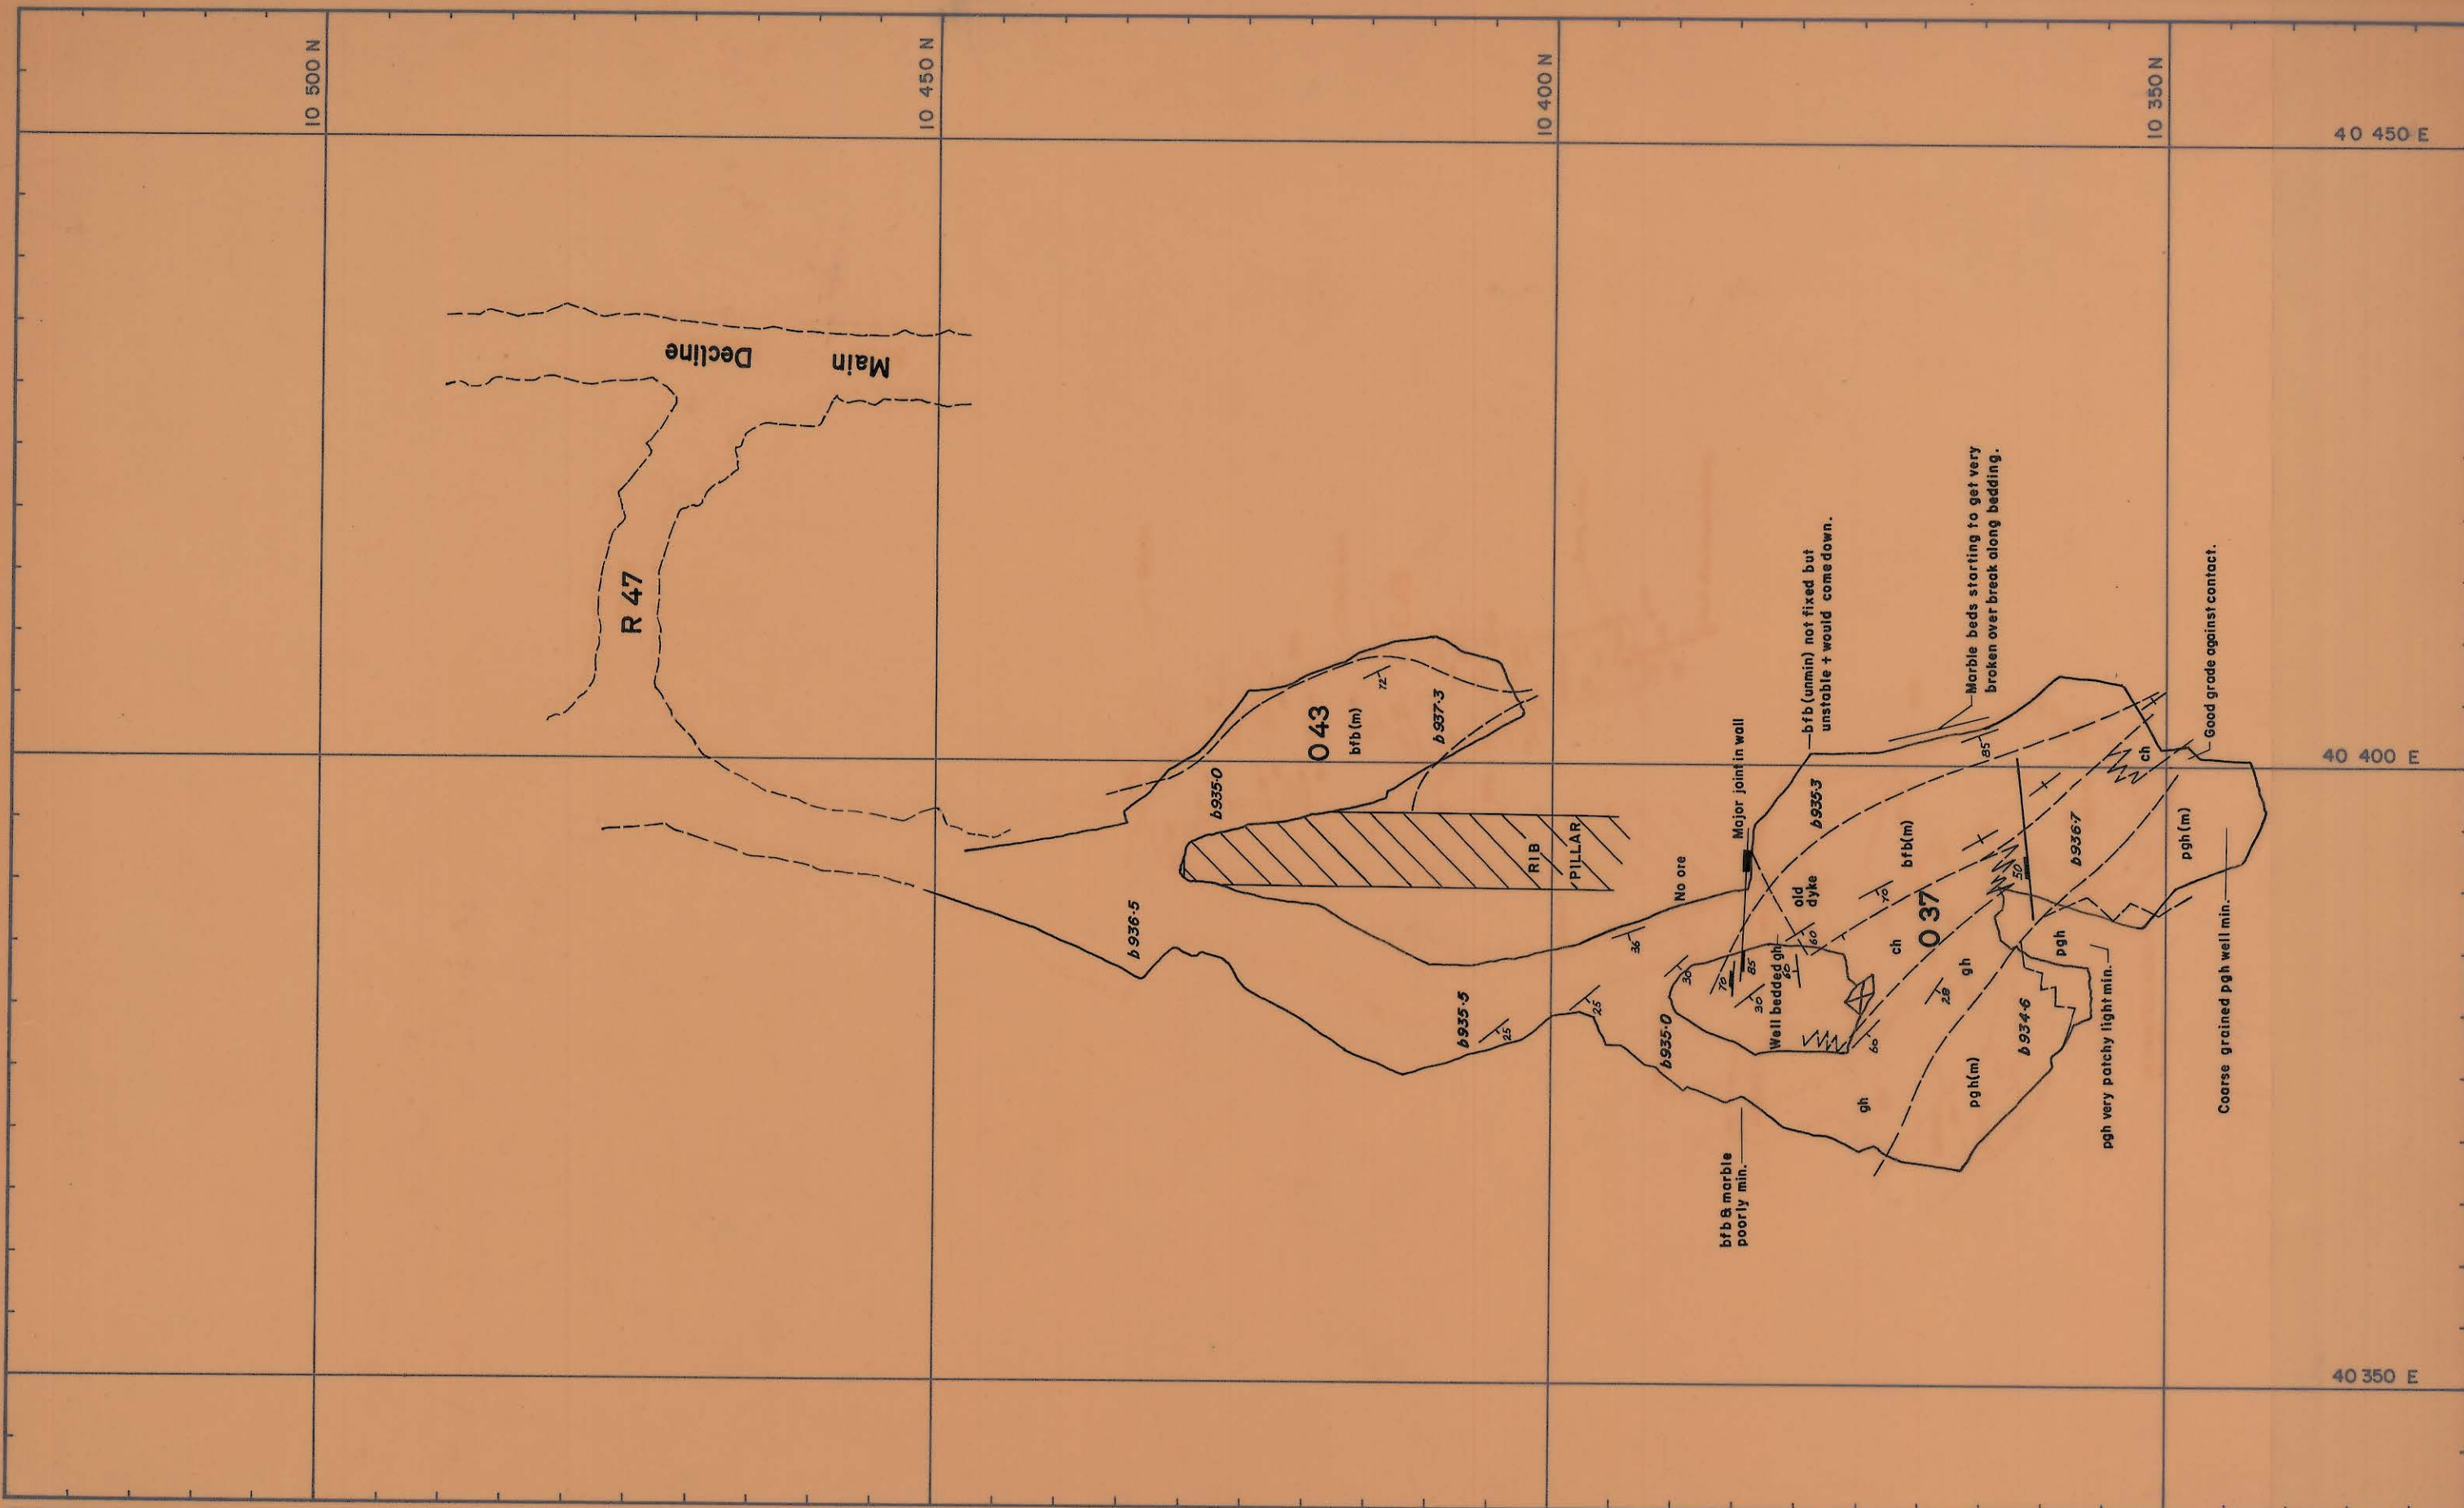

REF PLAN

037 043 mapped by J.M.C.

GEOLOGY

SURVEY

PLANNING

ROCK MEC.

GRADE CON.

DRAFTING M.vdS.

T.S.S.

SCALE 1:500

KIS KING ISLAND SCHEELITE
GRASSY KING ISLAND

BOLD HEAD MINE

FAULT BLOCK
Lift n°3

DRAWING NUMBER