


5 cm

0374_4793

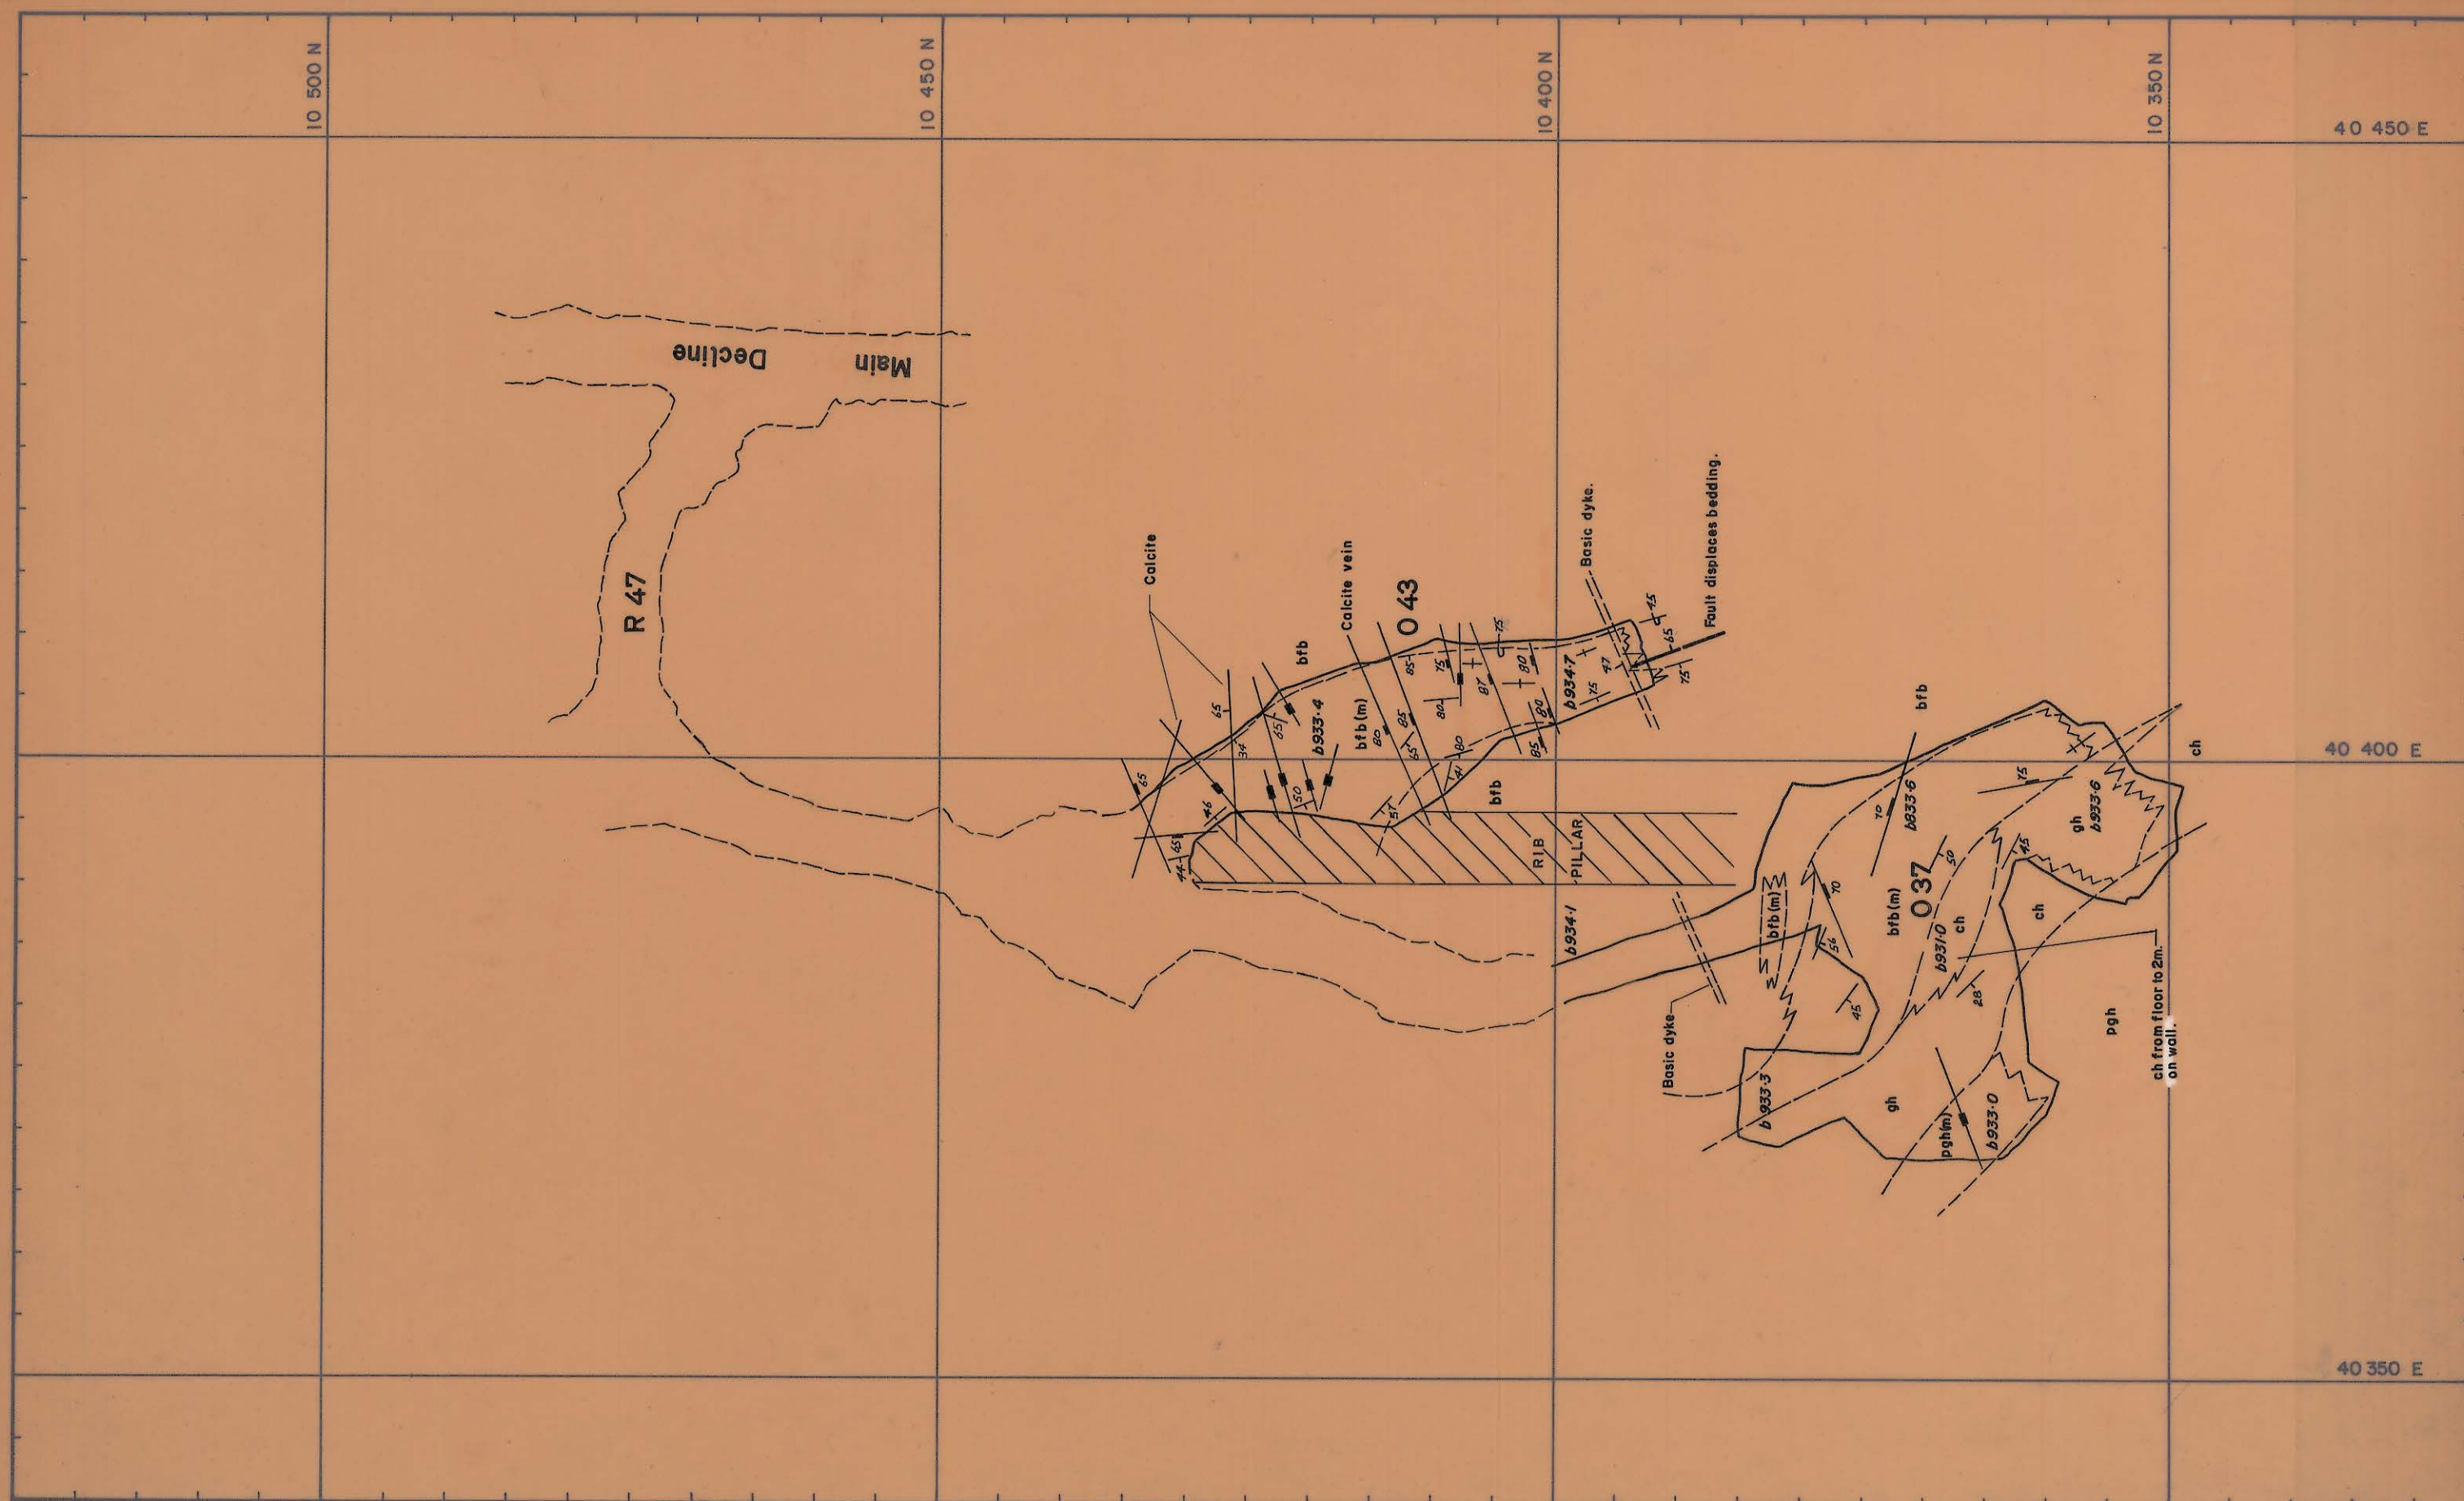

REF. PLAN

O 43 Mapped by J.M.C. May'78
O 37 Mapped by J.M.C.

GEOLOGY

J.M.C.

MAY'78

SURVEY

PLANNING

ROCK MEC.

GRADE CON.

DRAFTING

M.vdS.

T.S.S.

SCALE 1:500

KIS KING ISLAND SCHEELITE
GRASSY KING ISLAND

BOLD HEAD MINE
FAULT BLOCK
Lift n° 2

DRAWING NUMBER