


0374_4800

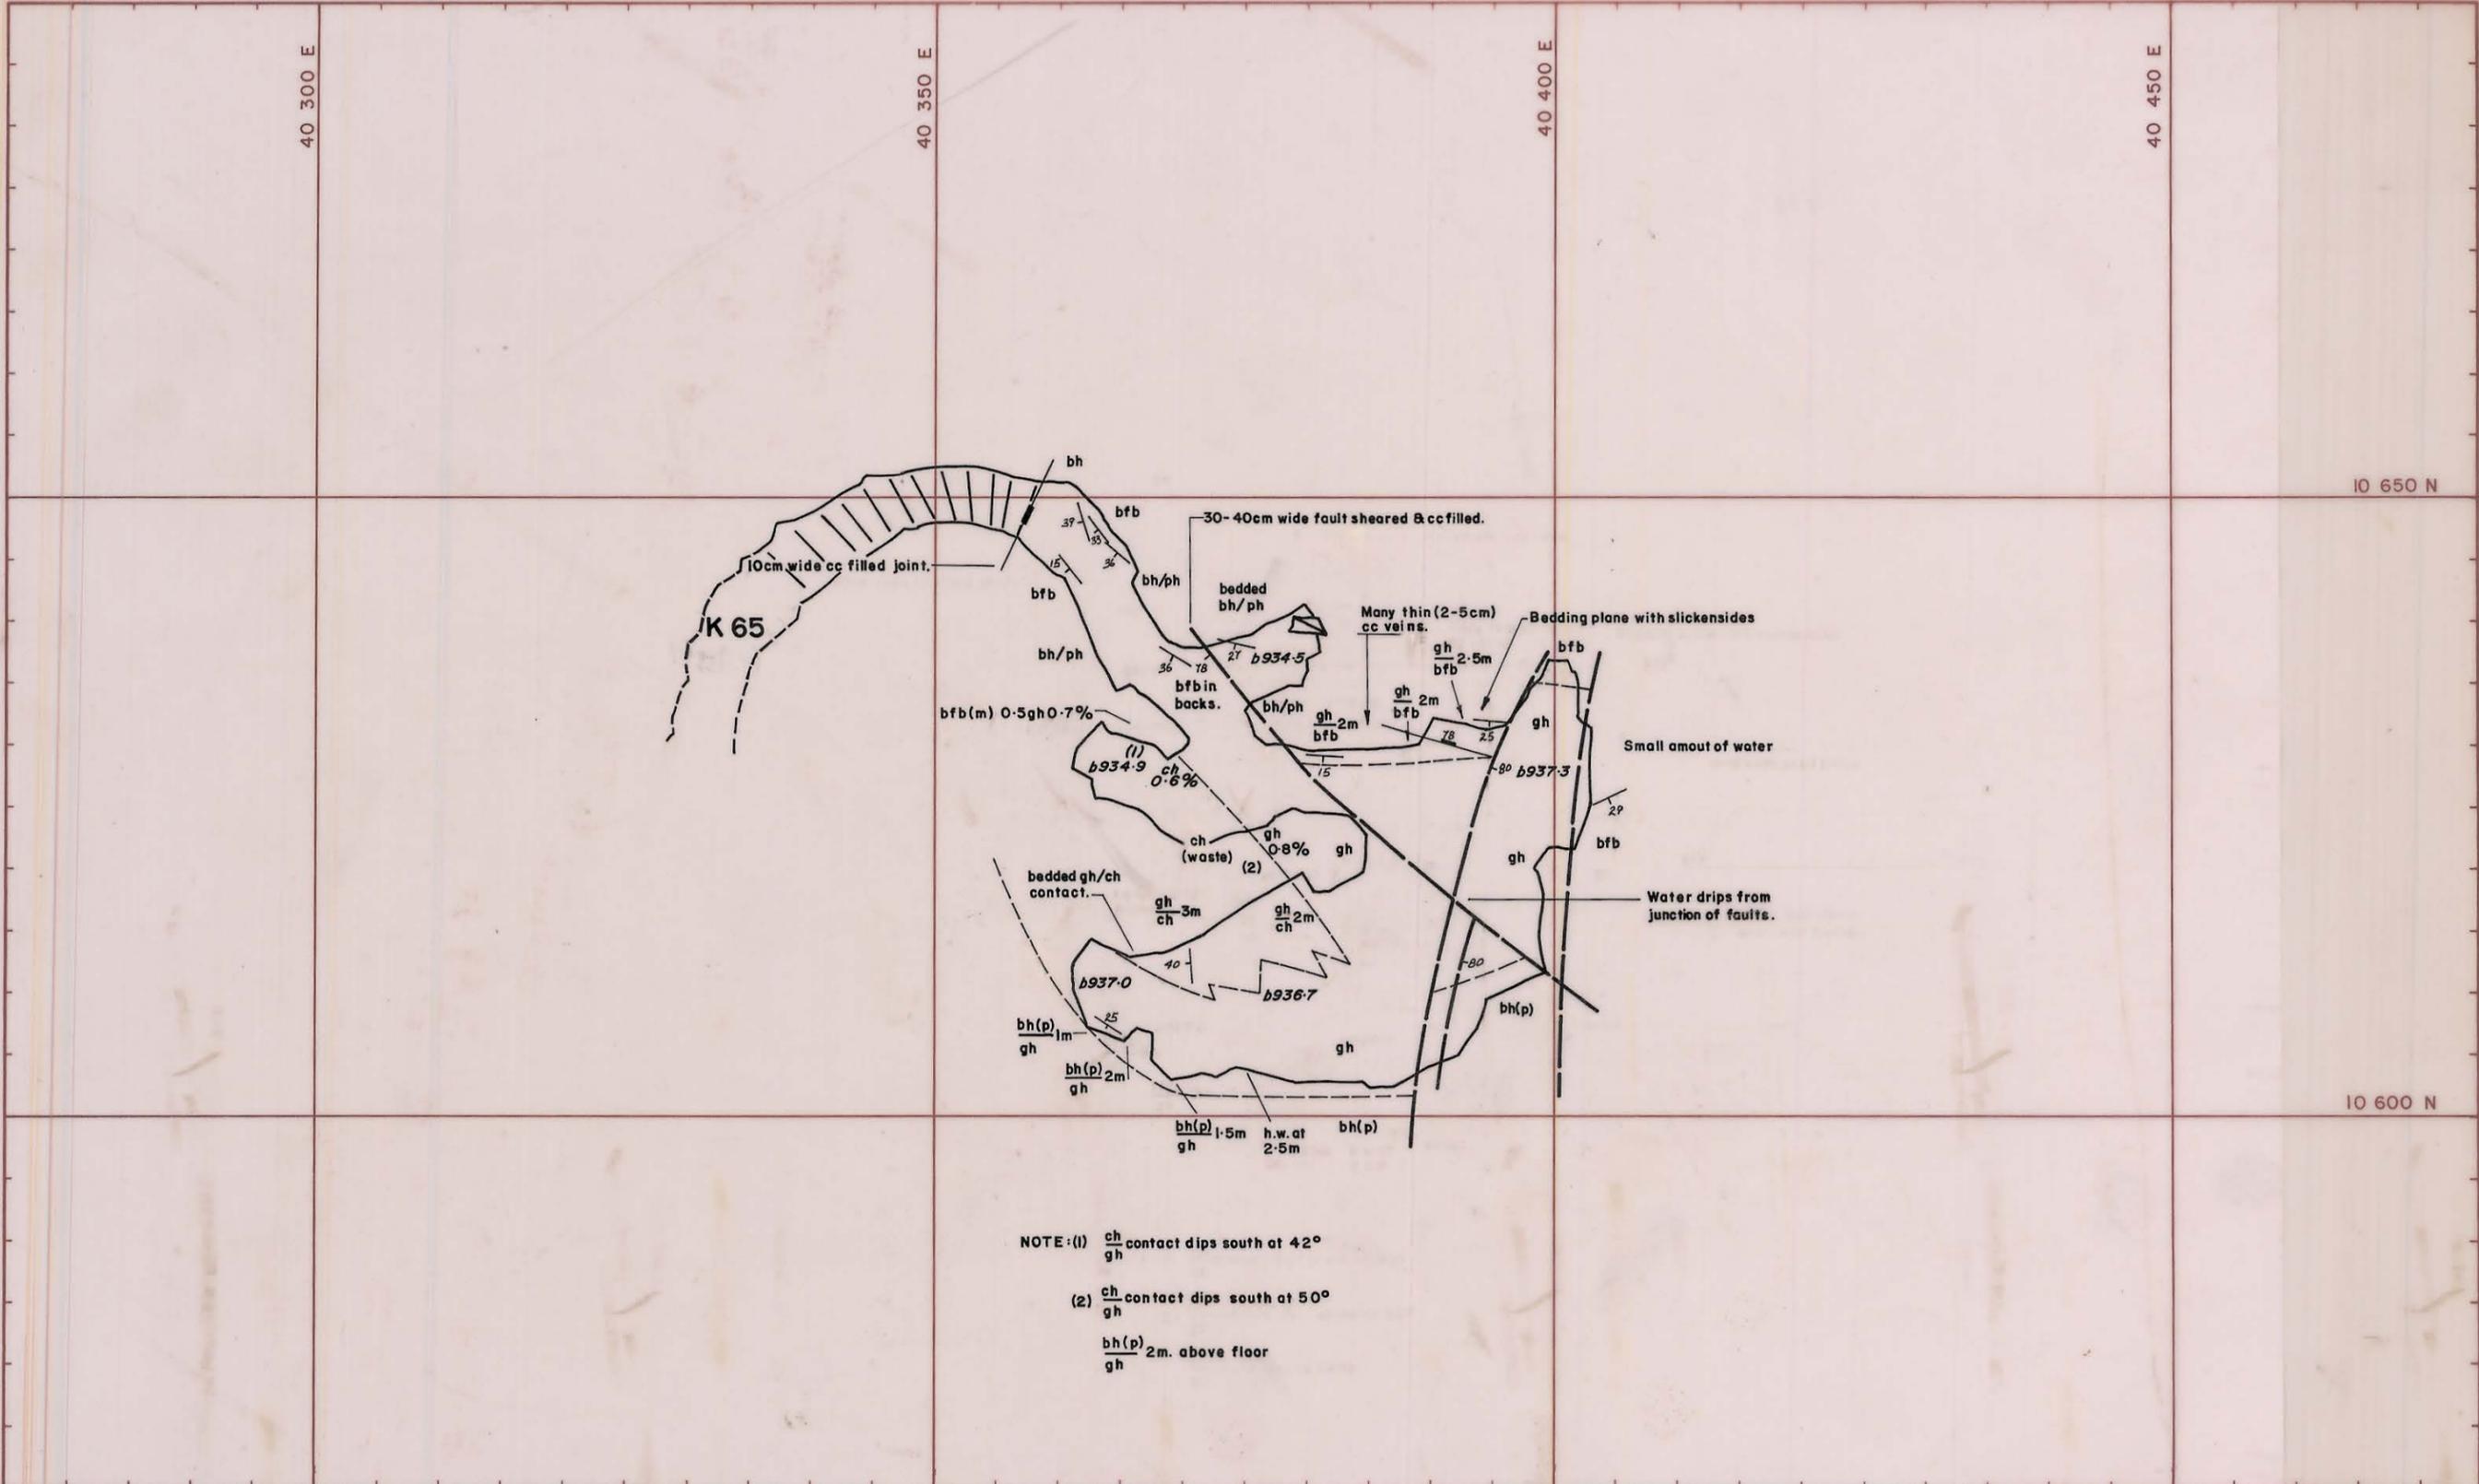

NOTE: (1) $\frac{ch}{gh}$ contact dips south at 42°
(2) $\frac{ch}{gh}$ contact dips south at 50°
 $\frac{bh(p)}{gh}$ 2m. above floor

REF. PLAN	GEOLOGY	R.E.S-D	SCALE 1:500	
	SURVEY			
	PLANNING			
	ROCK MEC.			
	GRADE CON.			
DRAFTING	M.vdS.	DRAWING NUMBER		
T.S.S.				
			BOLD HEAD MINE C2 Orebody R60 3rd Lift	