



0374_4802

5 cm

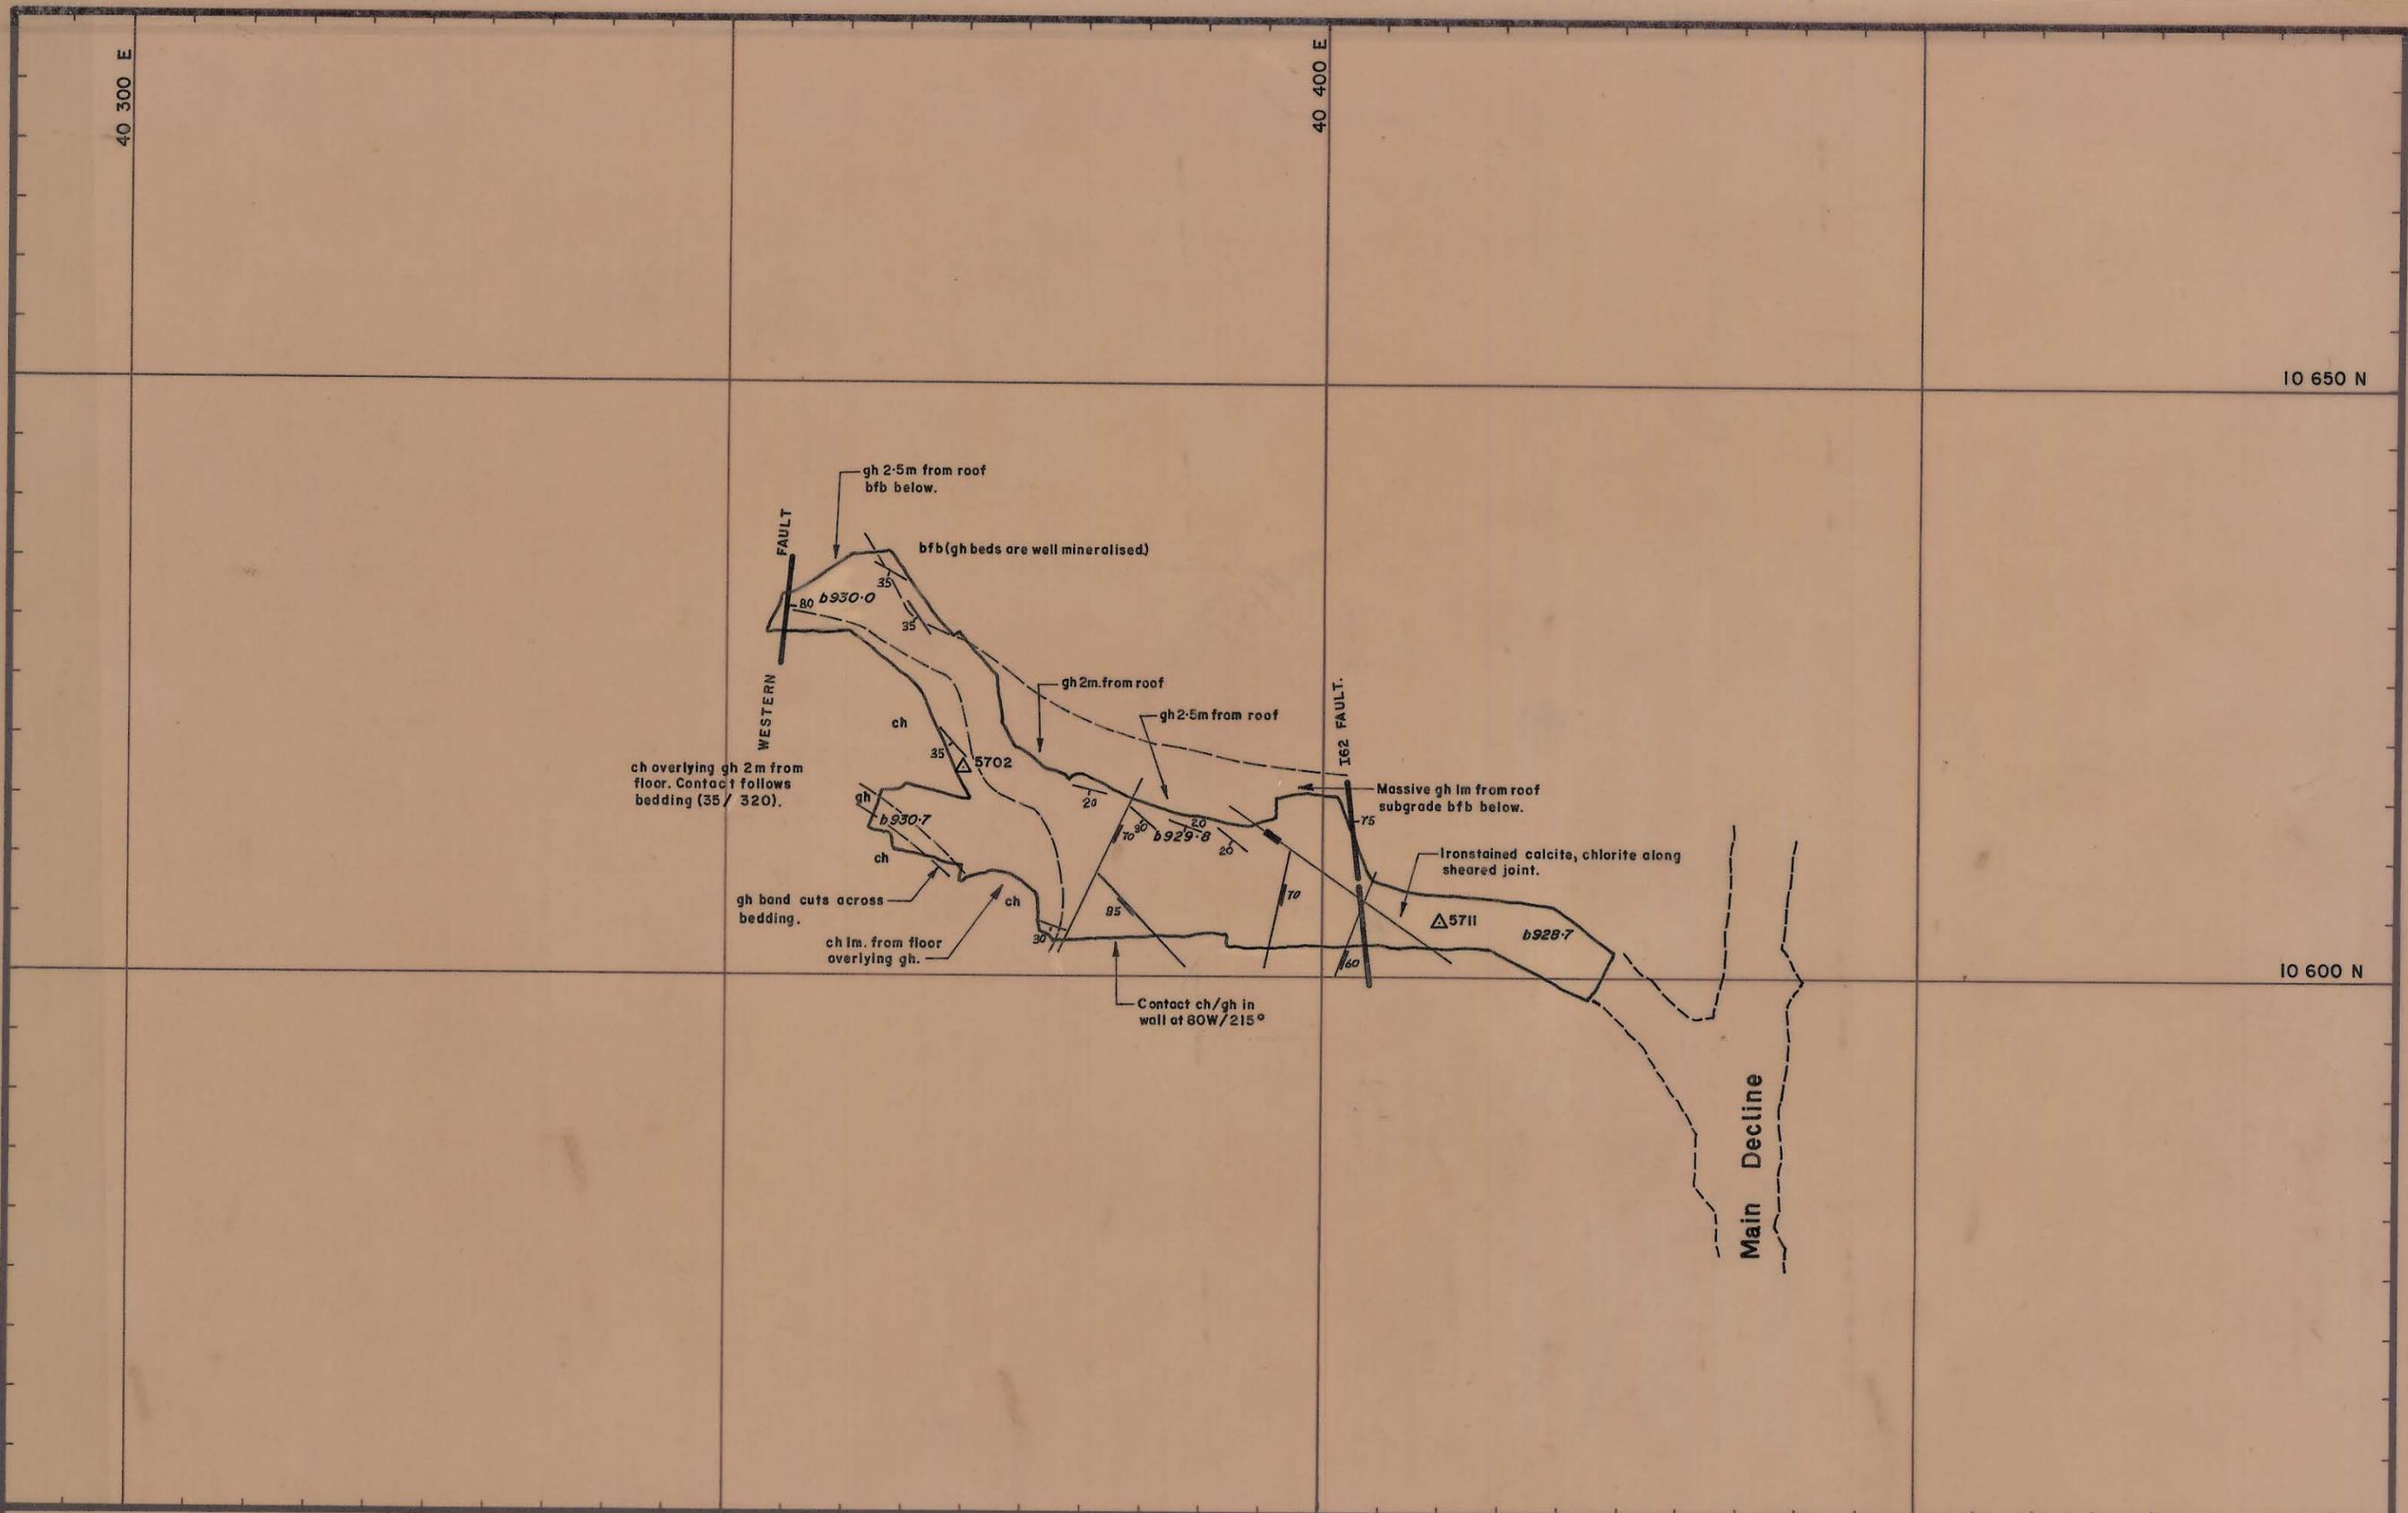

LEGEND:

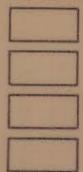

04 BH15-1064



GEOEKO LIMITED
KING ISLAND

Scale: 1:500

NO K

DATE:
 GEOL: J.M.C.
 DWN: M.v.d.S.
 CHKD:

BOLD HEAD MINE
 C LENS OREBODY
 R60 1st Lift