


P57 STOPE
7th LIFT

0374_4805

5 cm

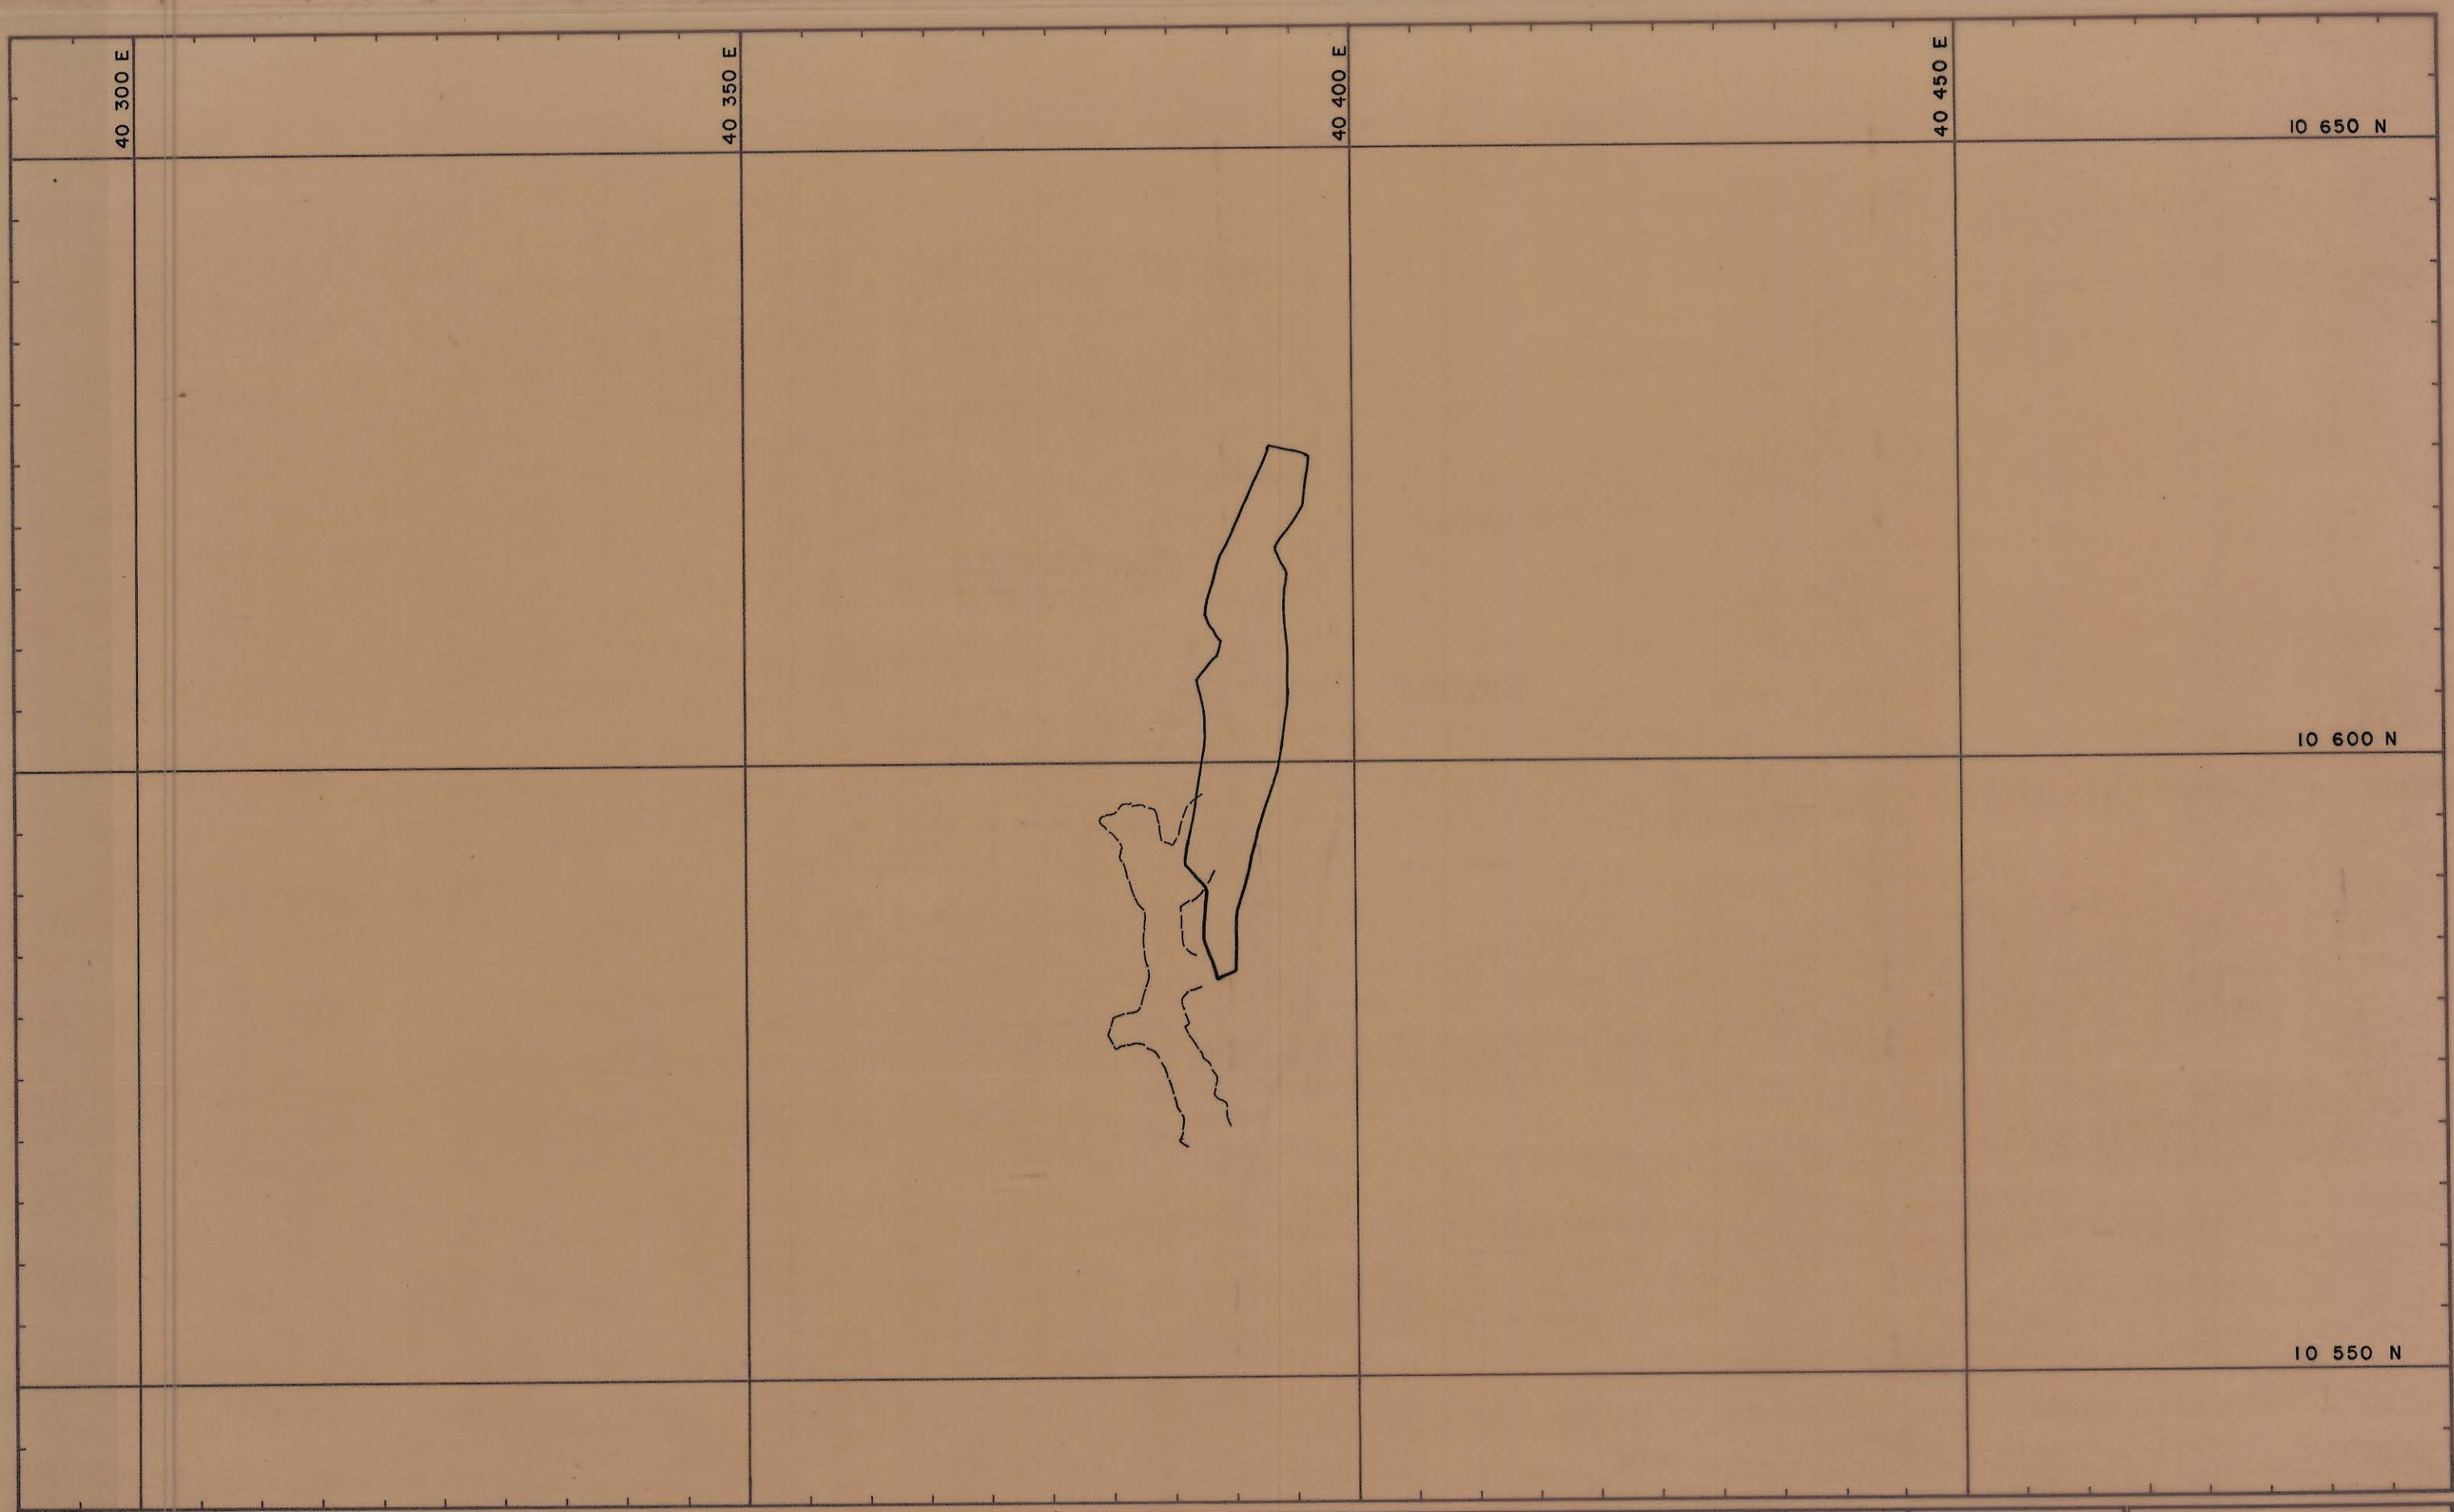

	REF PLAN	GEOLOGY			SCALE 1:500	 KING ISLAND SCHEELITE GRASSY KING ISLAND
		SURVEY				
		PLANNING				
		ROCK MEC.				
		GRADE CON.				
		DRAFTING	M.vdS.			
		T.S.S.			DRAWING NUMBER	

BOLD HEAD MINE
P 57 STOPE
7th Lift