


0374_4806

5 cm

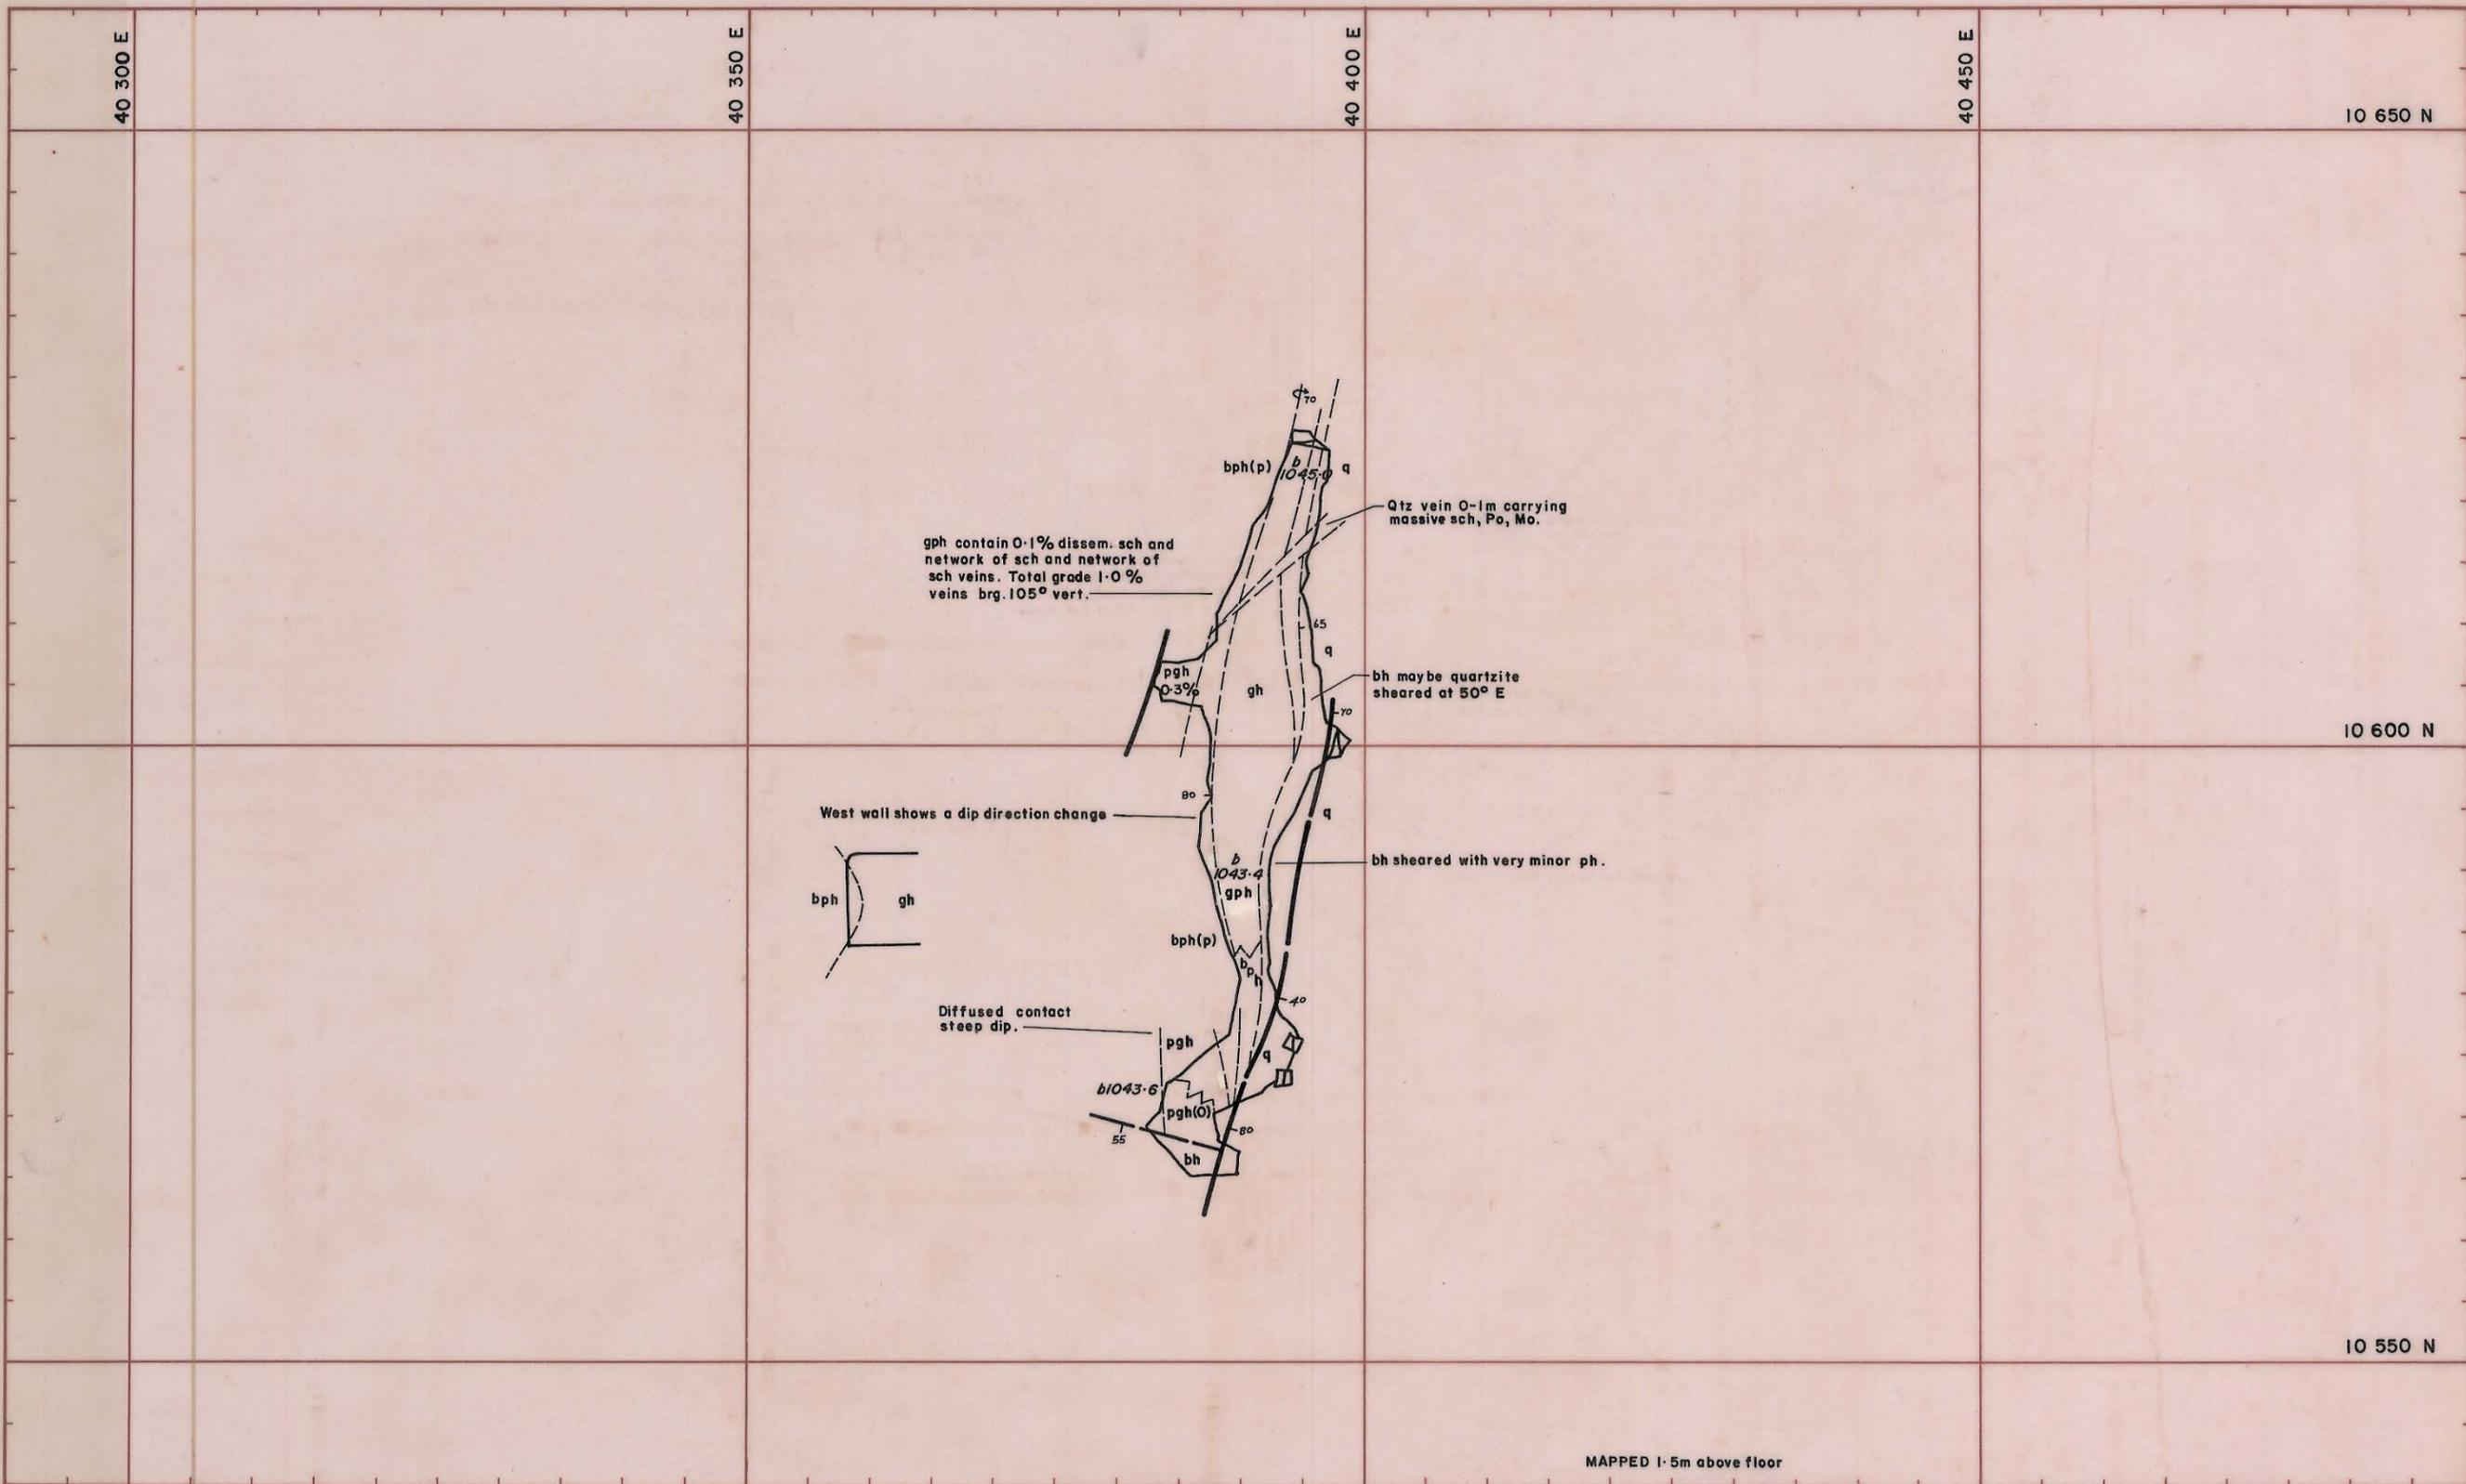

MAPPED 1.5m above floor

REF PLAN	GEOLOGY	T.F.P.	MARCH 81	SCALE 1:500	
	SURVEY				
	PLANNING				
	ROCK MEC.				
	GRADE CON.				
	DRAFTING	M.vdS.			
T.S.S.			DRAWING NUMBER		
BOLD HEAD MINE P 57 STOPE 6th Lift					