
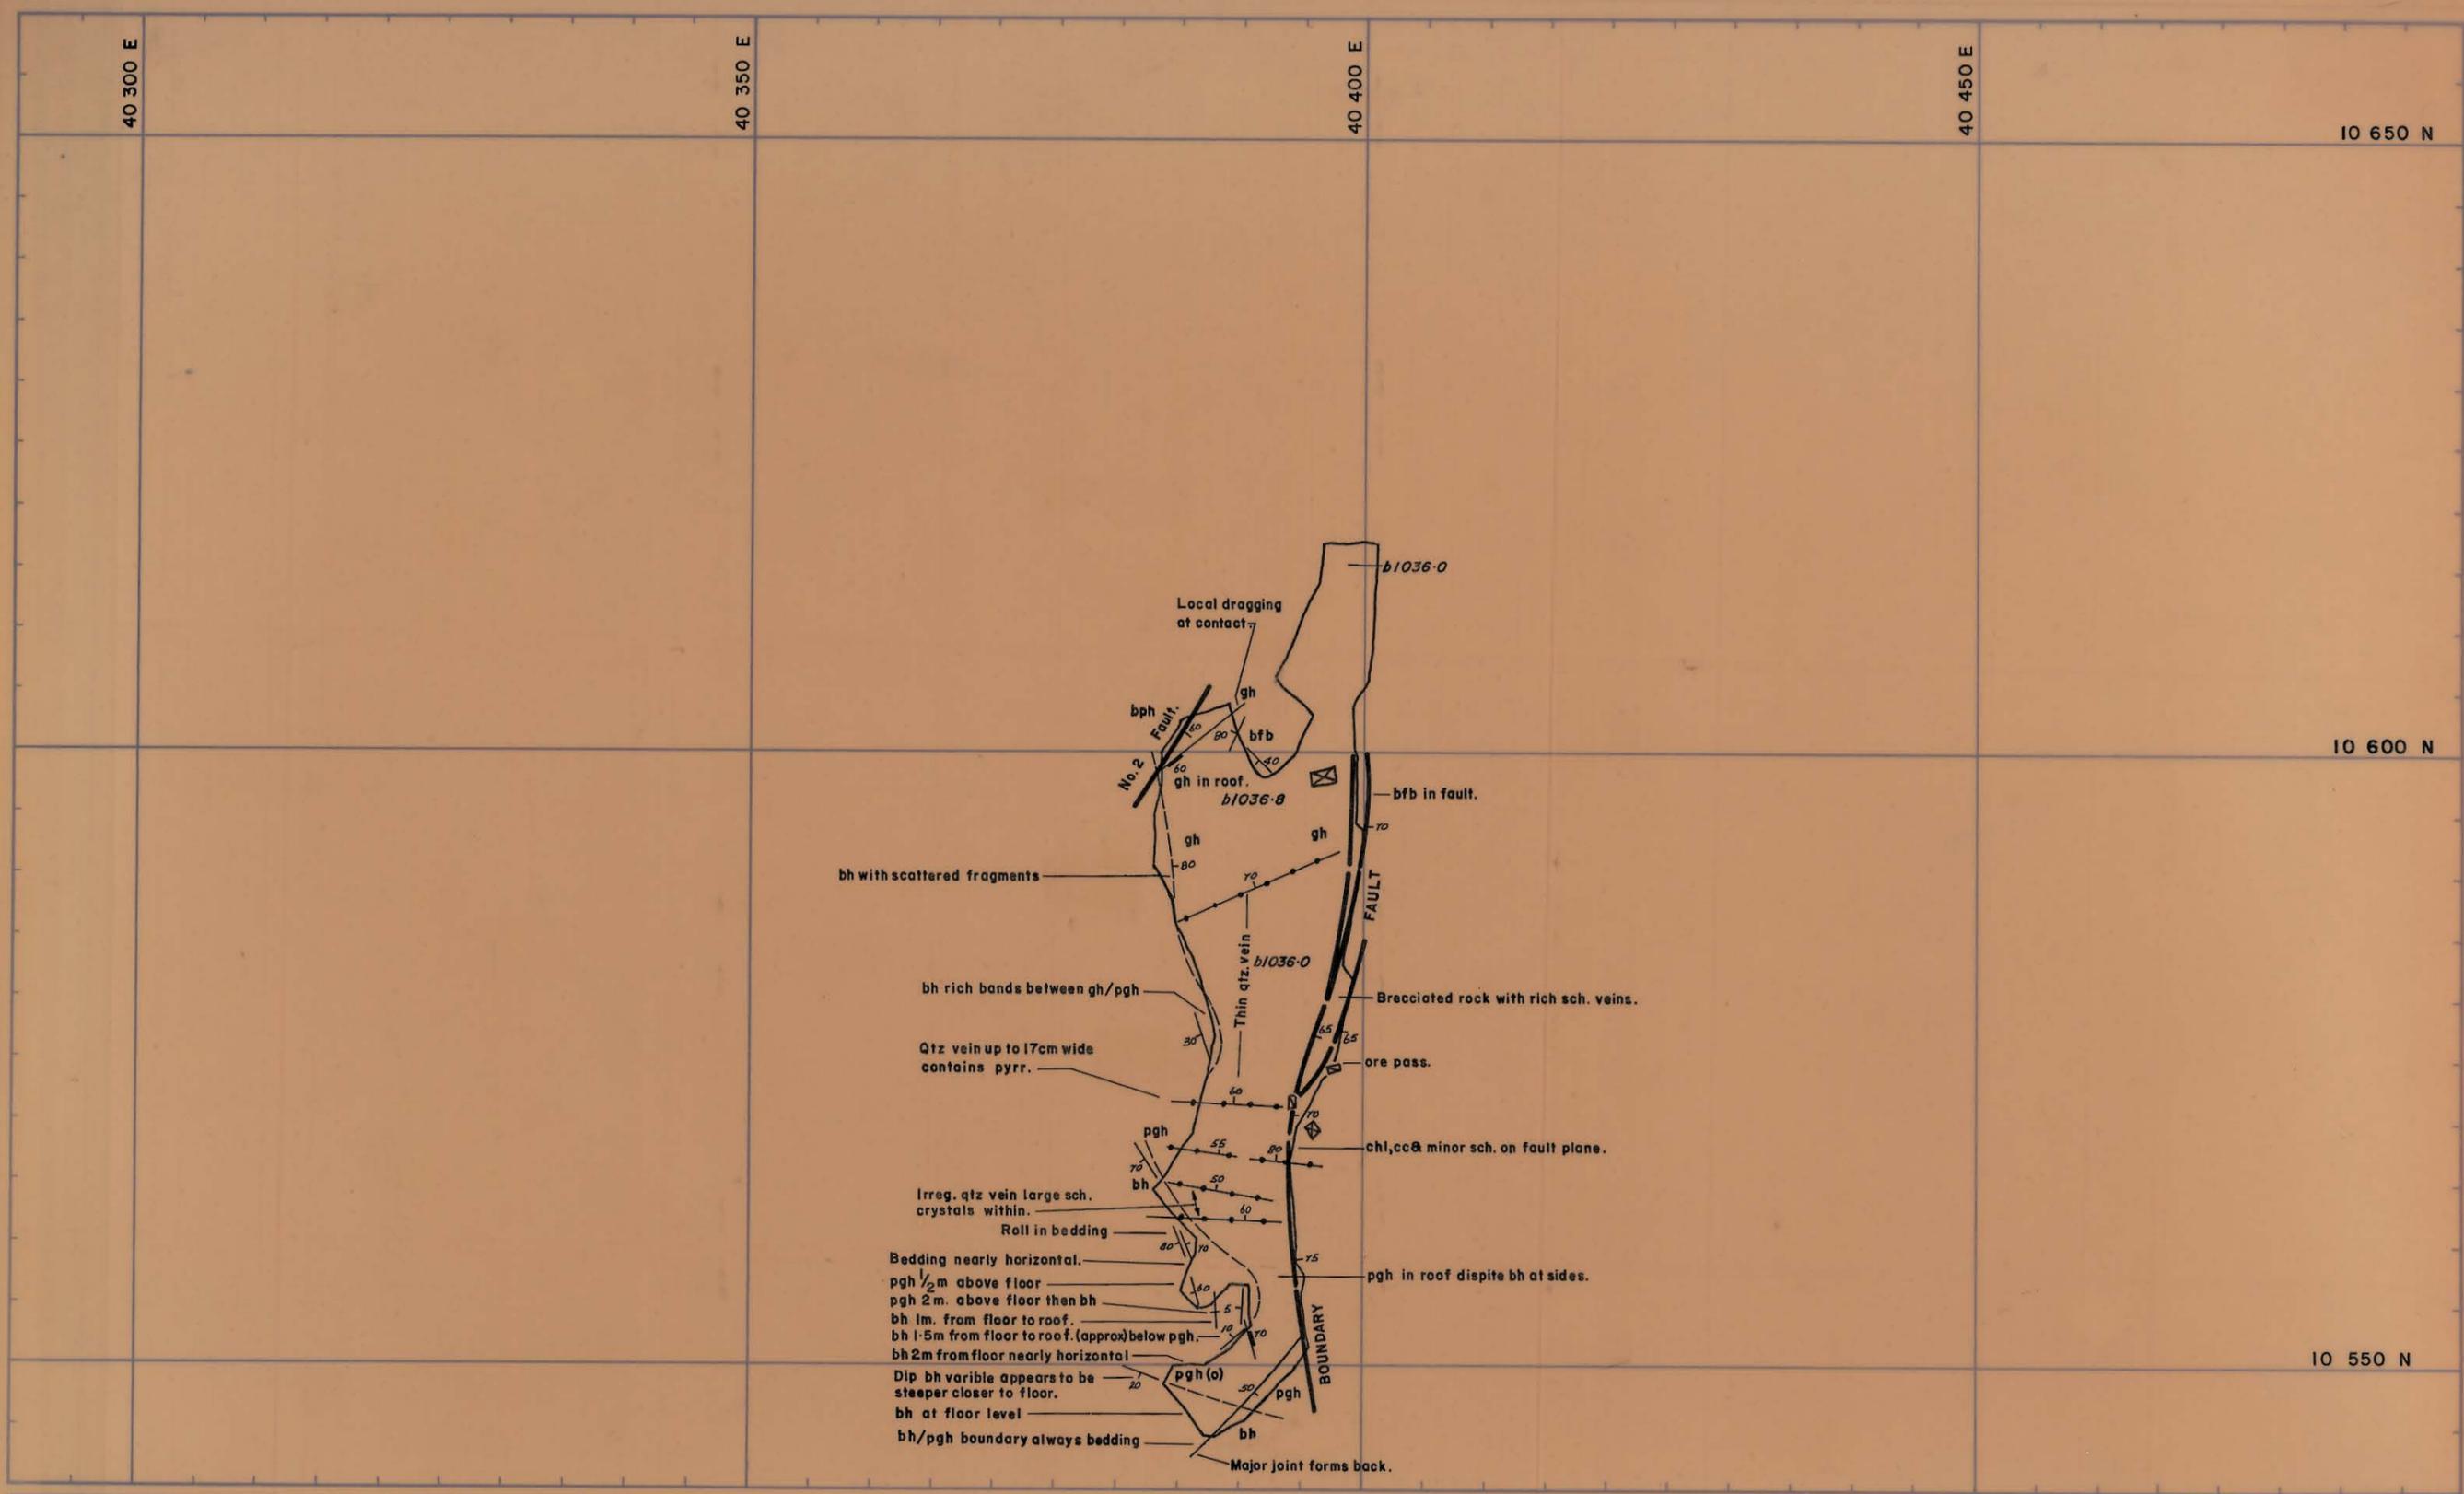


0374_4809

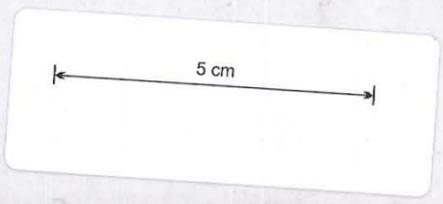

REF PLAN	GEOLOGY	J.M.C.	SCALE 1:500	
	SURVEY			
	PLANNING			
	ROCK MEC.			
	GRADE CON.			
	DRAFTING	M.vdS.		
	T.S.S.			
	BOLD HEAD MINE P 57 STOPE 3rd Lift			