


0374_4811



LEGEND:

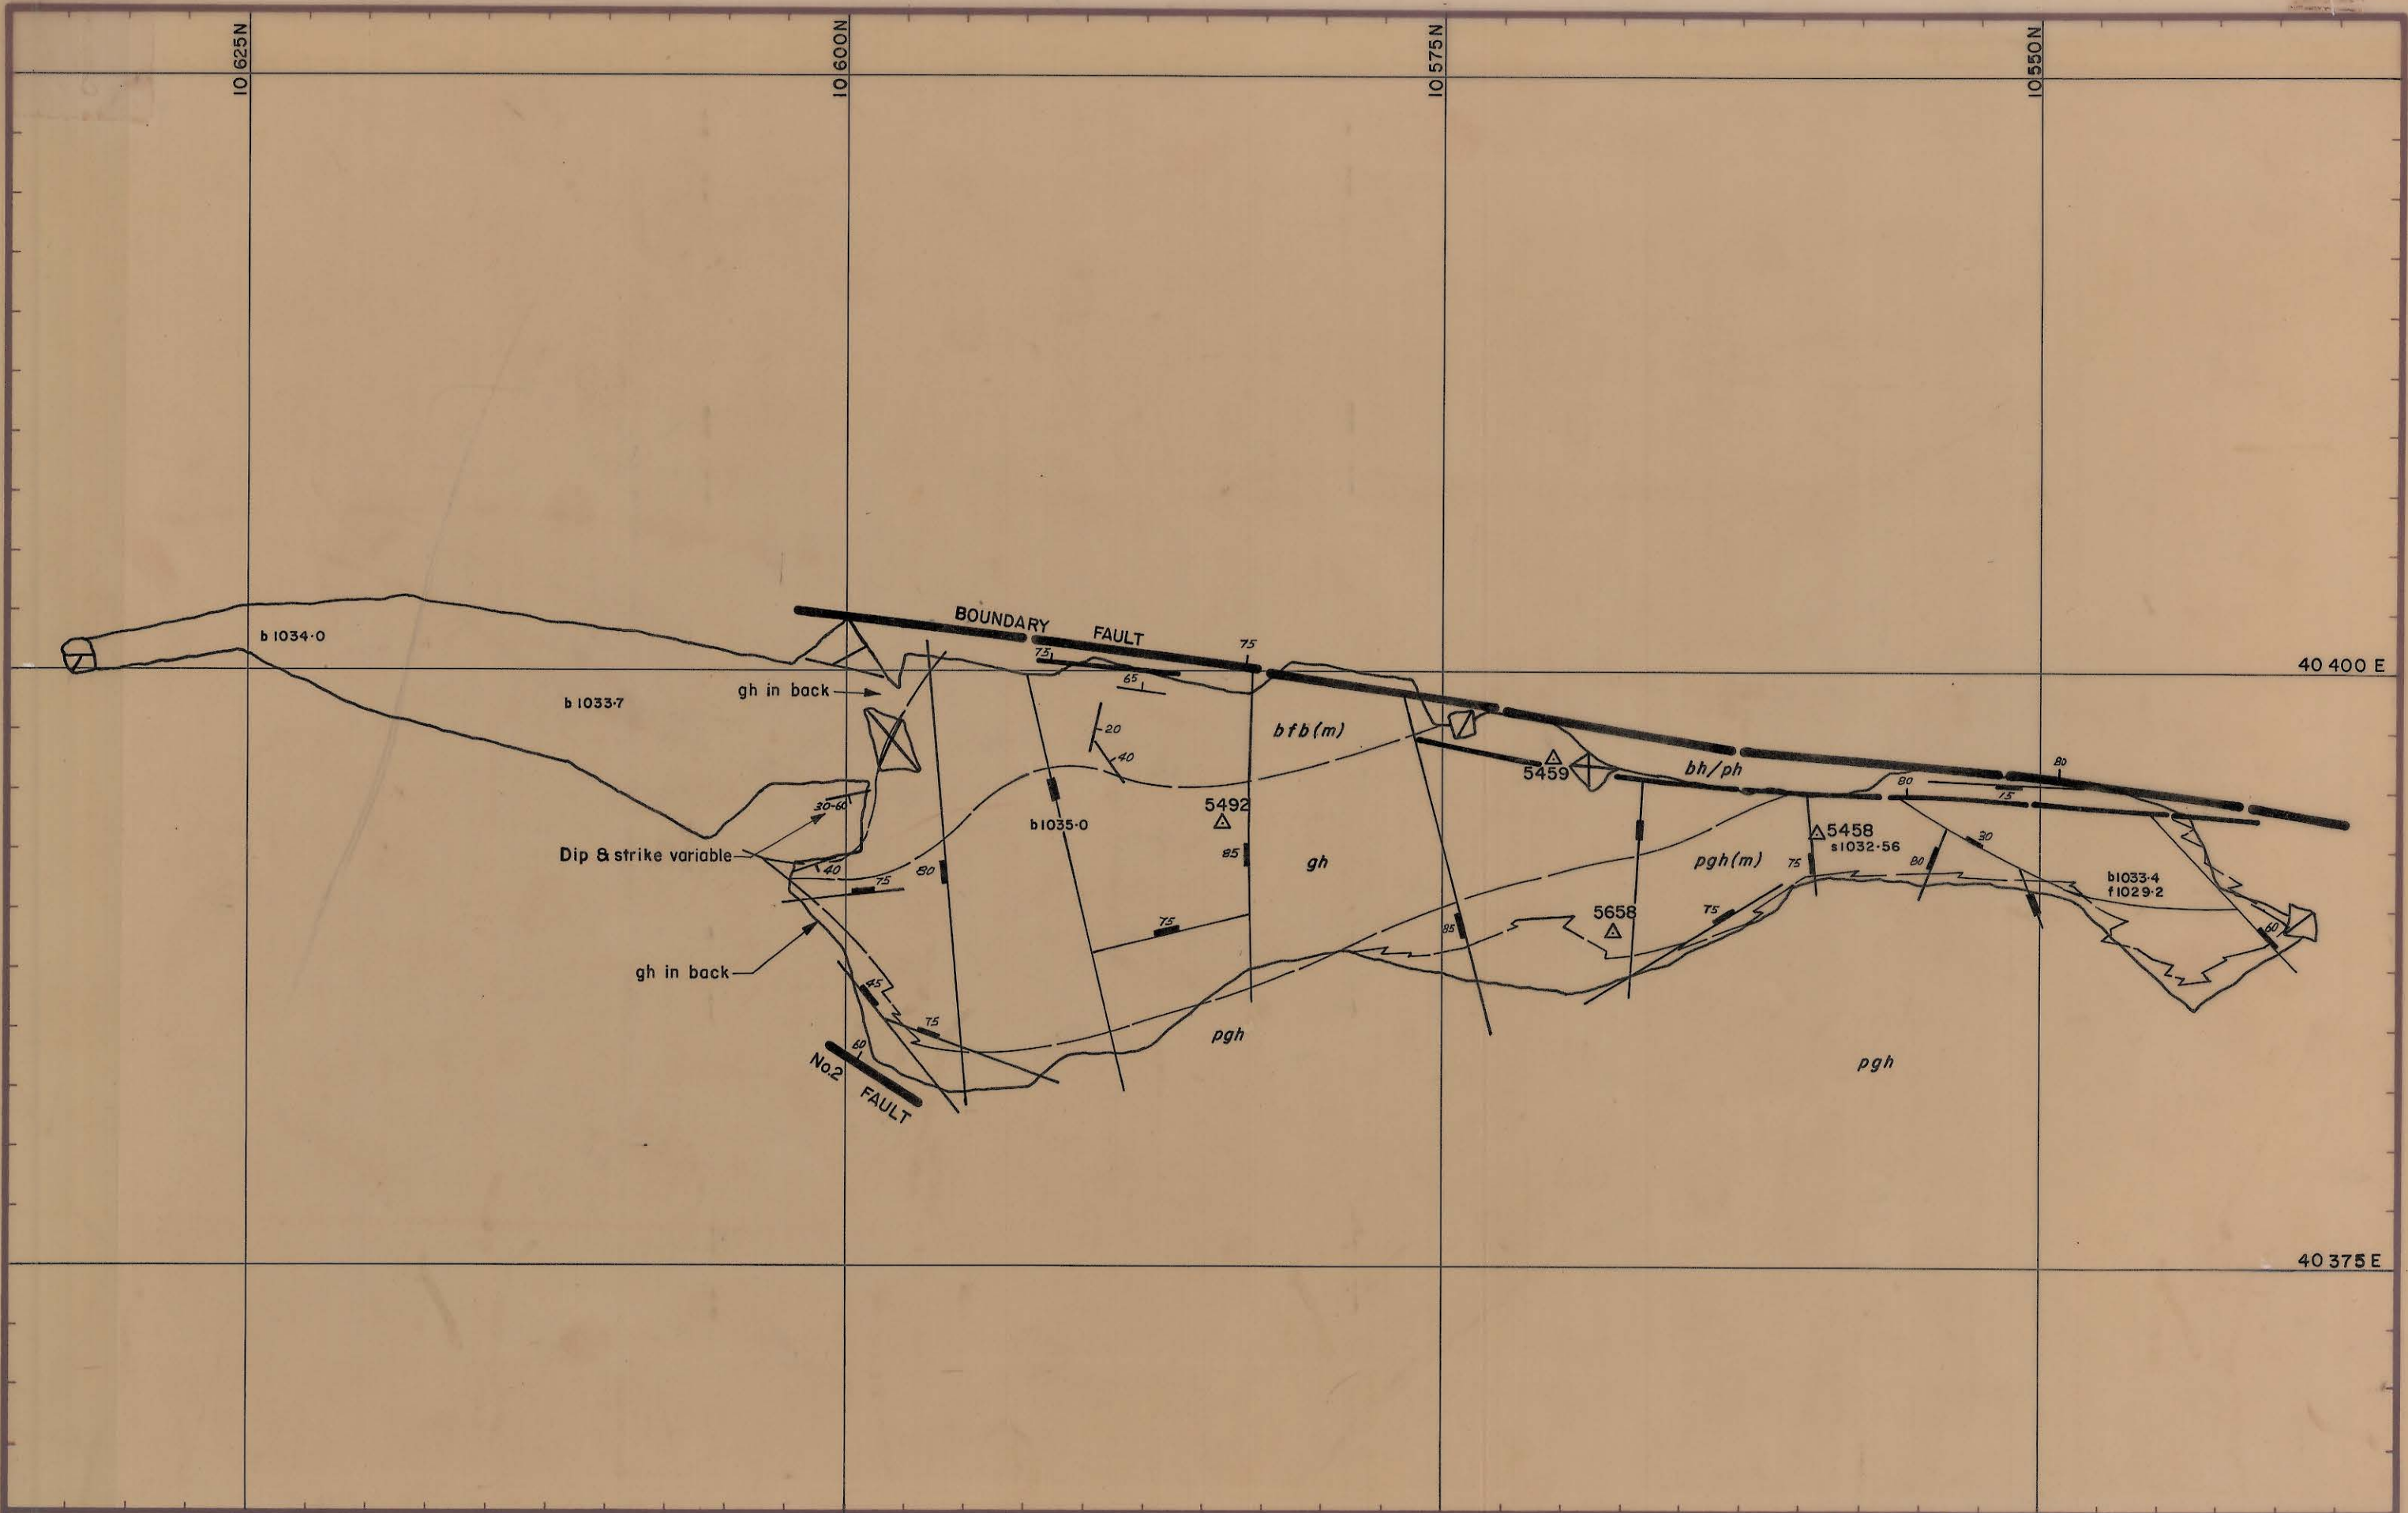

DATE: Nov 78
GEOL: J.M.C.
DWN: M.V.
CHKD:

GEOPEKO LIMITED
KING ISLAND

Scale: 1:250

No. K

**BOLD HEAD MINE
BOUNDARY ORE
P 57 STOPE 2nd LIFT**