


27 JUN 1981

P57 STOPE
1st LIFT

0374_4812

5 cm

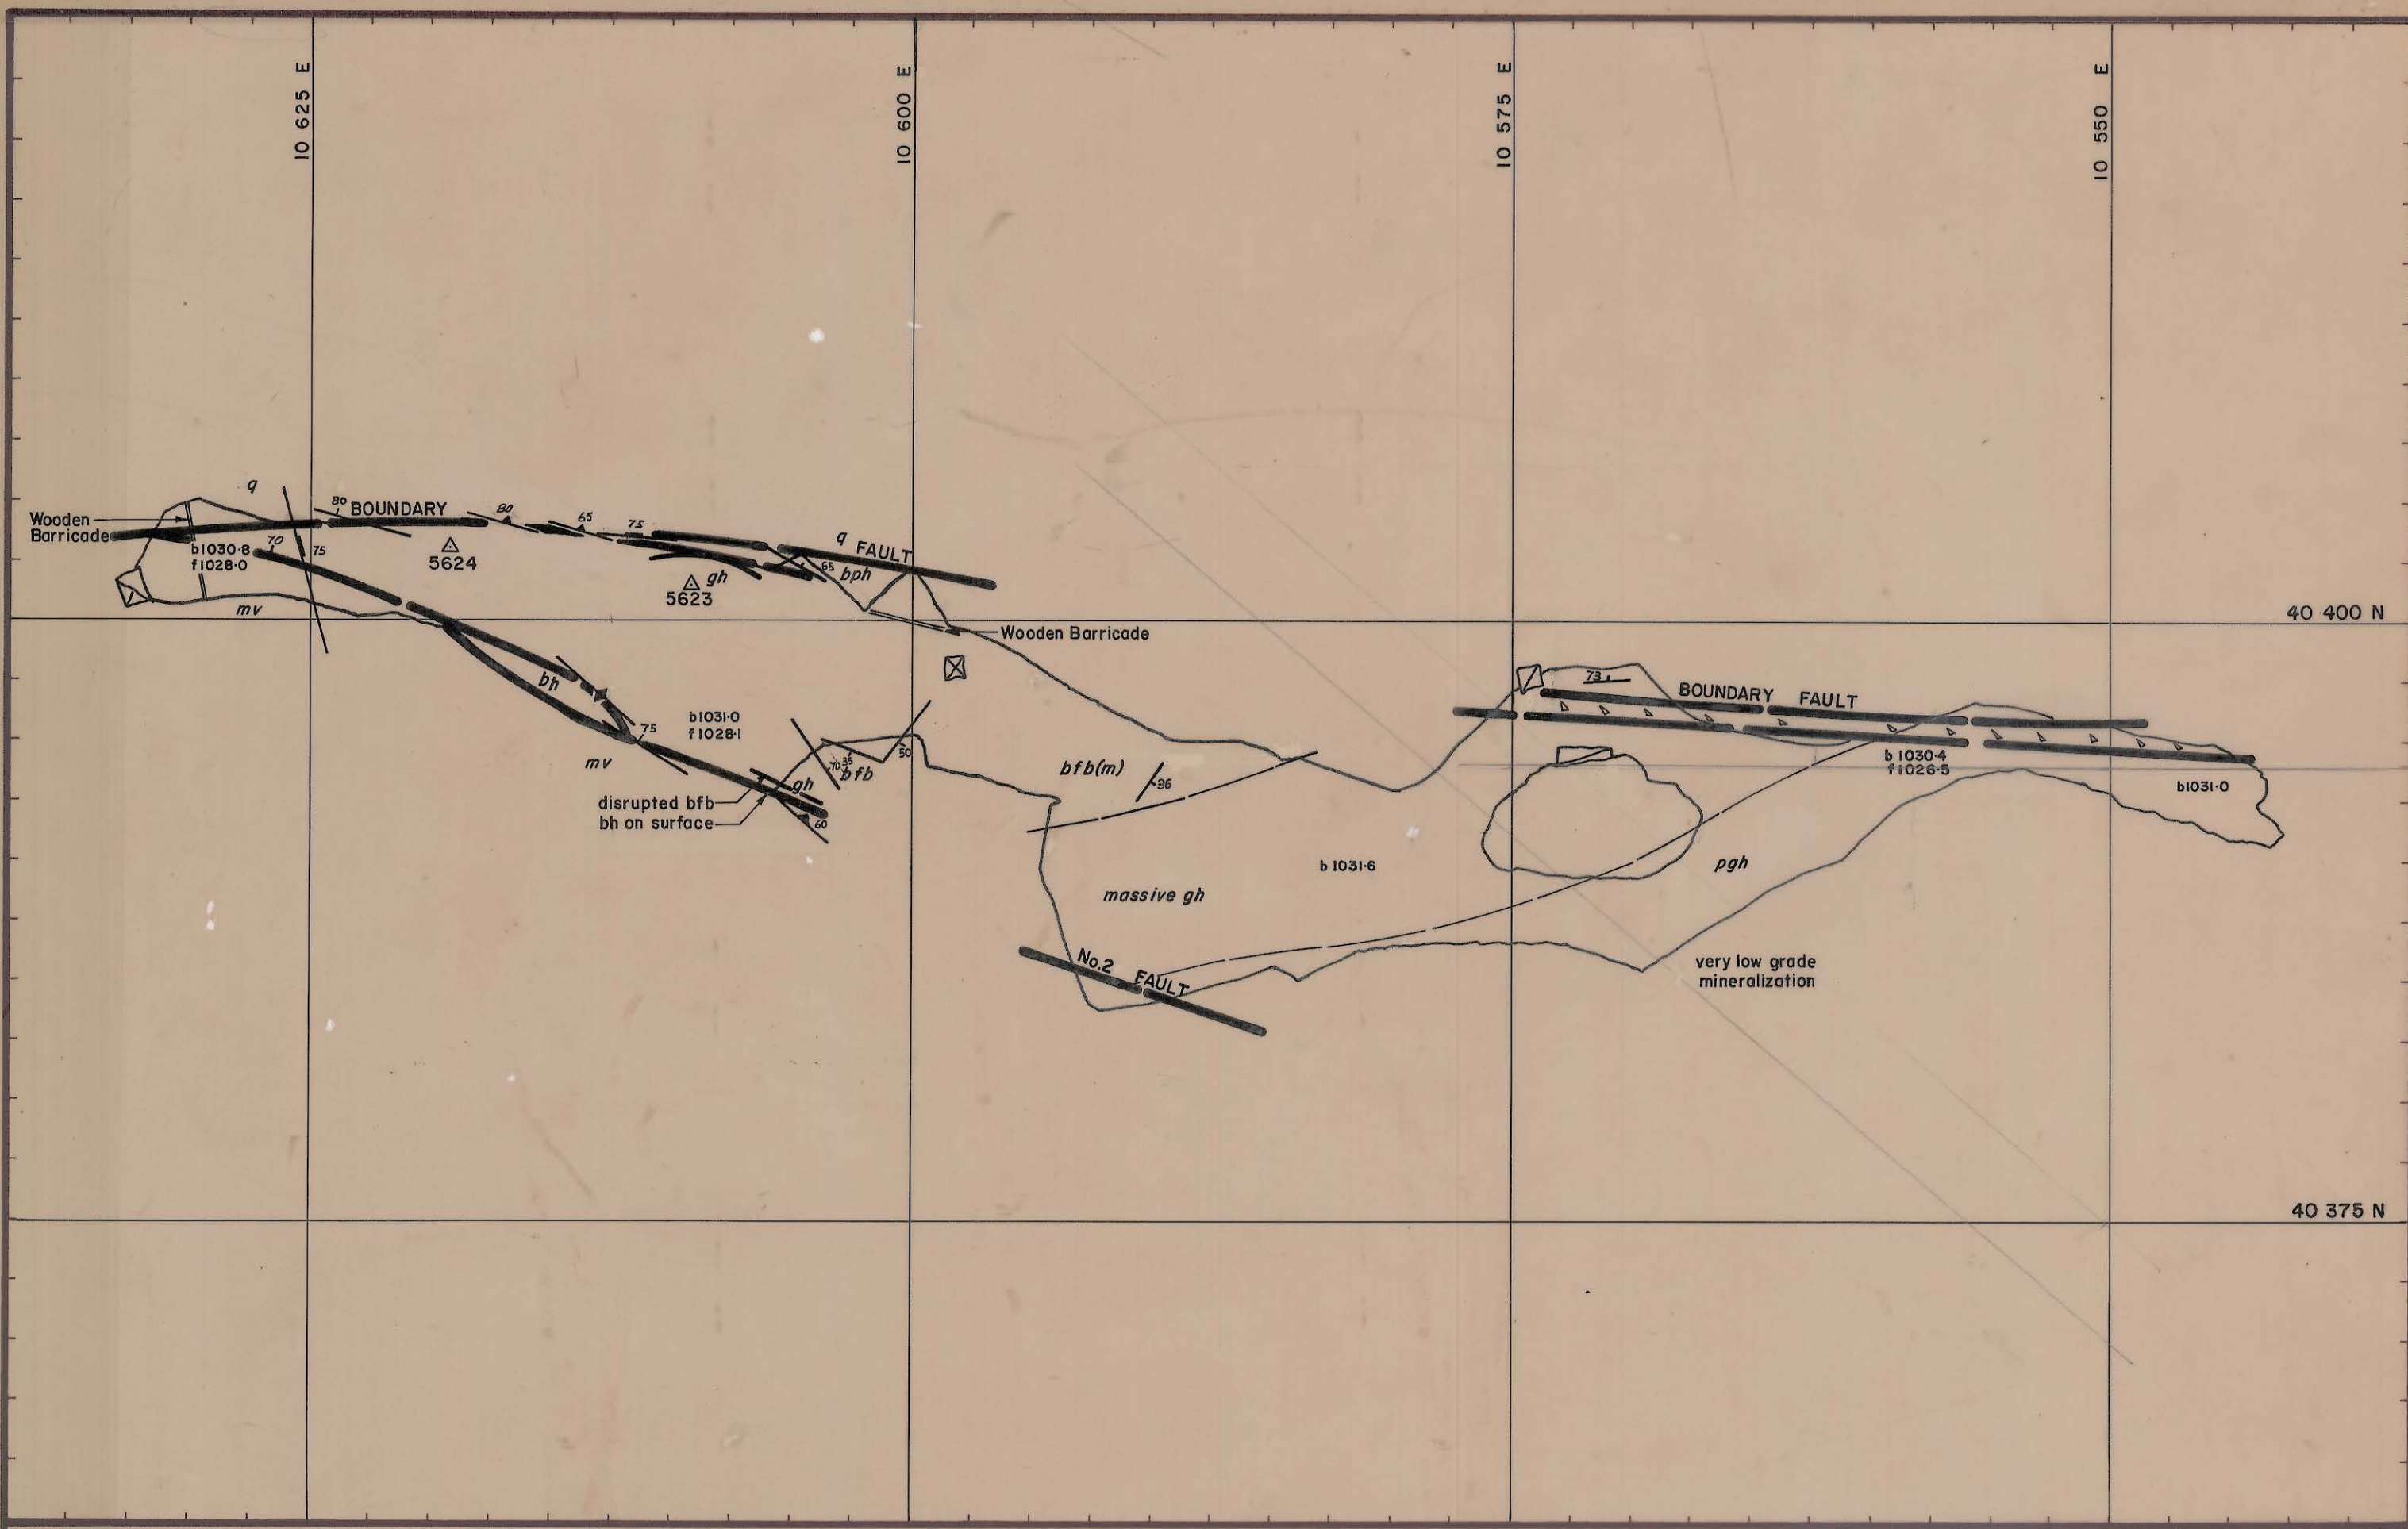

LEGEND:

DATE: Jan 78
Nov 78
GEOL: M.J.D. A.Y.
DWN: M.V.
CHKD:

GEOPEKO LIMITED
KING ISLAND
Scale: 1:250
N9 K
**BOLD HEAD OREBODY
P-57 STOPE
1st Lift**