


27 JUN 1981

P57 STOPE
UNDER CUT

0374_4813

5 cm

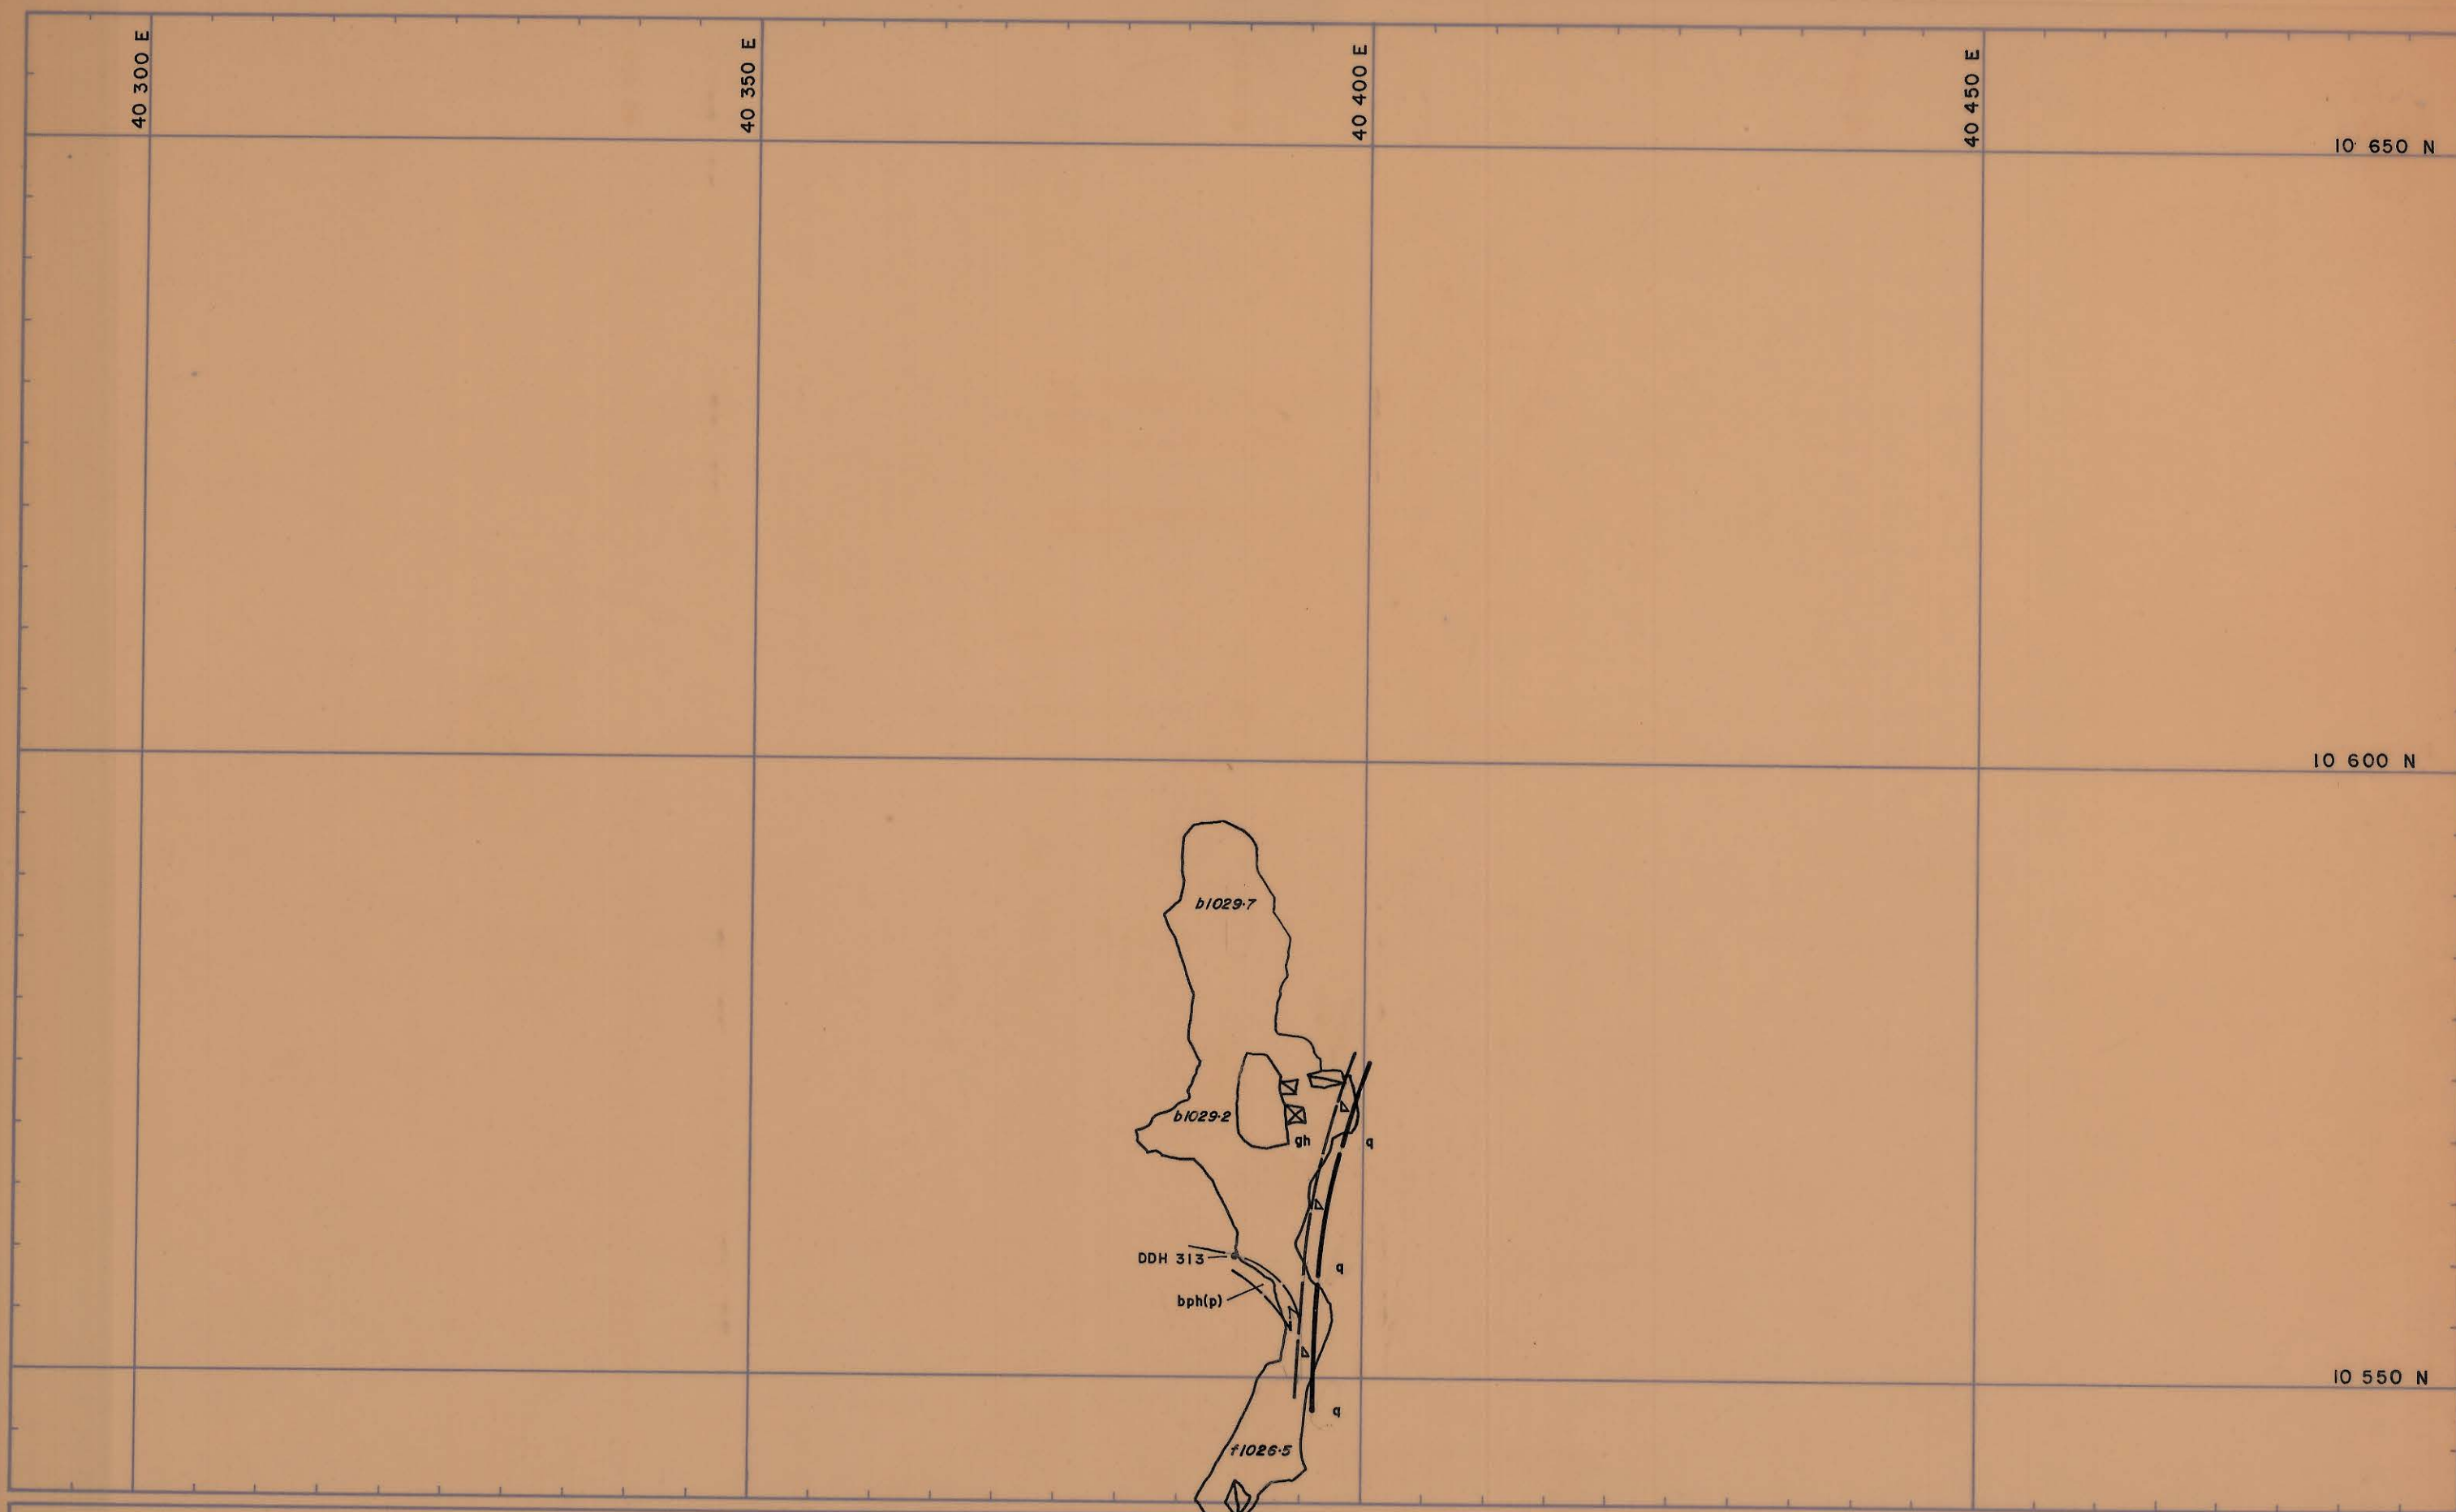

REF PLAN

GEOLOGY S.G.B

SURVEY

PLANNING

ROCK MEC.

GRADE CON.

DRAFTING M.vdS.

T.S.S.

SCALE 1:500

KIS KING ISLAND SCHEELITE
GRASSY KING ISLAND

BOLD HEAD MINE

P 57 STOPE

Under Cut

DRAWING NUMBER