


27 JUN 1981

C WEST
H59 1st Lift

0374_4816

5 cm

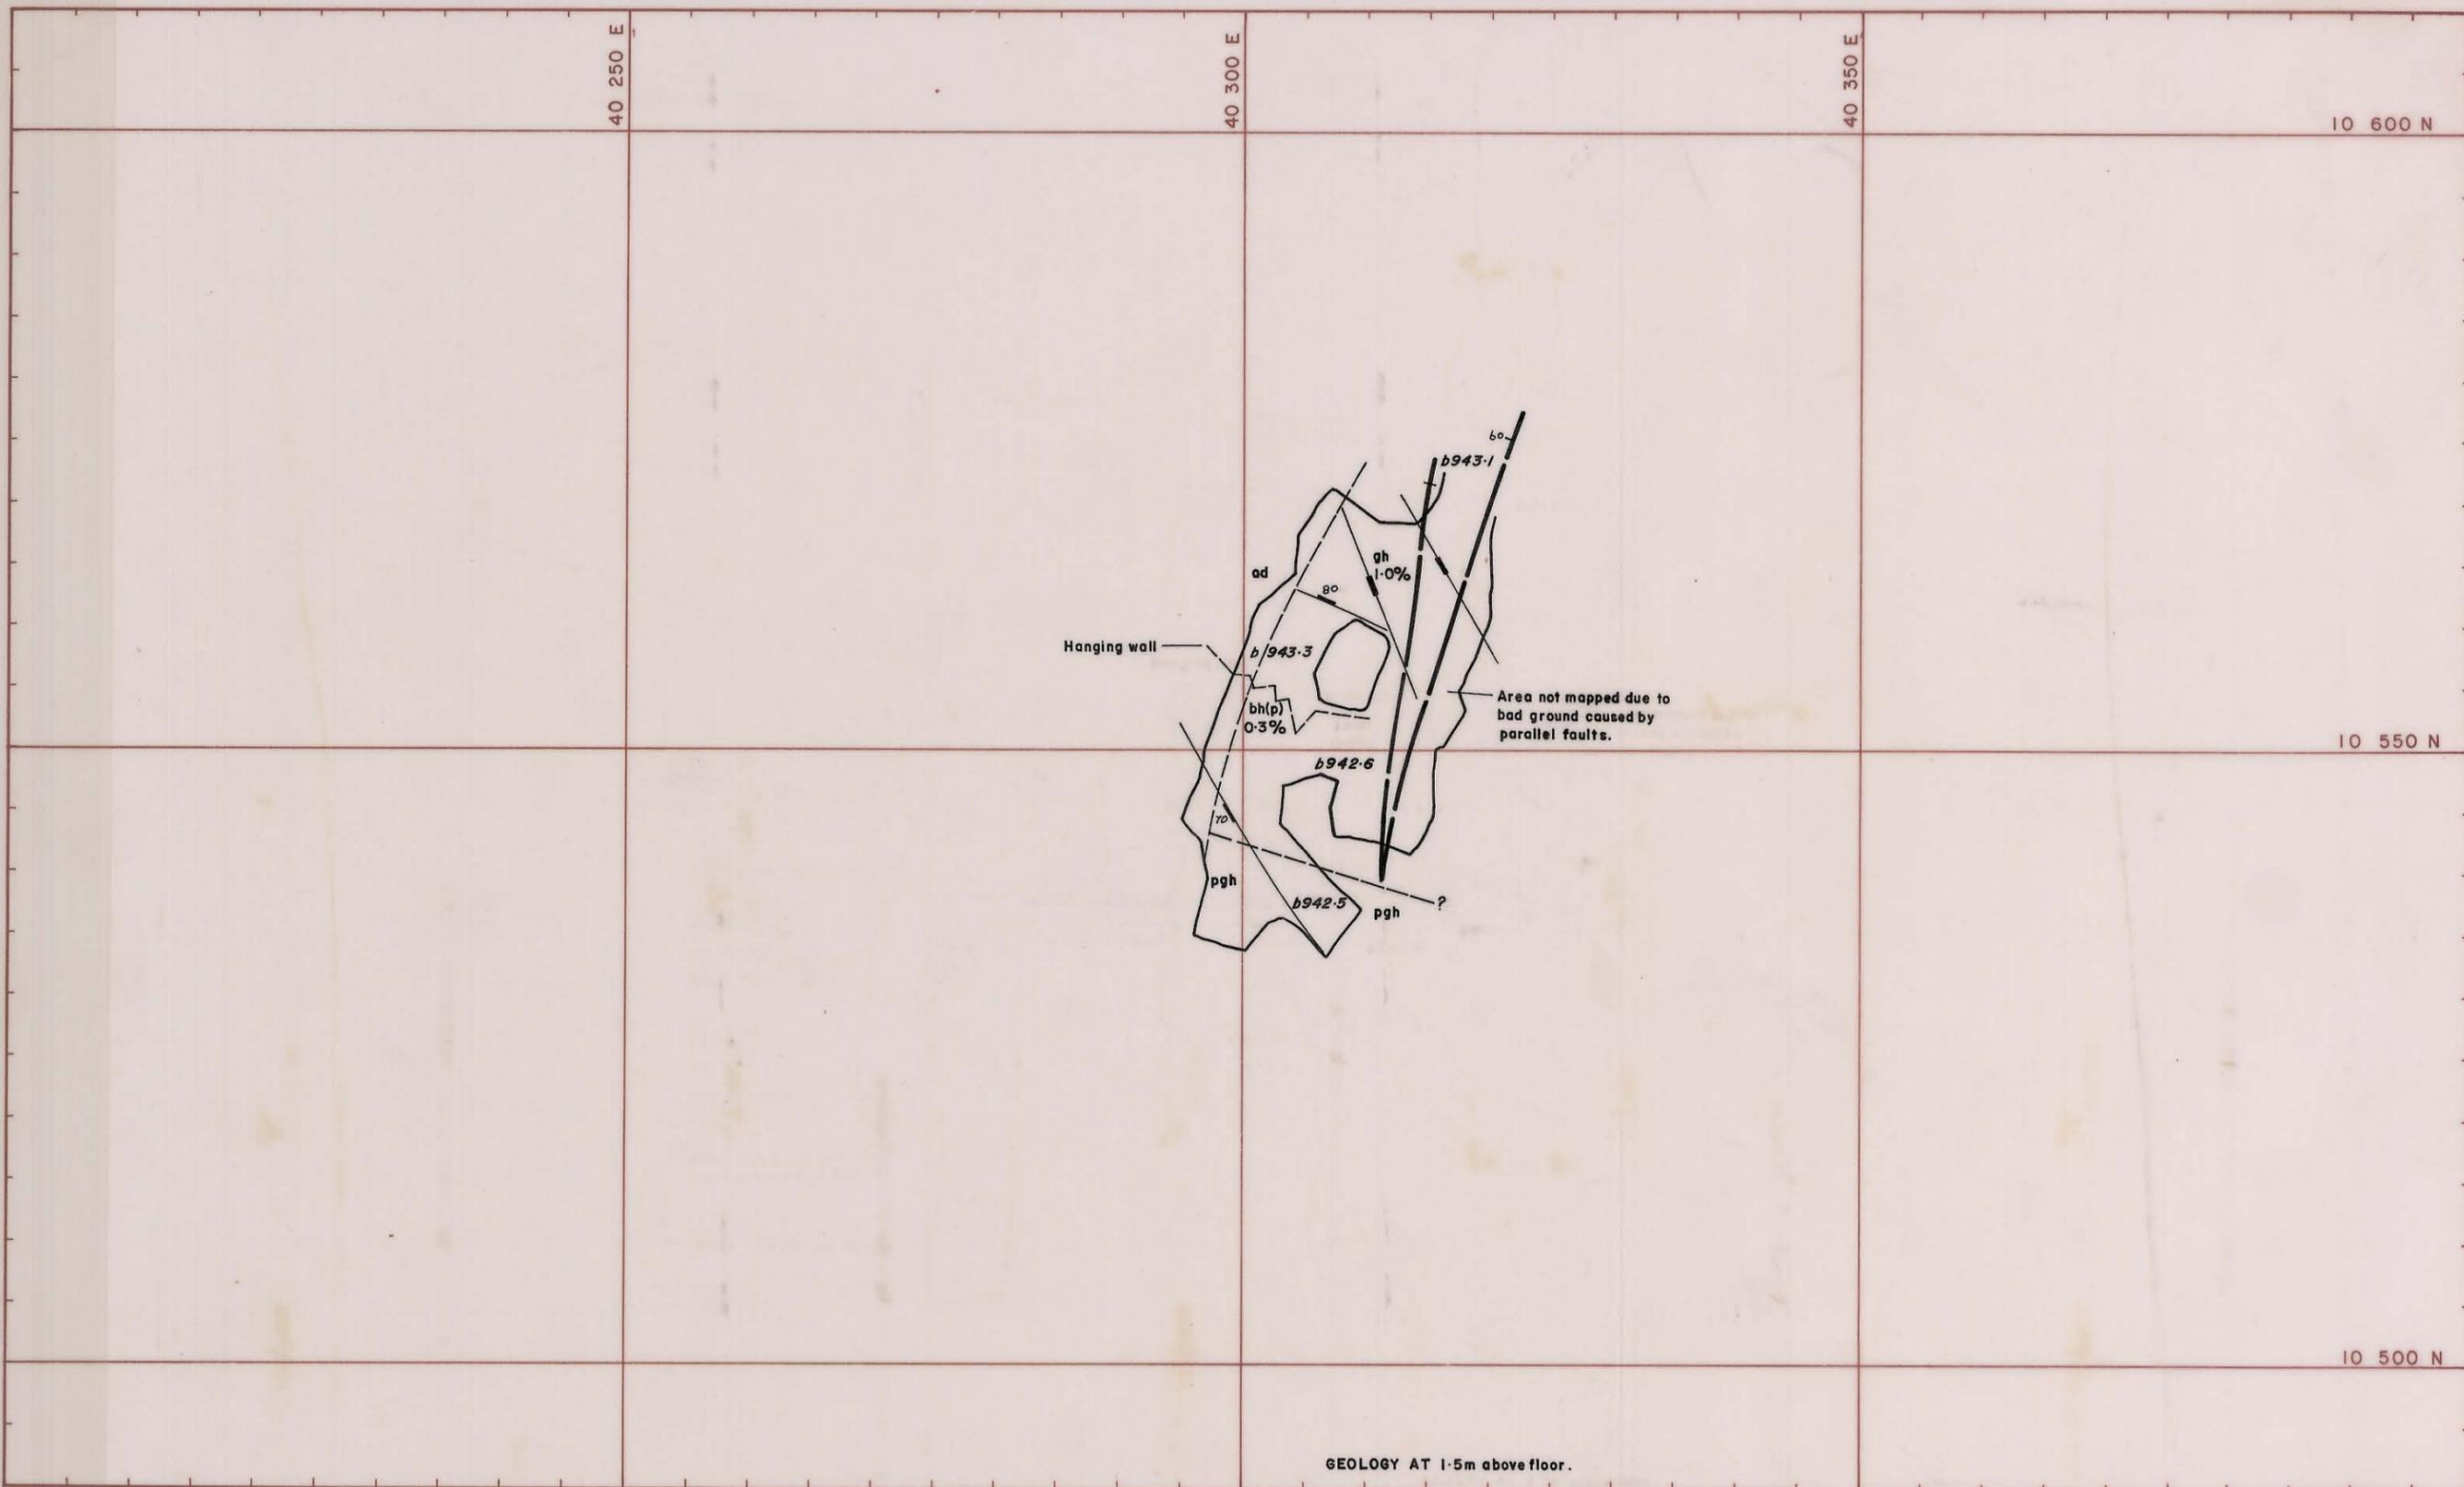

GEOLOGY AT 1.5m above floor.

REF. PLAN	GEOLOGY	T. F. P.	SCALE 1:500
	SURVEY		
	PLANNING		
	ROCK MEC.		
	GRADE CON.		
DRAFTING	M.vdS.	BOLD HEAD MINE C West H59 -1st Lift DRAWING NUMBER	
T.S.S.			