

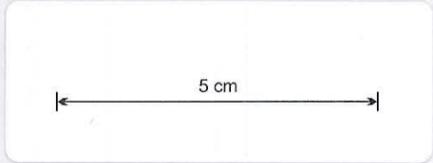


P70 STOPE  
5<sup>th</sup> LIFT

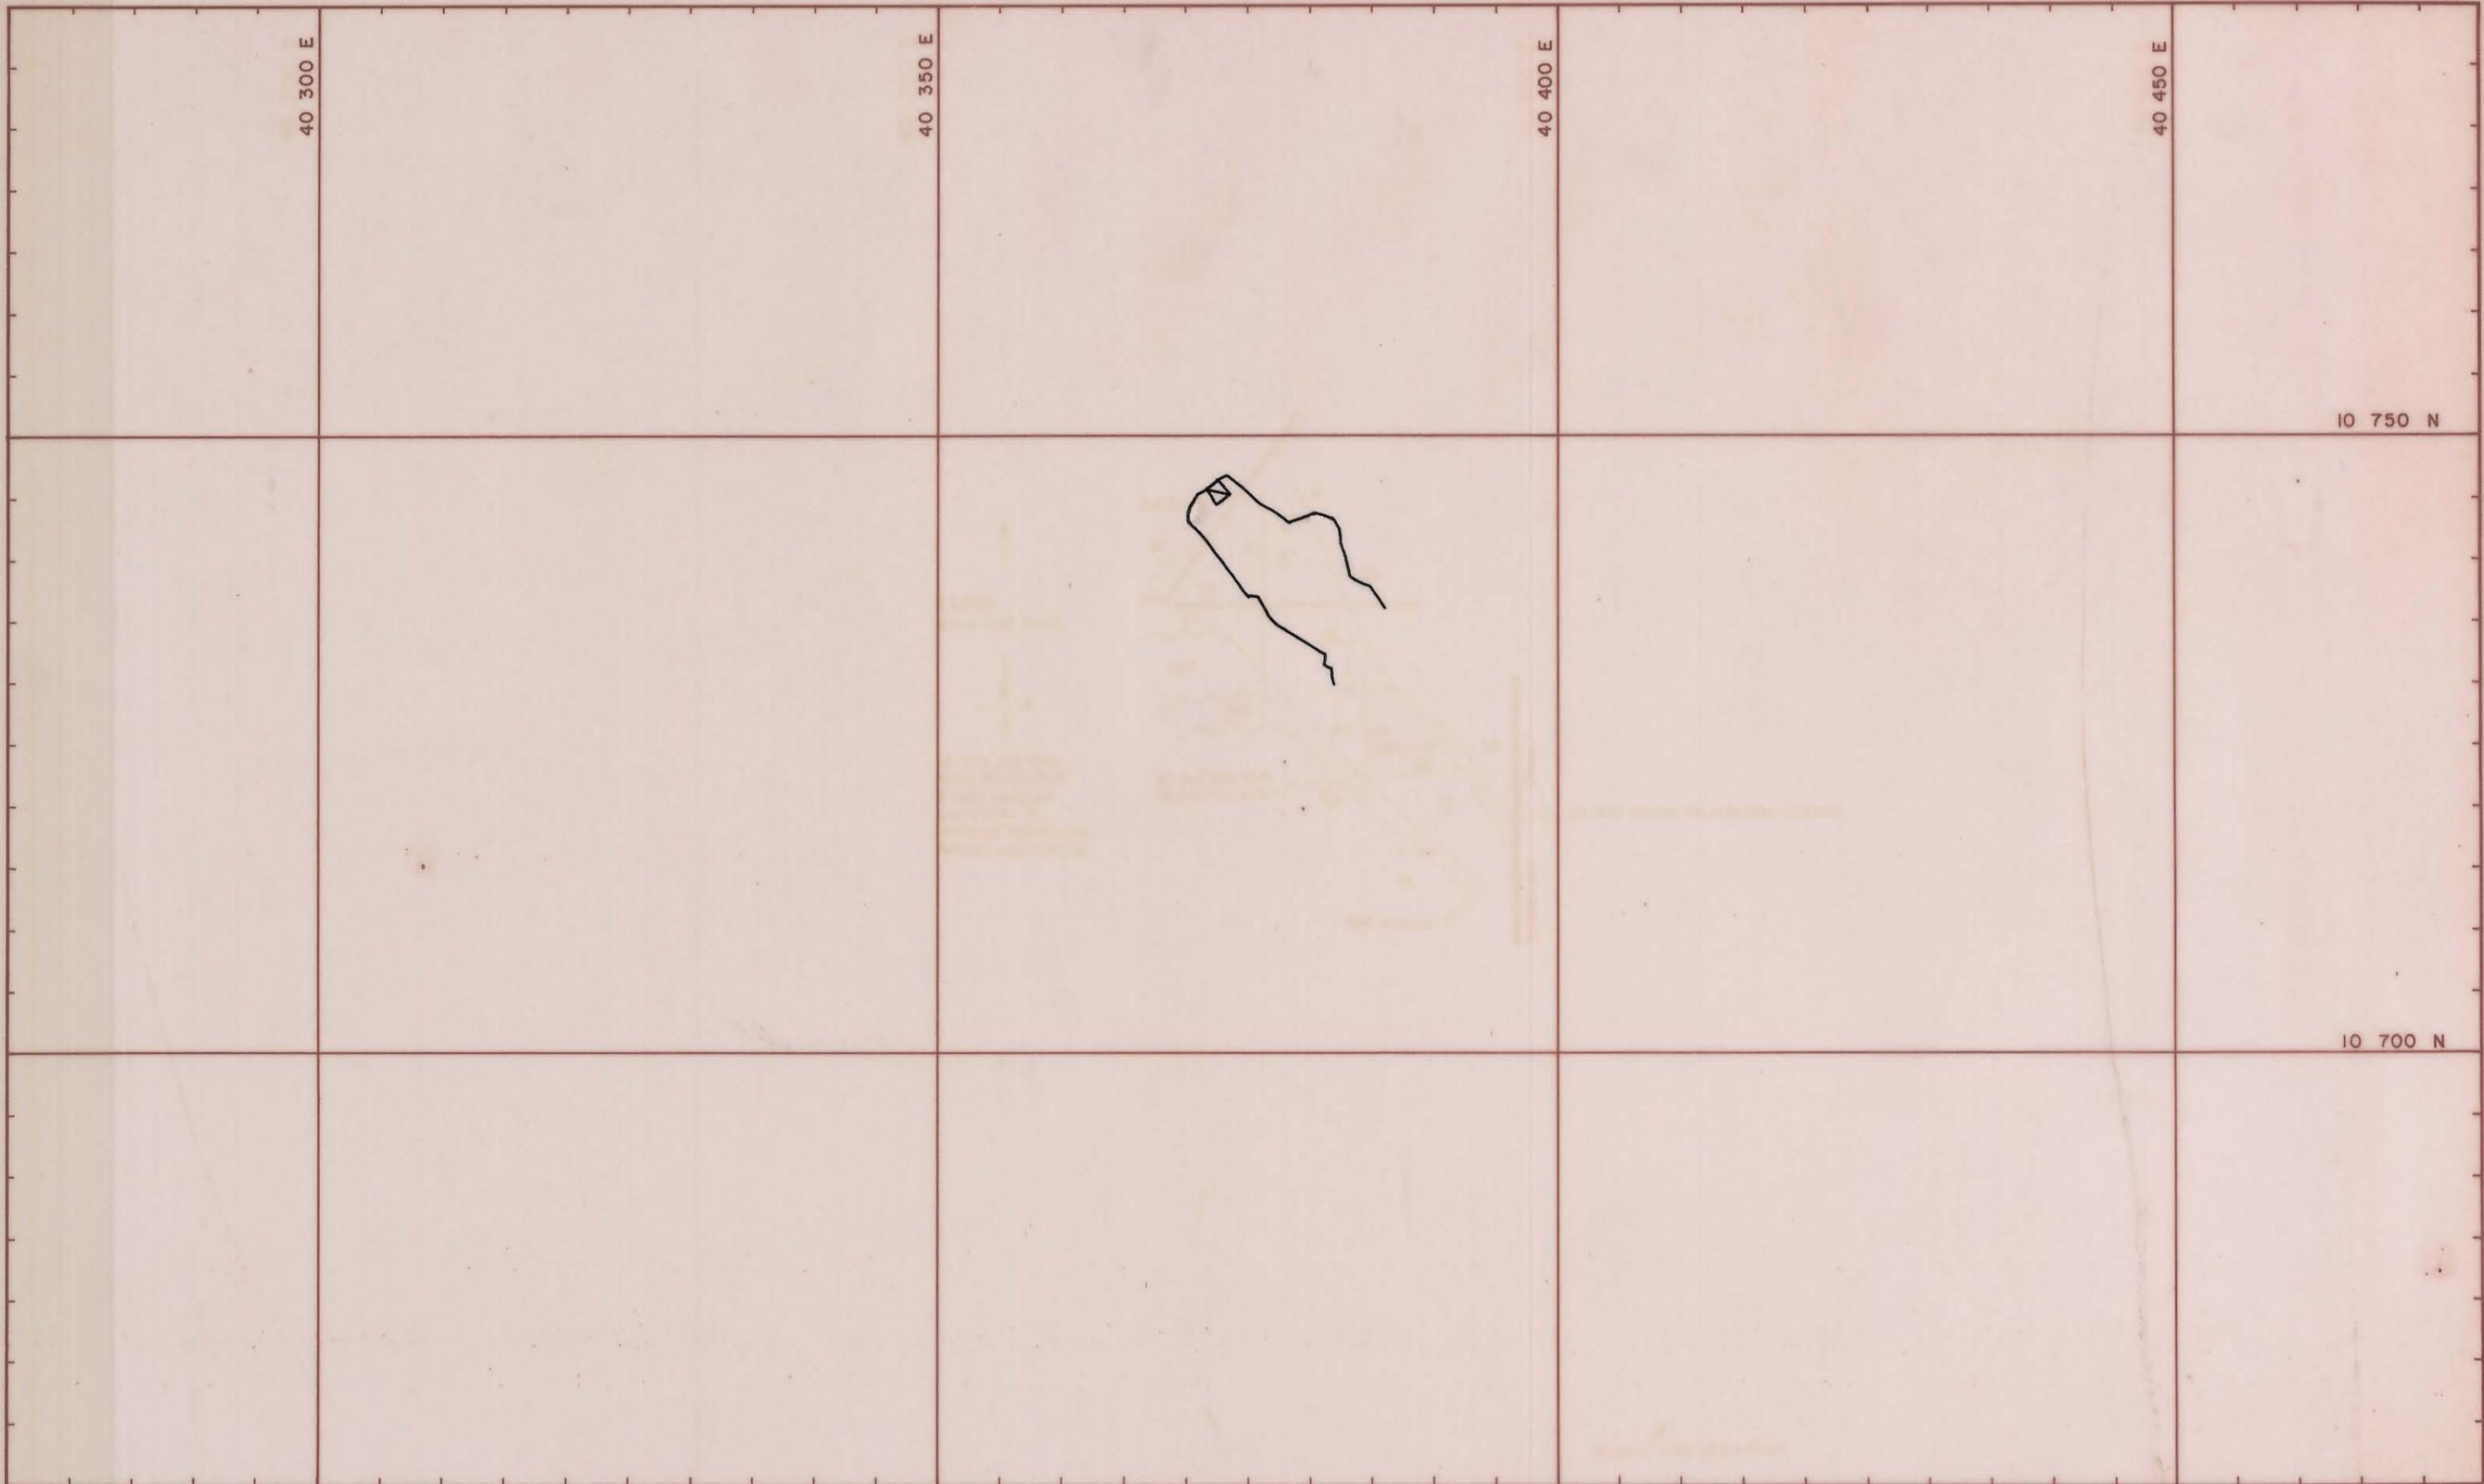

0374\_4820

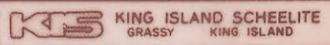

REF. PLAN	GEOLOGY			SCALE 1:500	
	SURVEY				
	PLANNING				
	ROCK MEC.				
	GRADE CON.				
	DRAFTING	M.vdS.			
T.S.S.				DRAWING NUMBER	

BOLD HEAD MINE  
P70 STOPE  
5<sup>th</sup> Lift