


0374-4825

Dolphin Mine Geological Level Plan
-150m R.L.
No K62-06-031

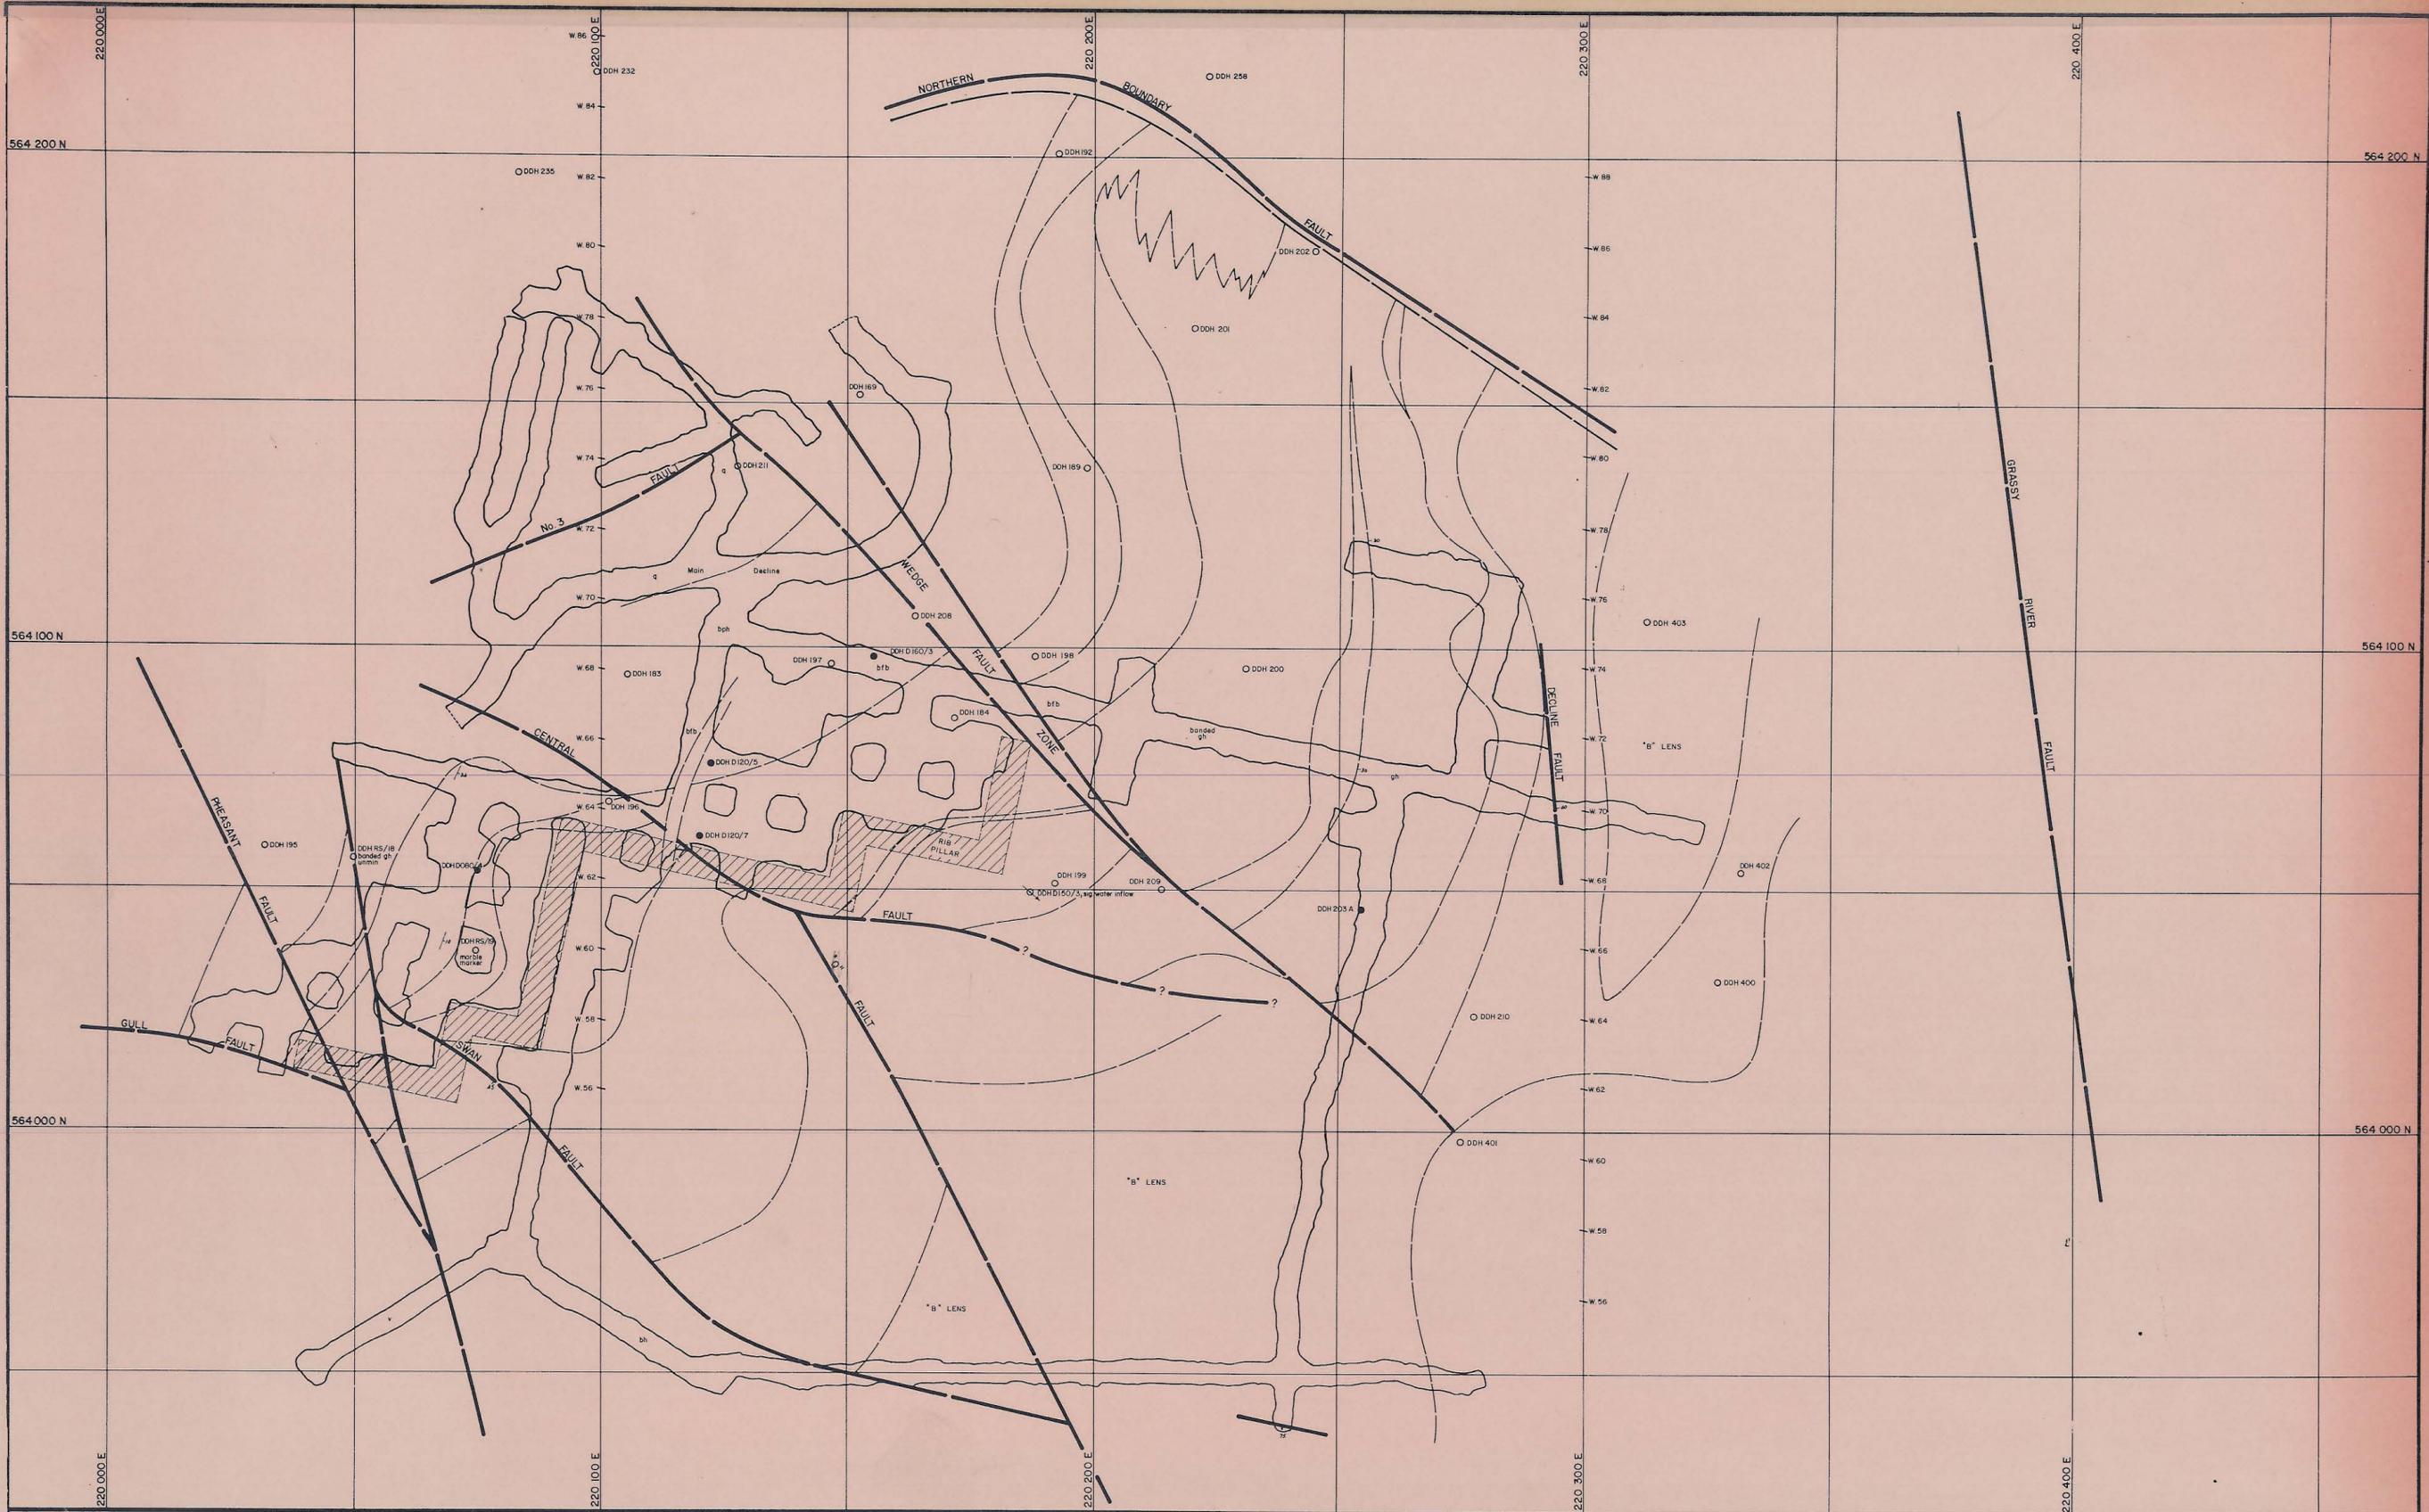

LEGEND	
	Upper metavolcanics
	Banded hornfels
	Marble
	Biotite hornfels
	Pyroxene garnet hornfels
	Garnet hornfels
	Banded footwall beds
	Biotite pyroxene hornfels
	Lower metavolcanics
	Quartzite
	Aplite
	Strike and dip
	Joint, inclined
	Joint, vertical
	Fault
	Wedge area, Section W 68 intercept

DATE:
GEOLOGIST: M.J.D.
DRAWN: R.F.
CHECKED: M.C.R.

GEOPEKO LIMITED
KING ISLAND GROUP

SCALE: 1:100 000

No. K62-06-031

DOLPHIN MINE
GEOLOGICAL LEVEL PLAN
-150m R.L.