


27 JUN 1981


P70 STOPE
1st or Undercut

5 cm

0374_4827

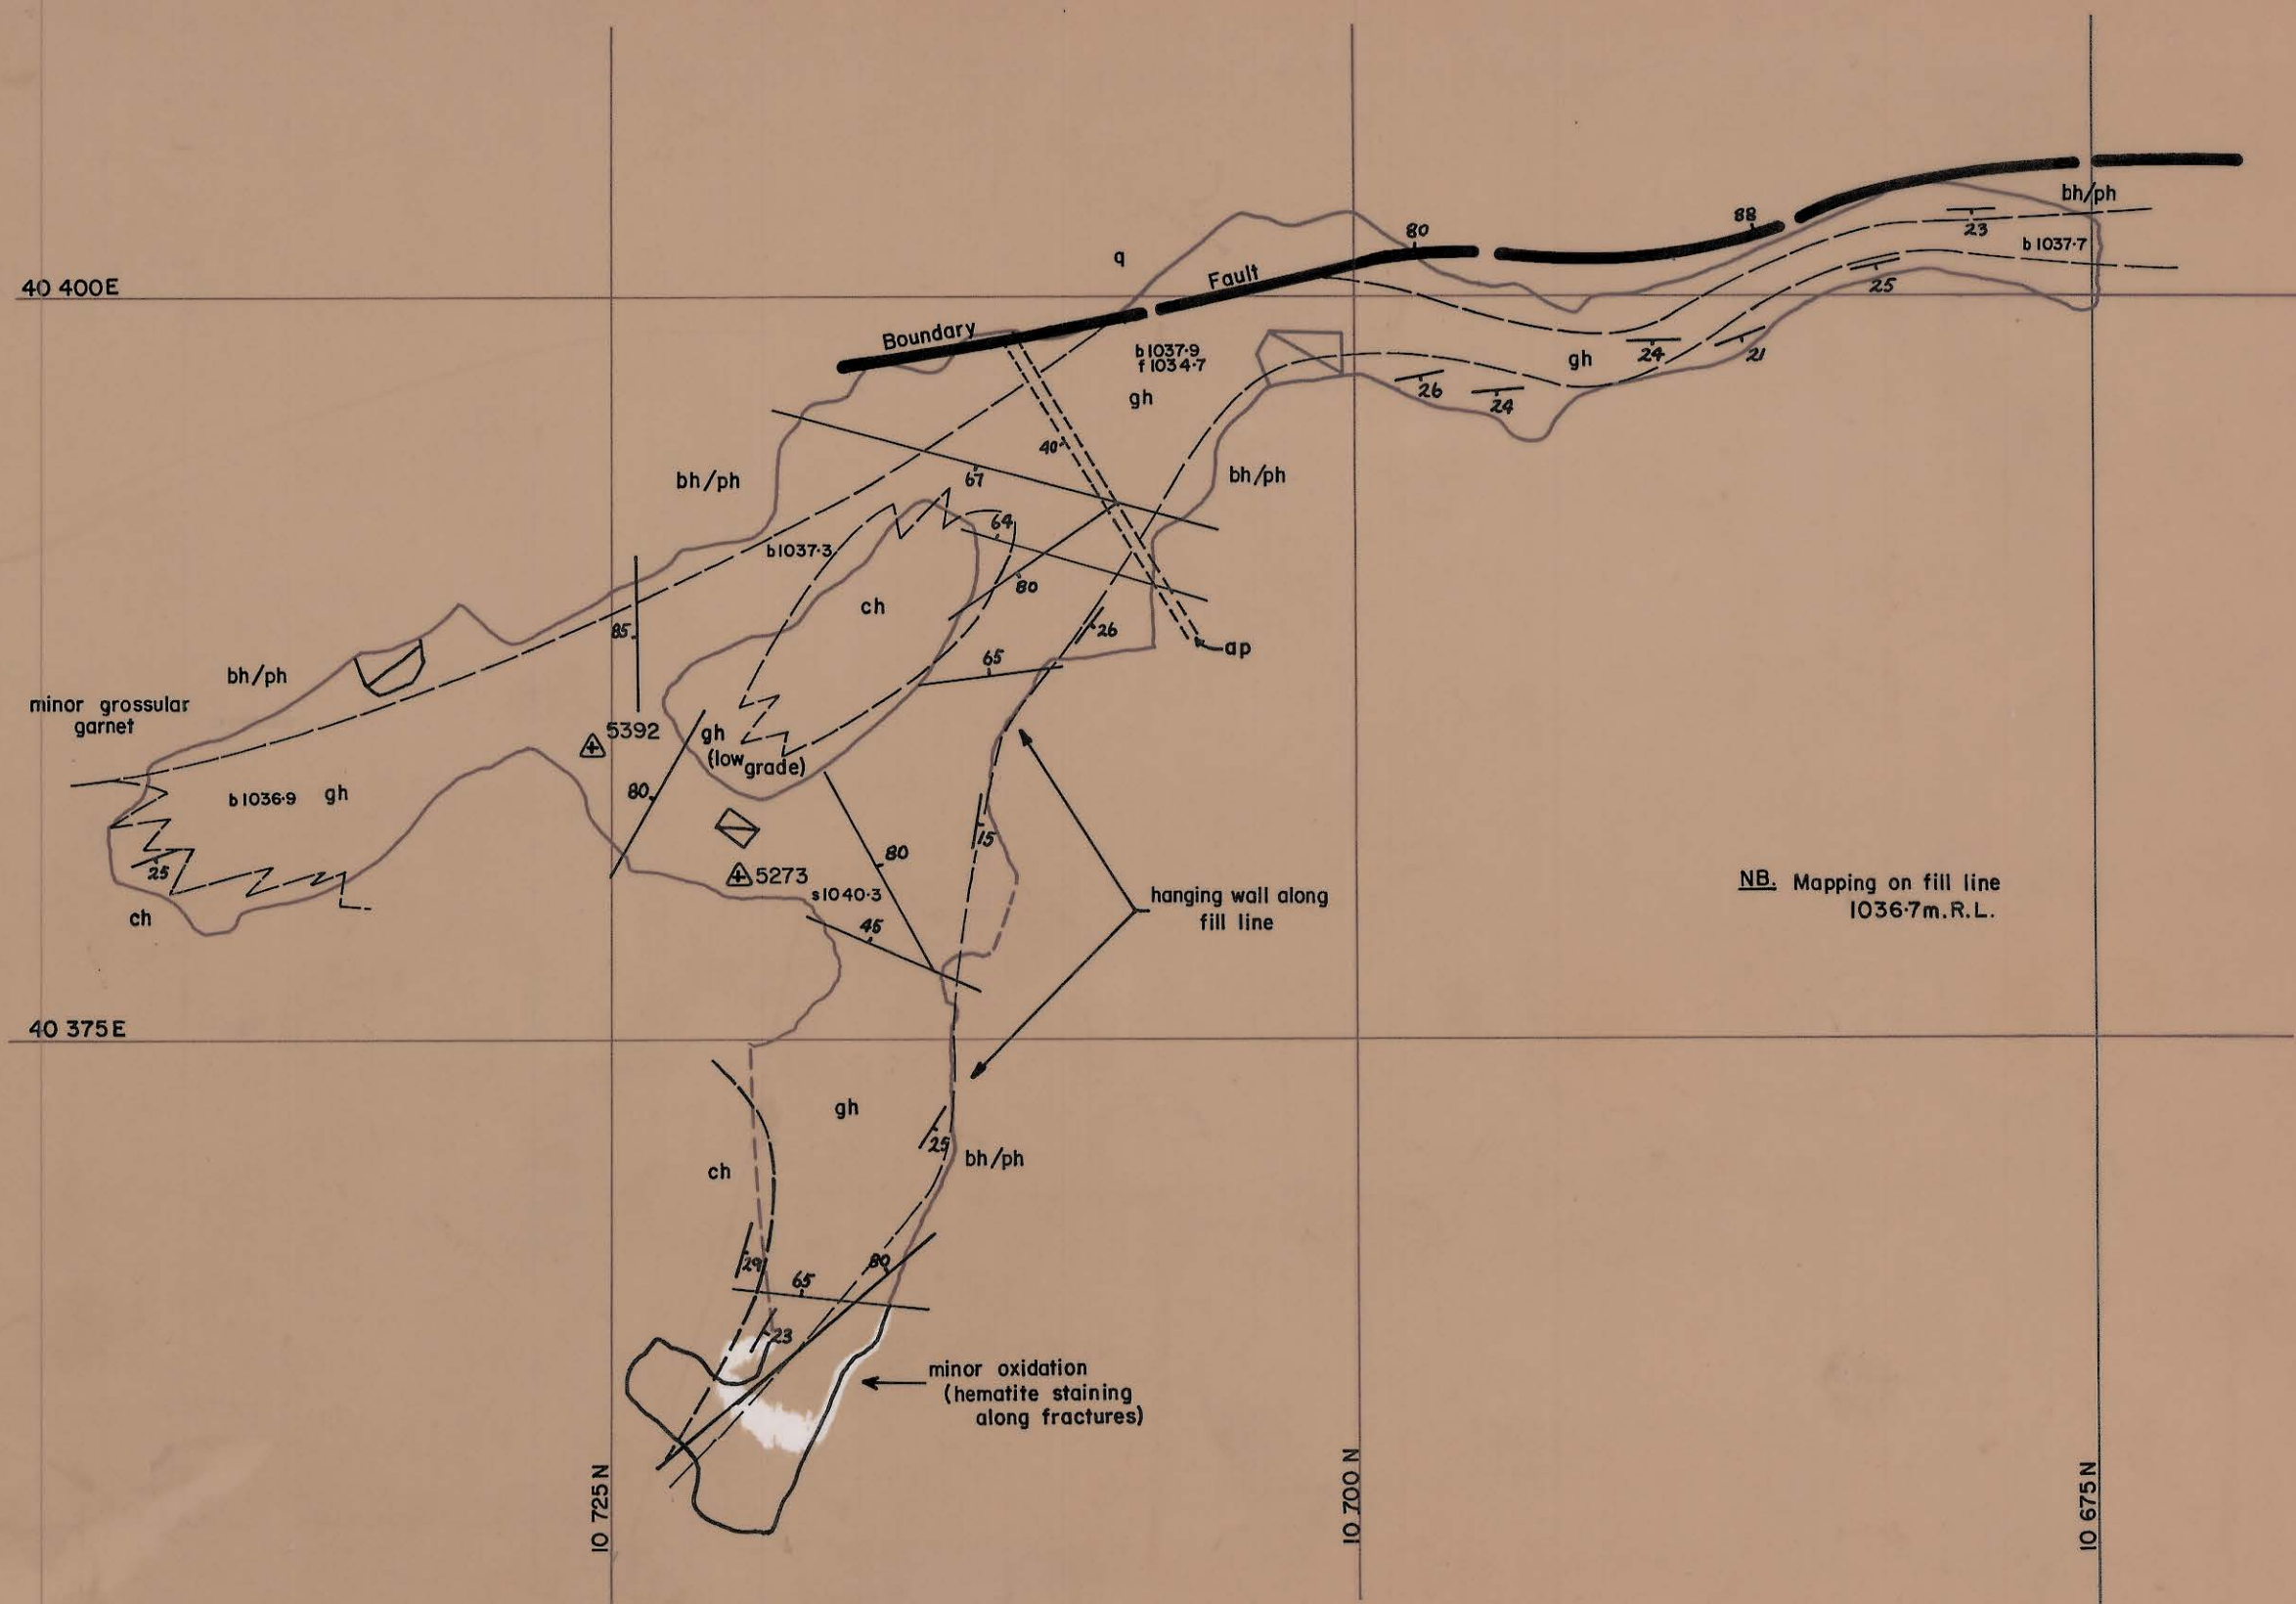

LEGEND:

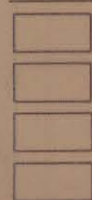

DATE: Jan.78
GEOL: J.C.
DWN: C.T.
CHKD:

GEOPEKO LIMITED
KING ISLAND

Scale: 1:250

Nº K

BOLD HEAD MINE
P-70 Stope
Undercut 1036.7m.R.L.