


0374\_4830

5 cm

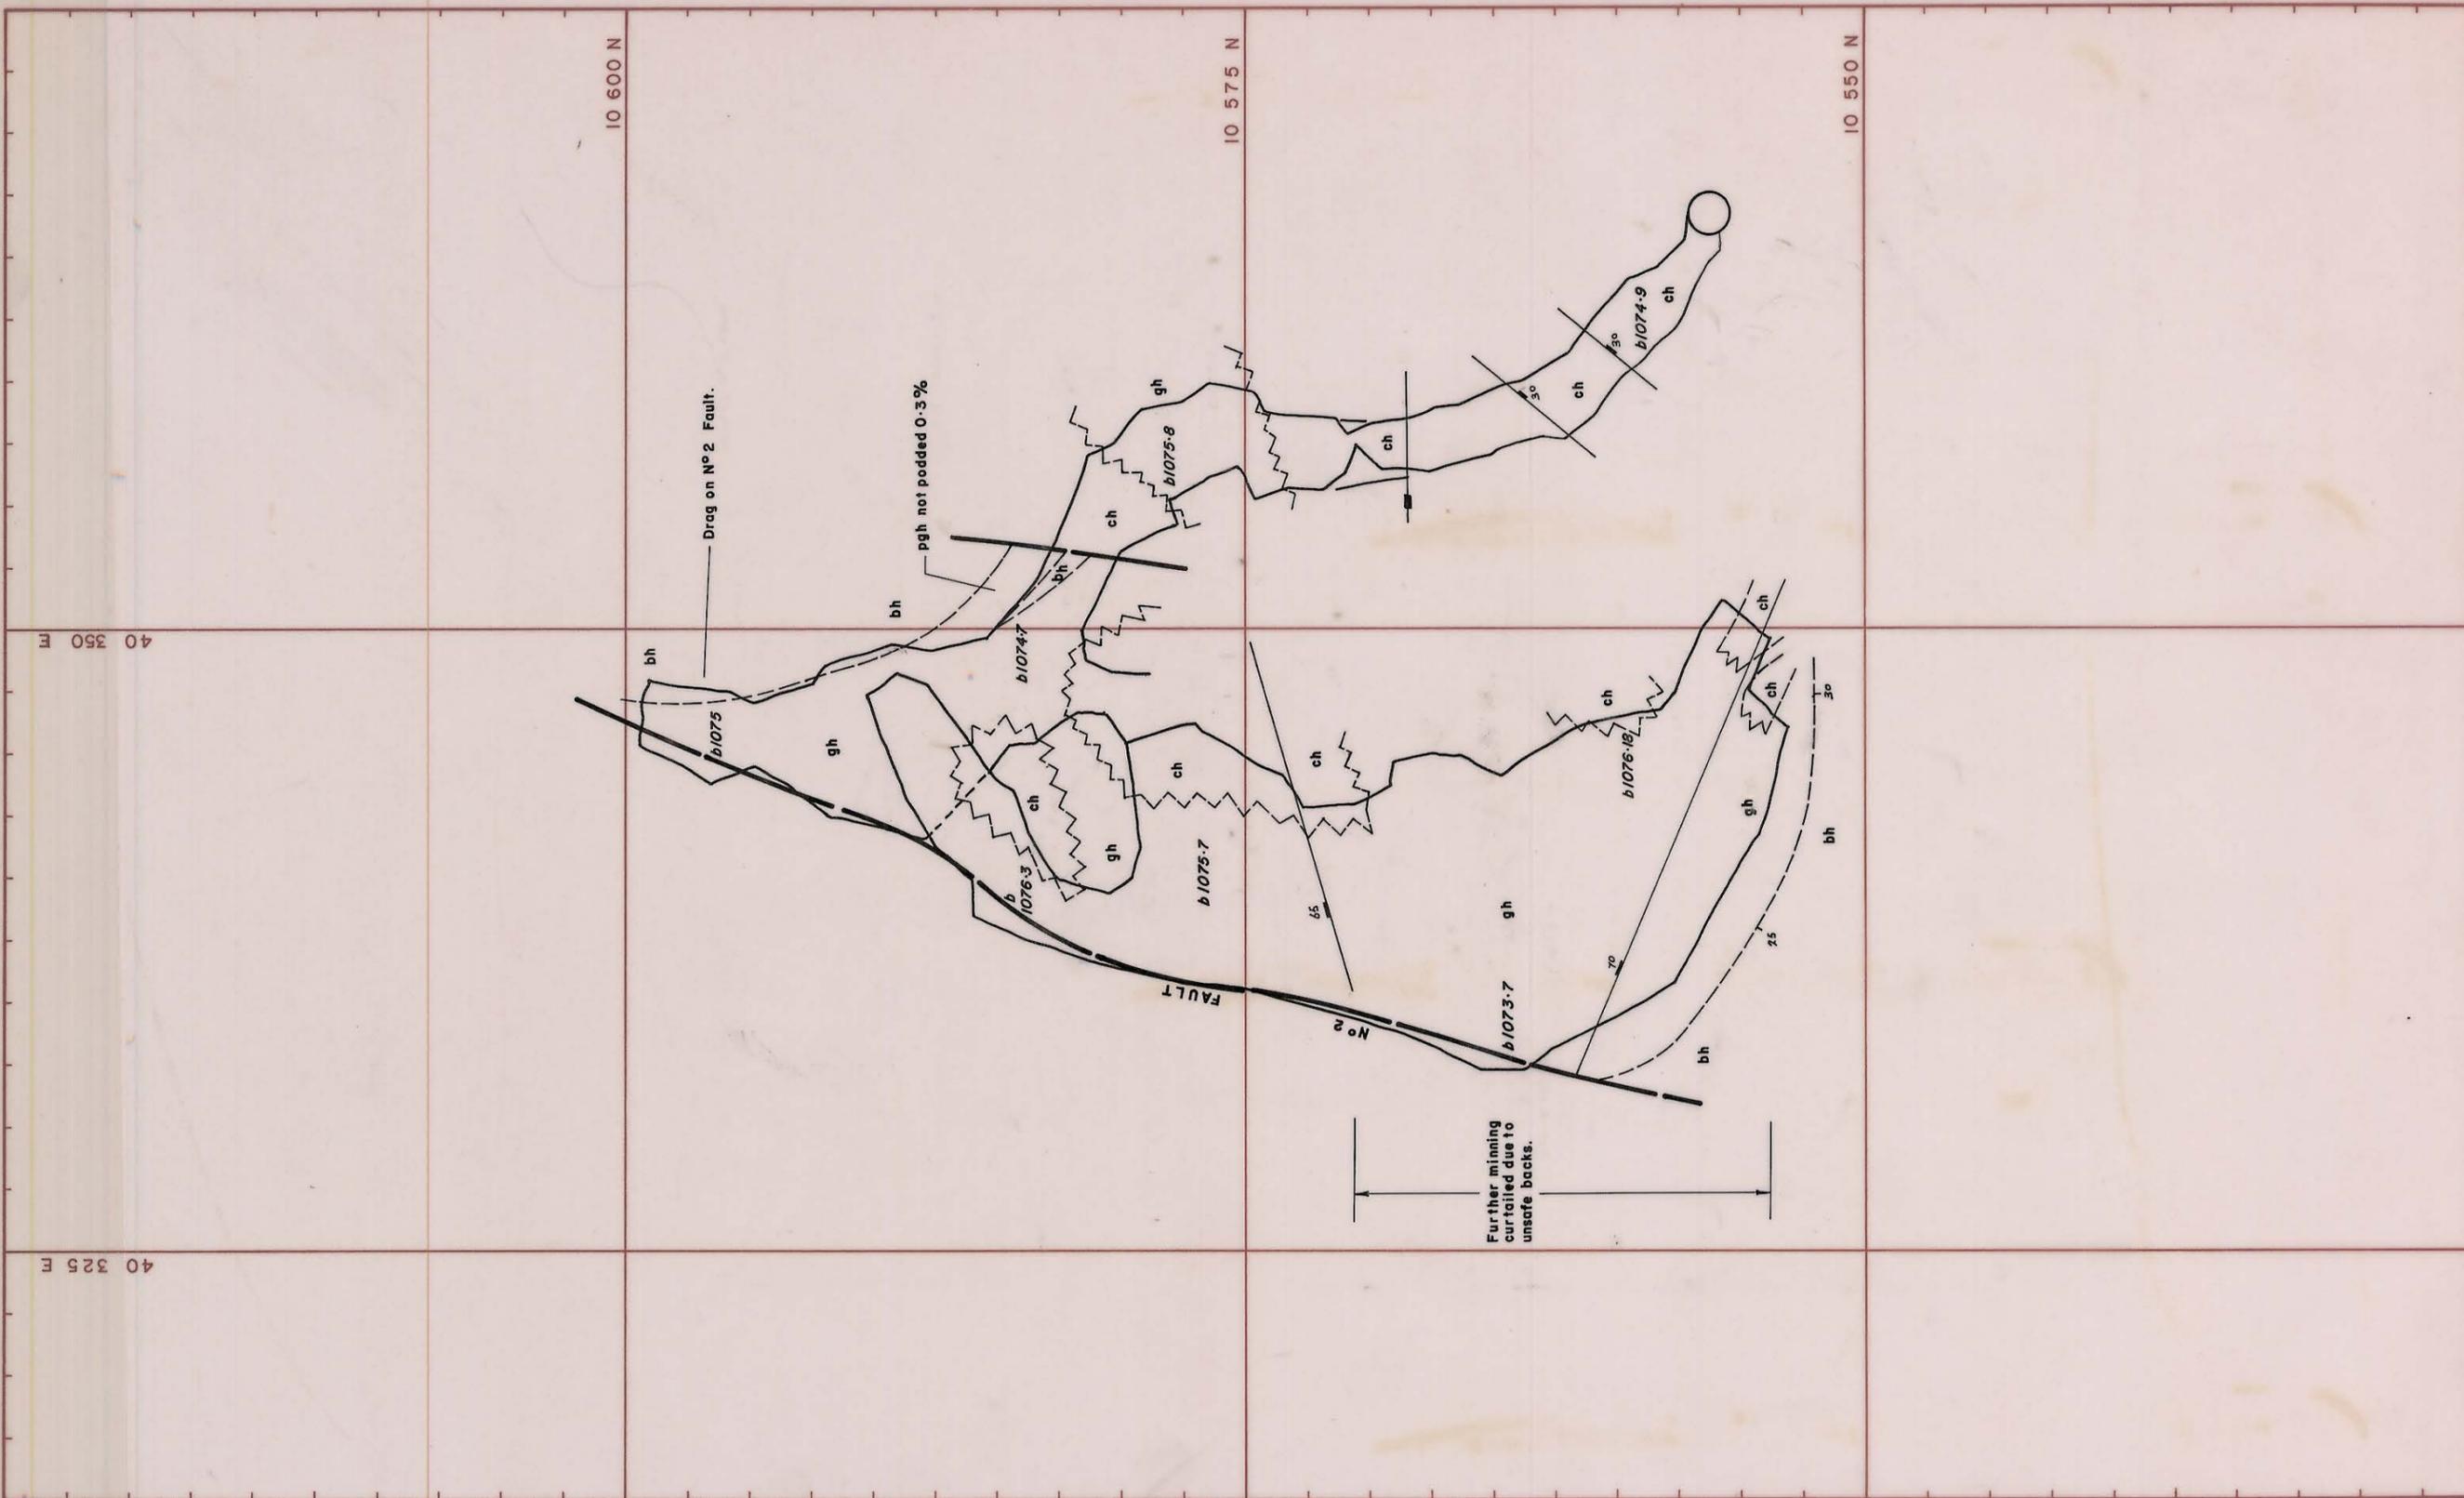

REF PLAN	GEOLOGY	T.F.P.	May '81	SCALE 1:500	
	SURVEY				
	PLANNING			<b>BOLD HEAD MINE</b> <b>H50 STOPE</b> <b>12<sup>th</sup> Lift</b>	
	ROCK MEC.				
	GRADE CON.				
	DRAFTING	M.vdS.			
	T.S.S.			DRAWING NUMBER	