



27 JUN 1981

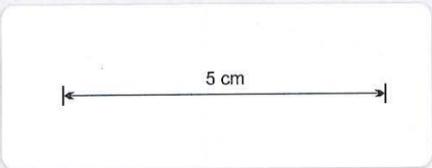


0374_4833

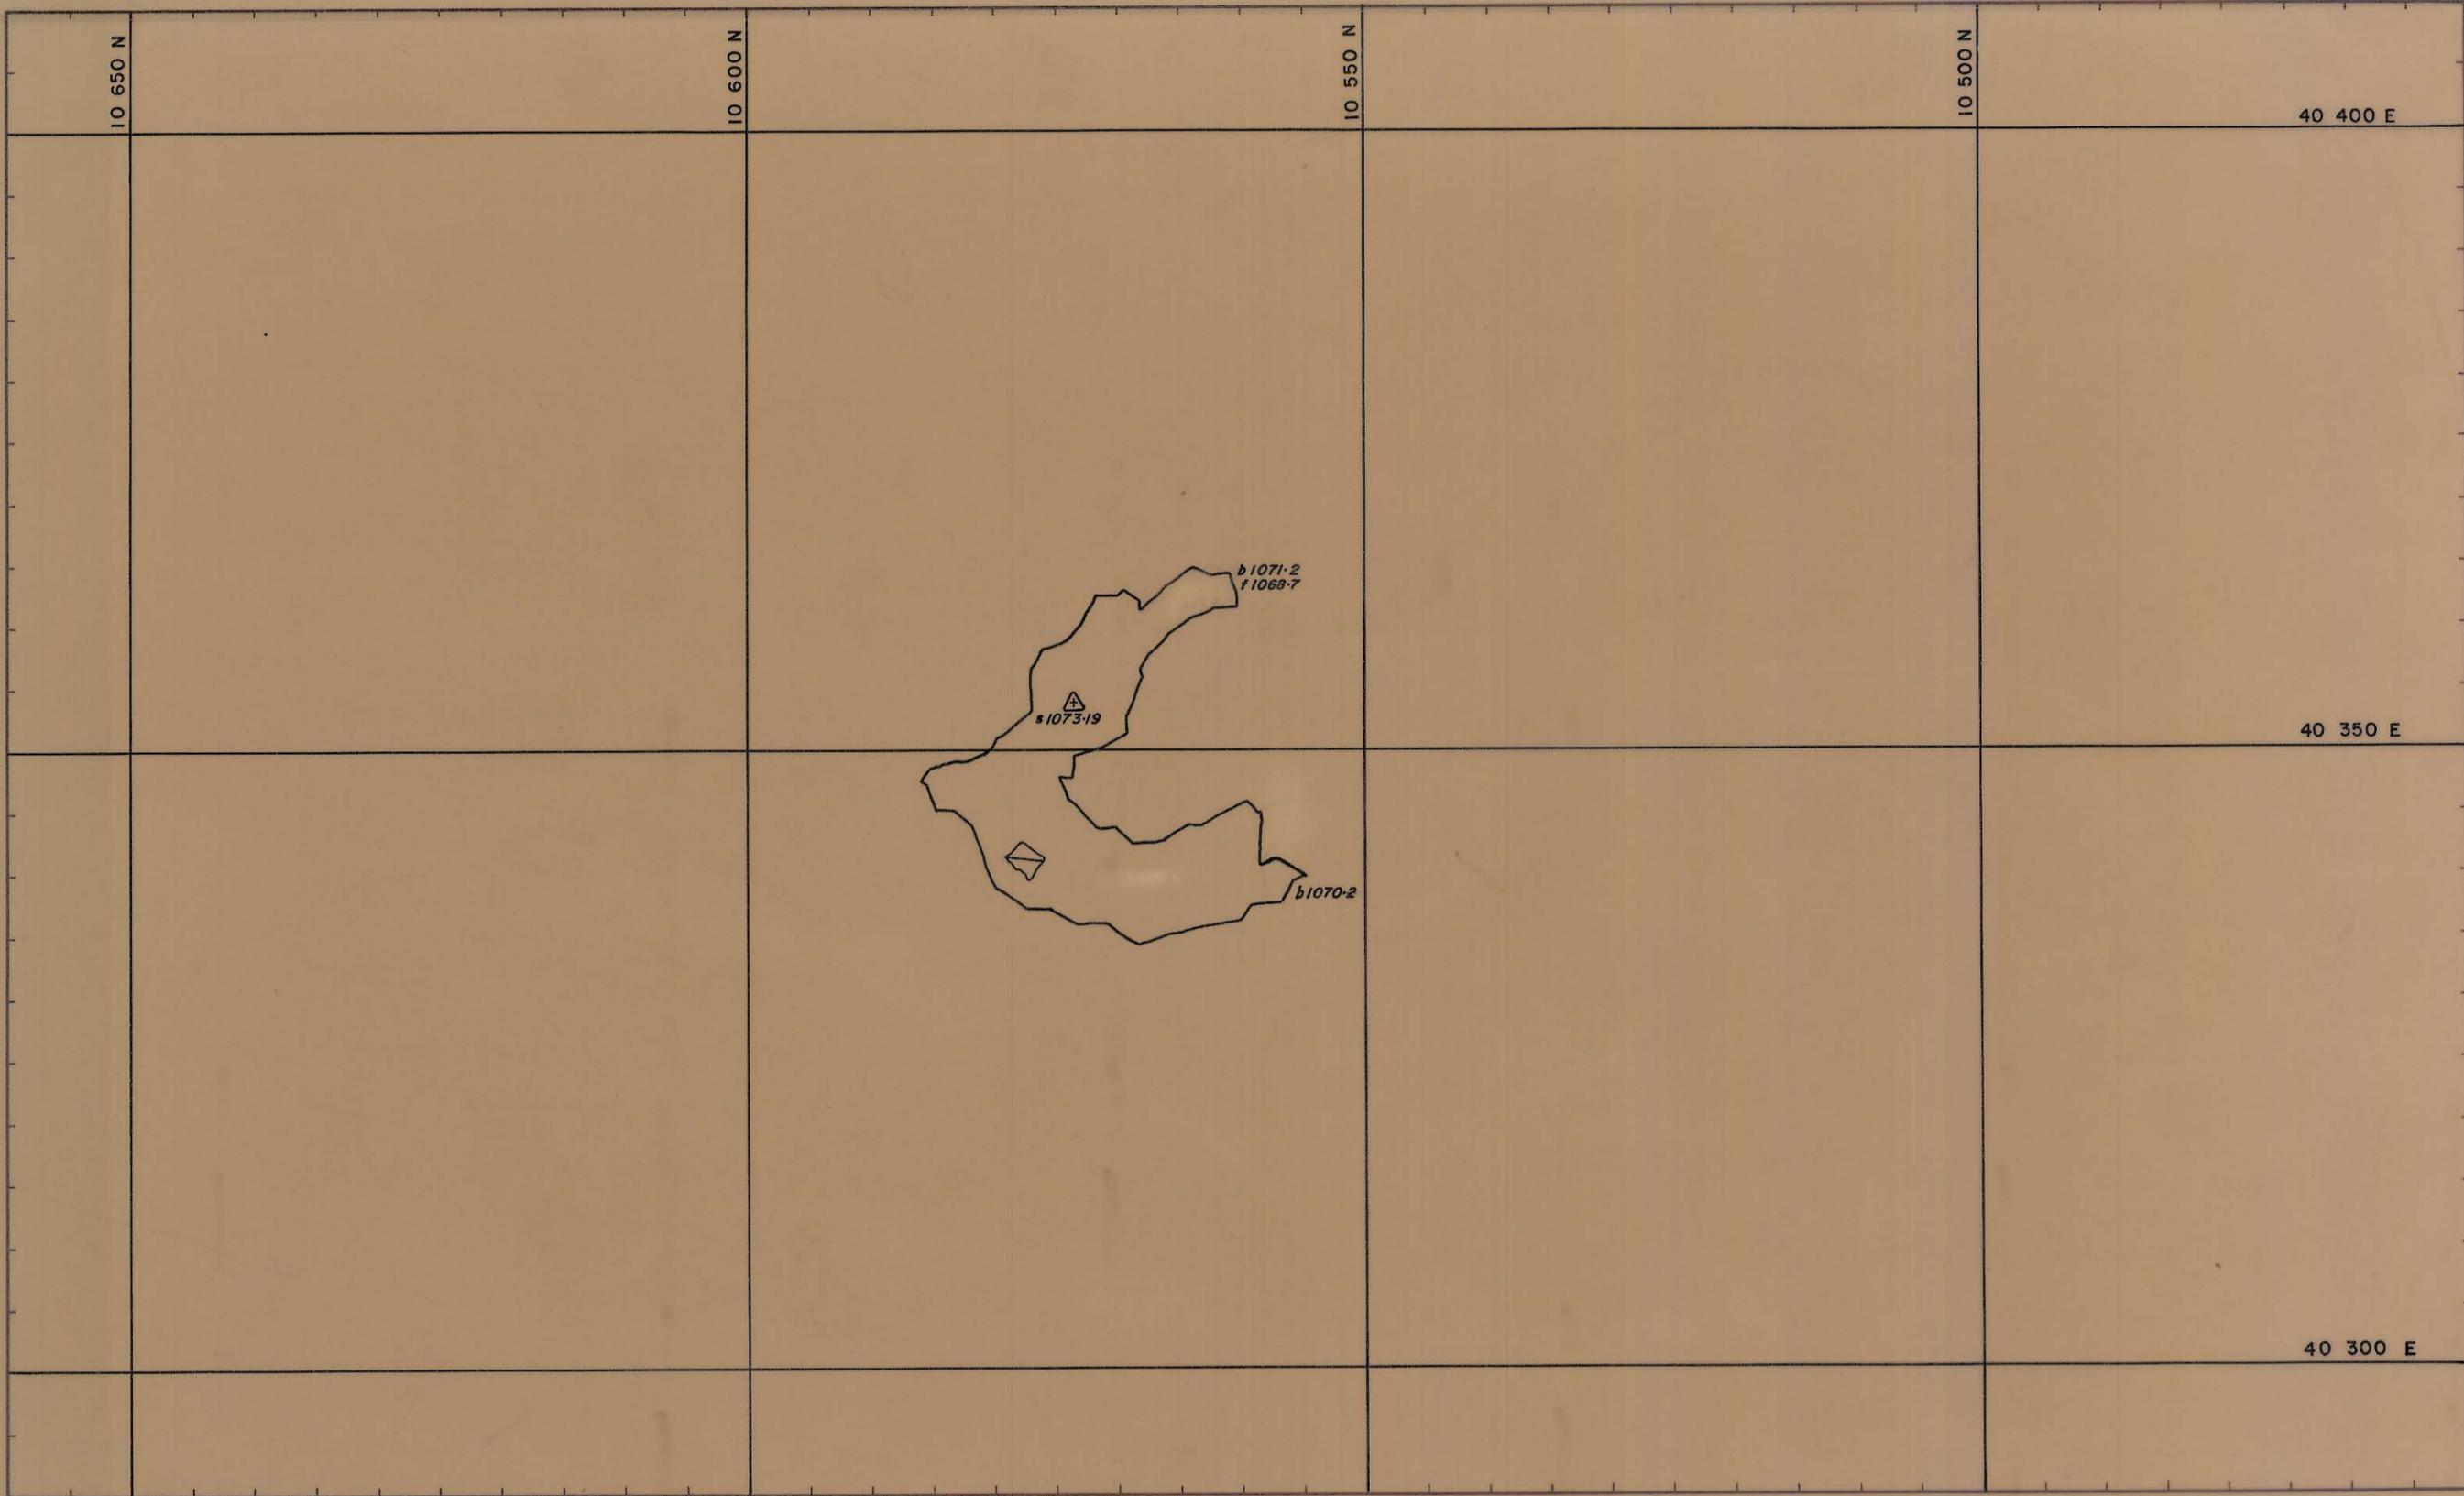

REF PLAN 04 BH15-1029

GEOLOGY	T.F.P.	
SURVEY		
PLANNING		
ROCK MEC.		
GRADE CON.		
DRAFTING	M.vdS.	
T.S.S.		

SCALE 1:500

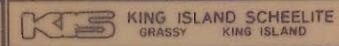

BOLD HEAD MINE
H50 A LENS CAVO STOPE 10th Lift

DRAWING NUMBER