


27 JUN 1981

H50 STOPE
5th LIFT



0374_4839

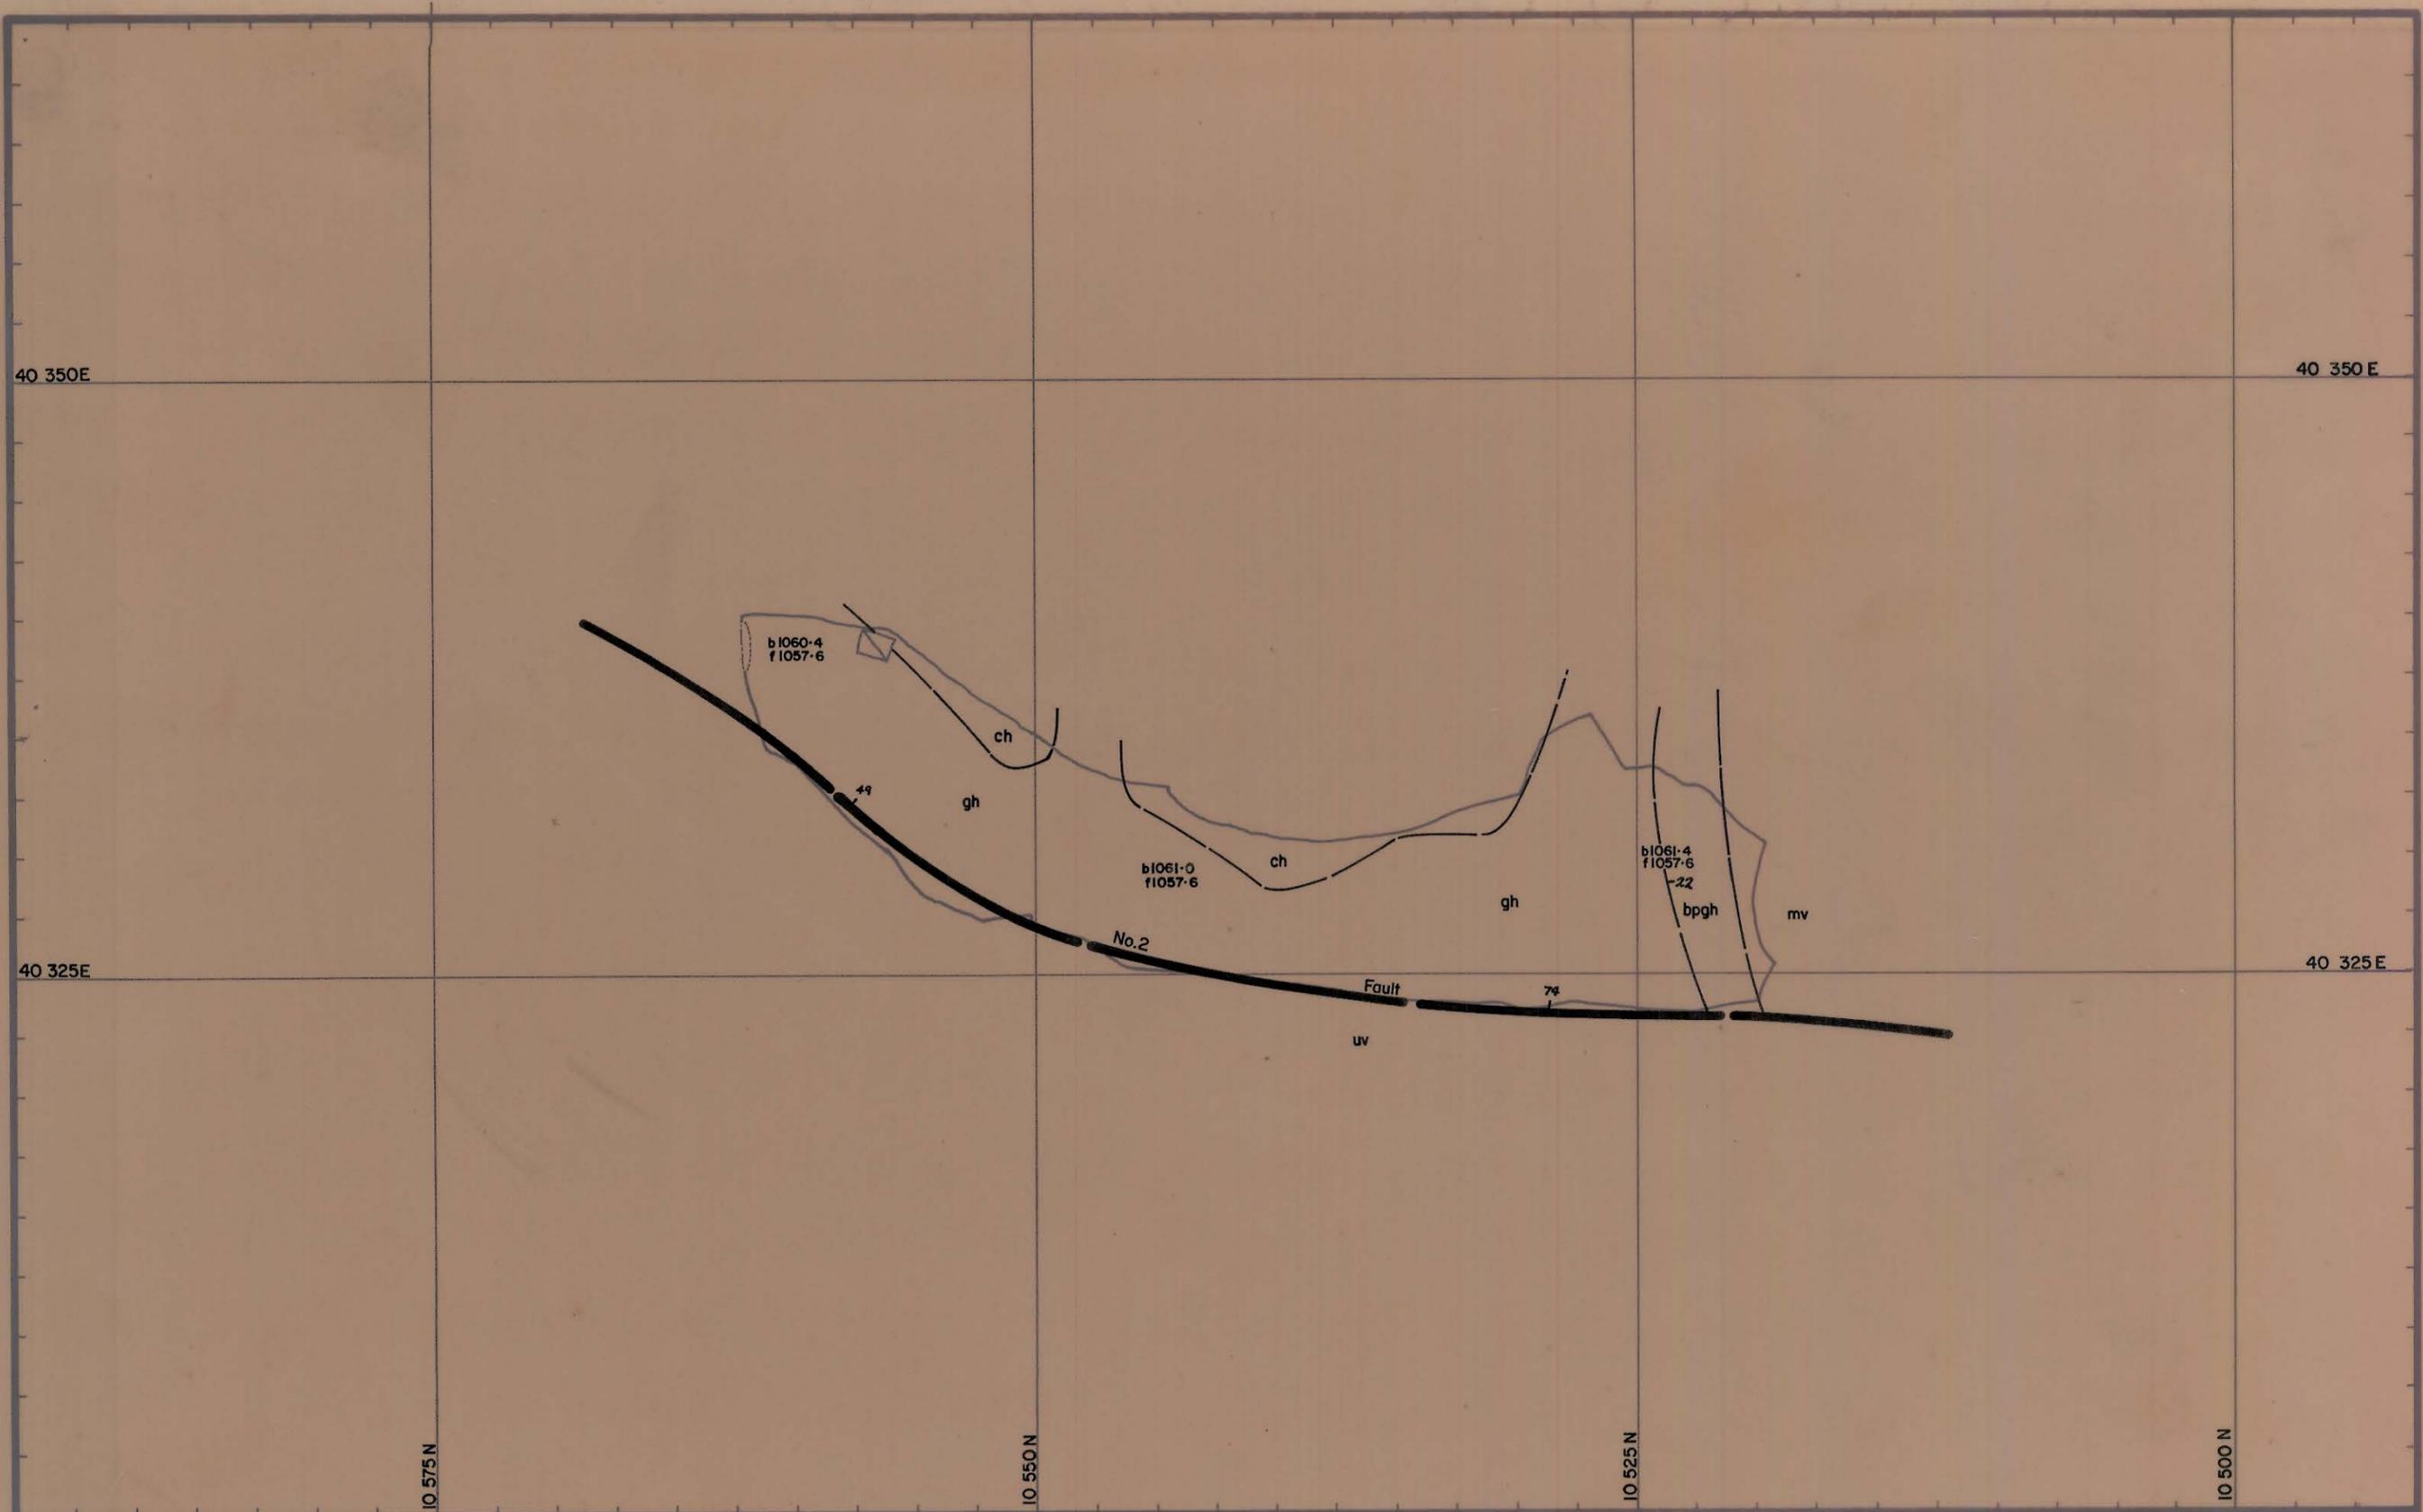

LEGEND:



DATE: Jan. 78
GEOLOGIST: M.J.D.
DRAWN: C.T.
CHECKED:

GEOPEKO LIMITED
KING ISLAND

Scale: 1:250

NO. KG3-261-009

BOLD HEAD OREBODY
H-50 STOPE
5th Lift.