


H 50 STOPE
4th LIFT

5 cm

0374_4840

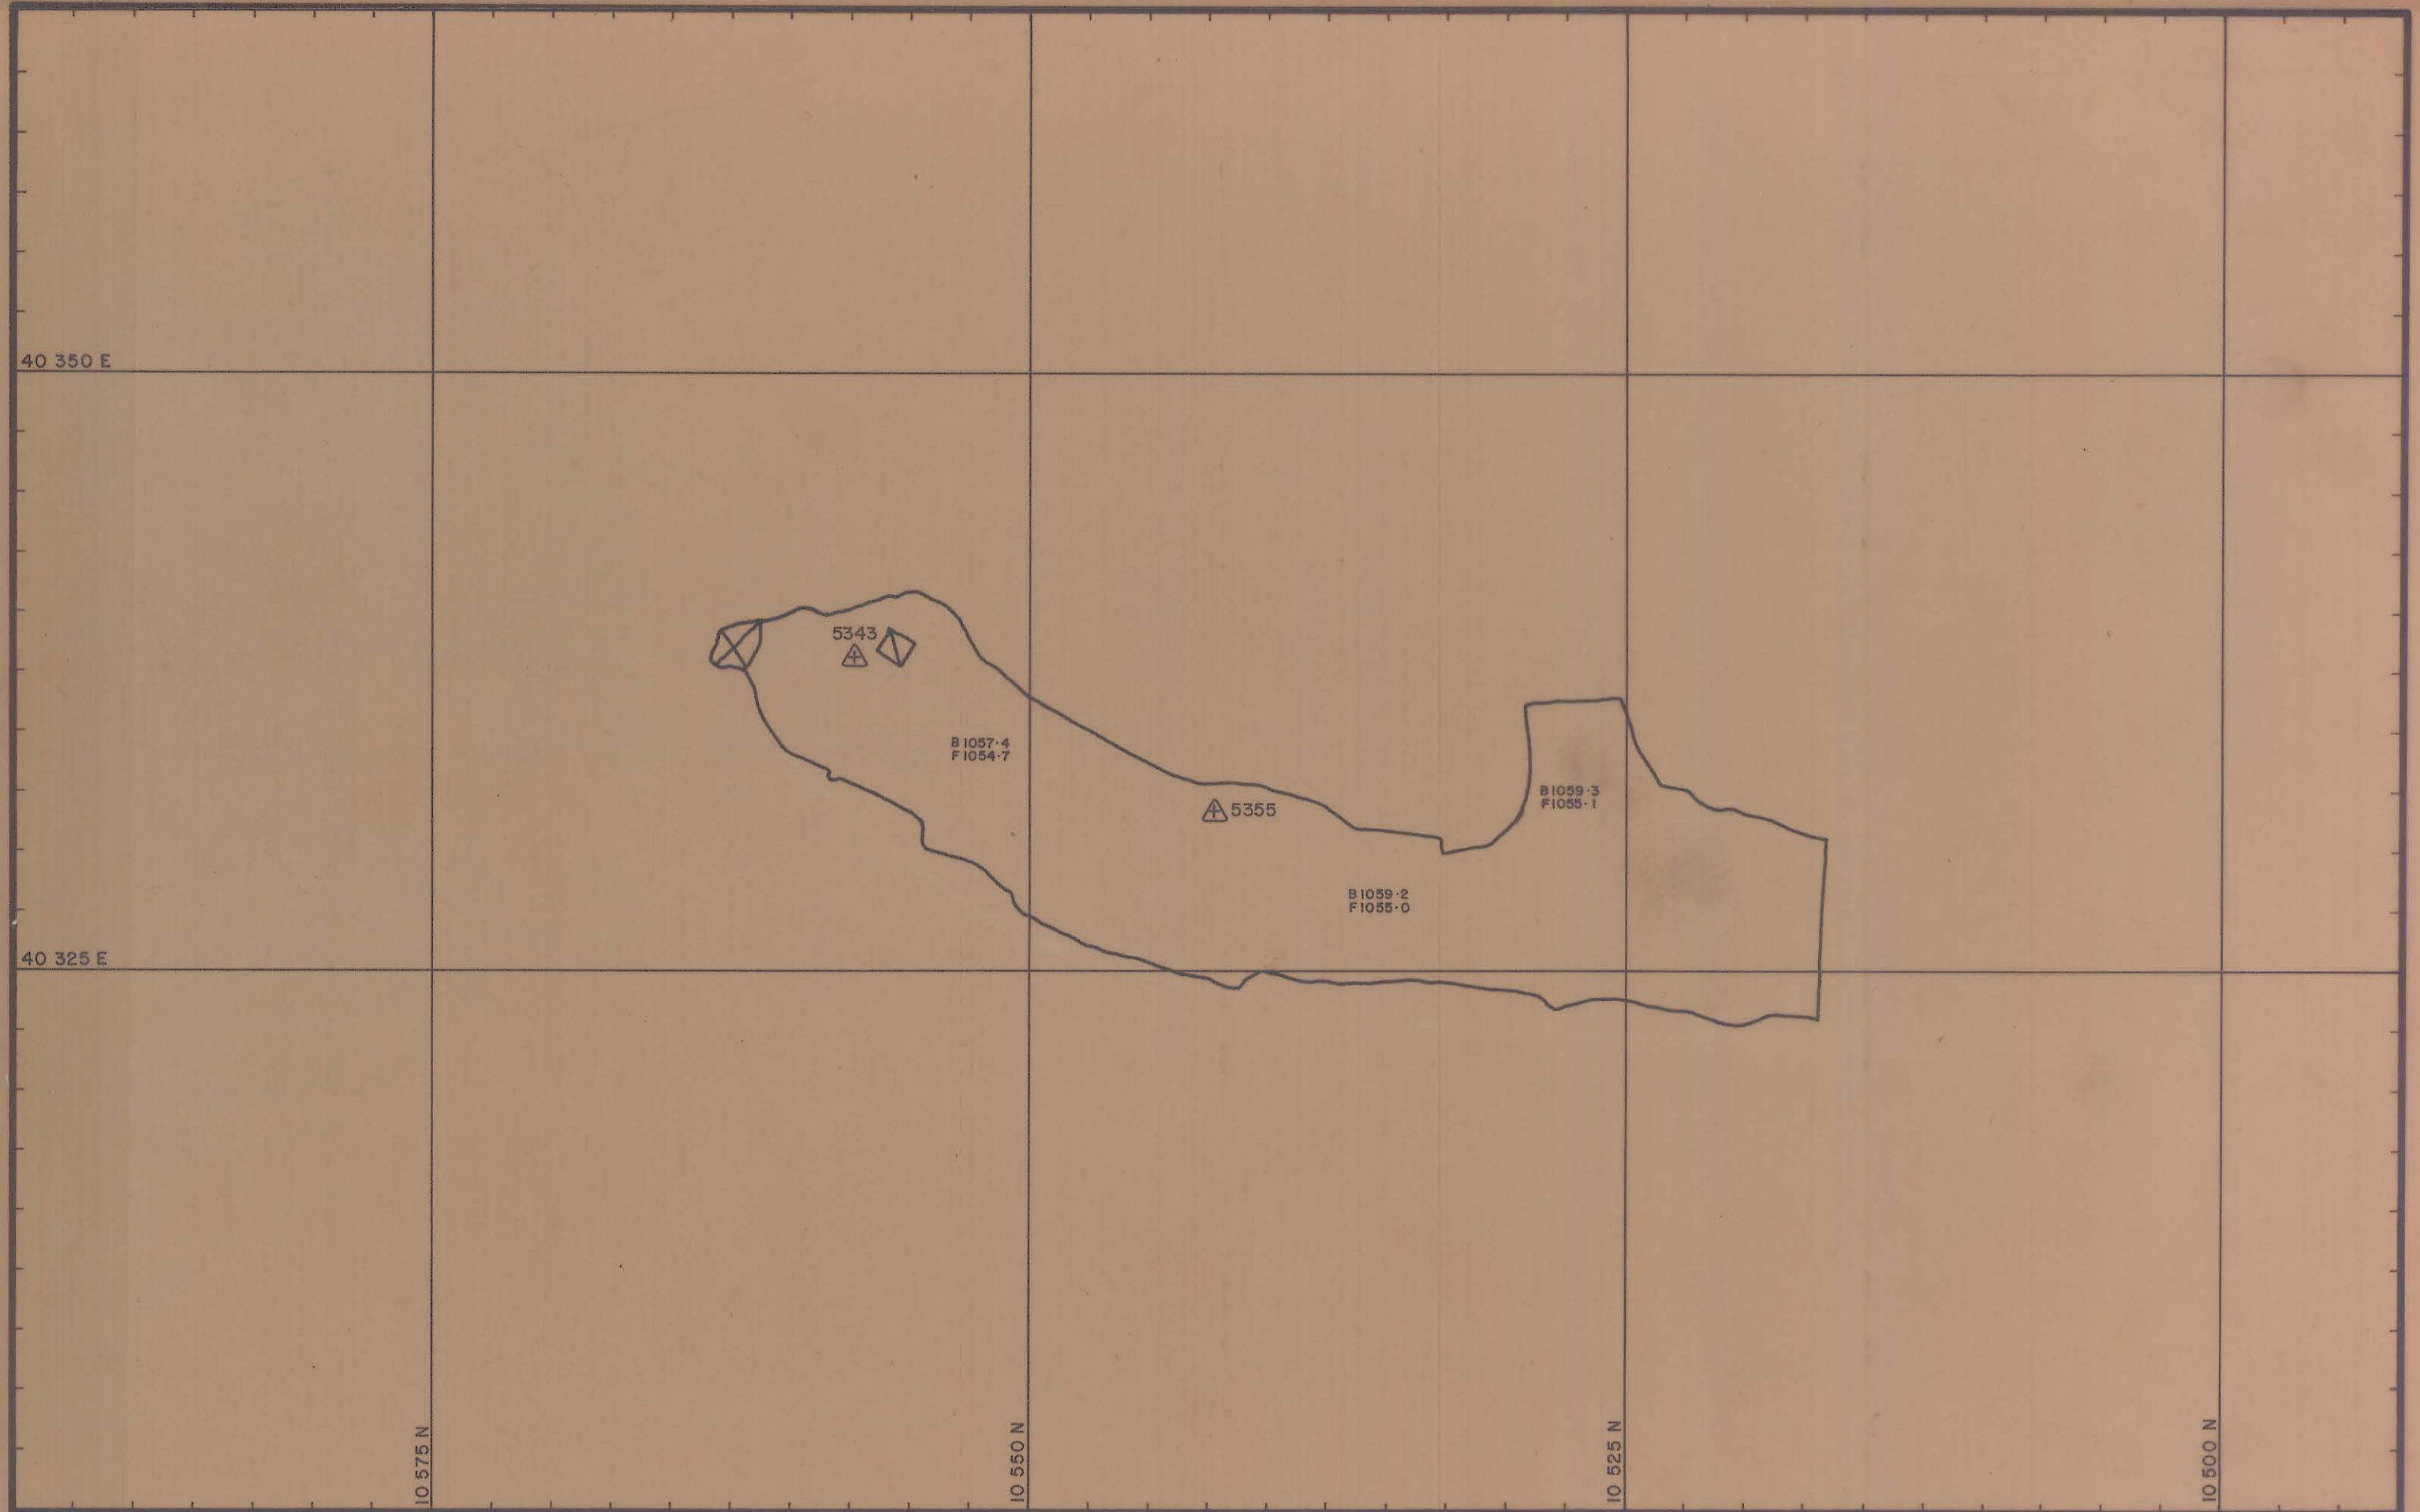

LEGEND:



DATE: Jun., 77
GEOL: S.G.B.
DWN: R.F.
CHKD:

GEOPEKO LIMITED
KING ISLAND

Scale: 1:250

Nº KG3-26I-008

BOLD HEAD OREBODY
H. 50 STOPE
4th Lift