


27 JUN 1981

H50 STOPE
3rd LIFT

5 cm

0374_4841

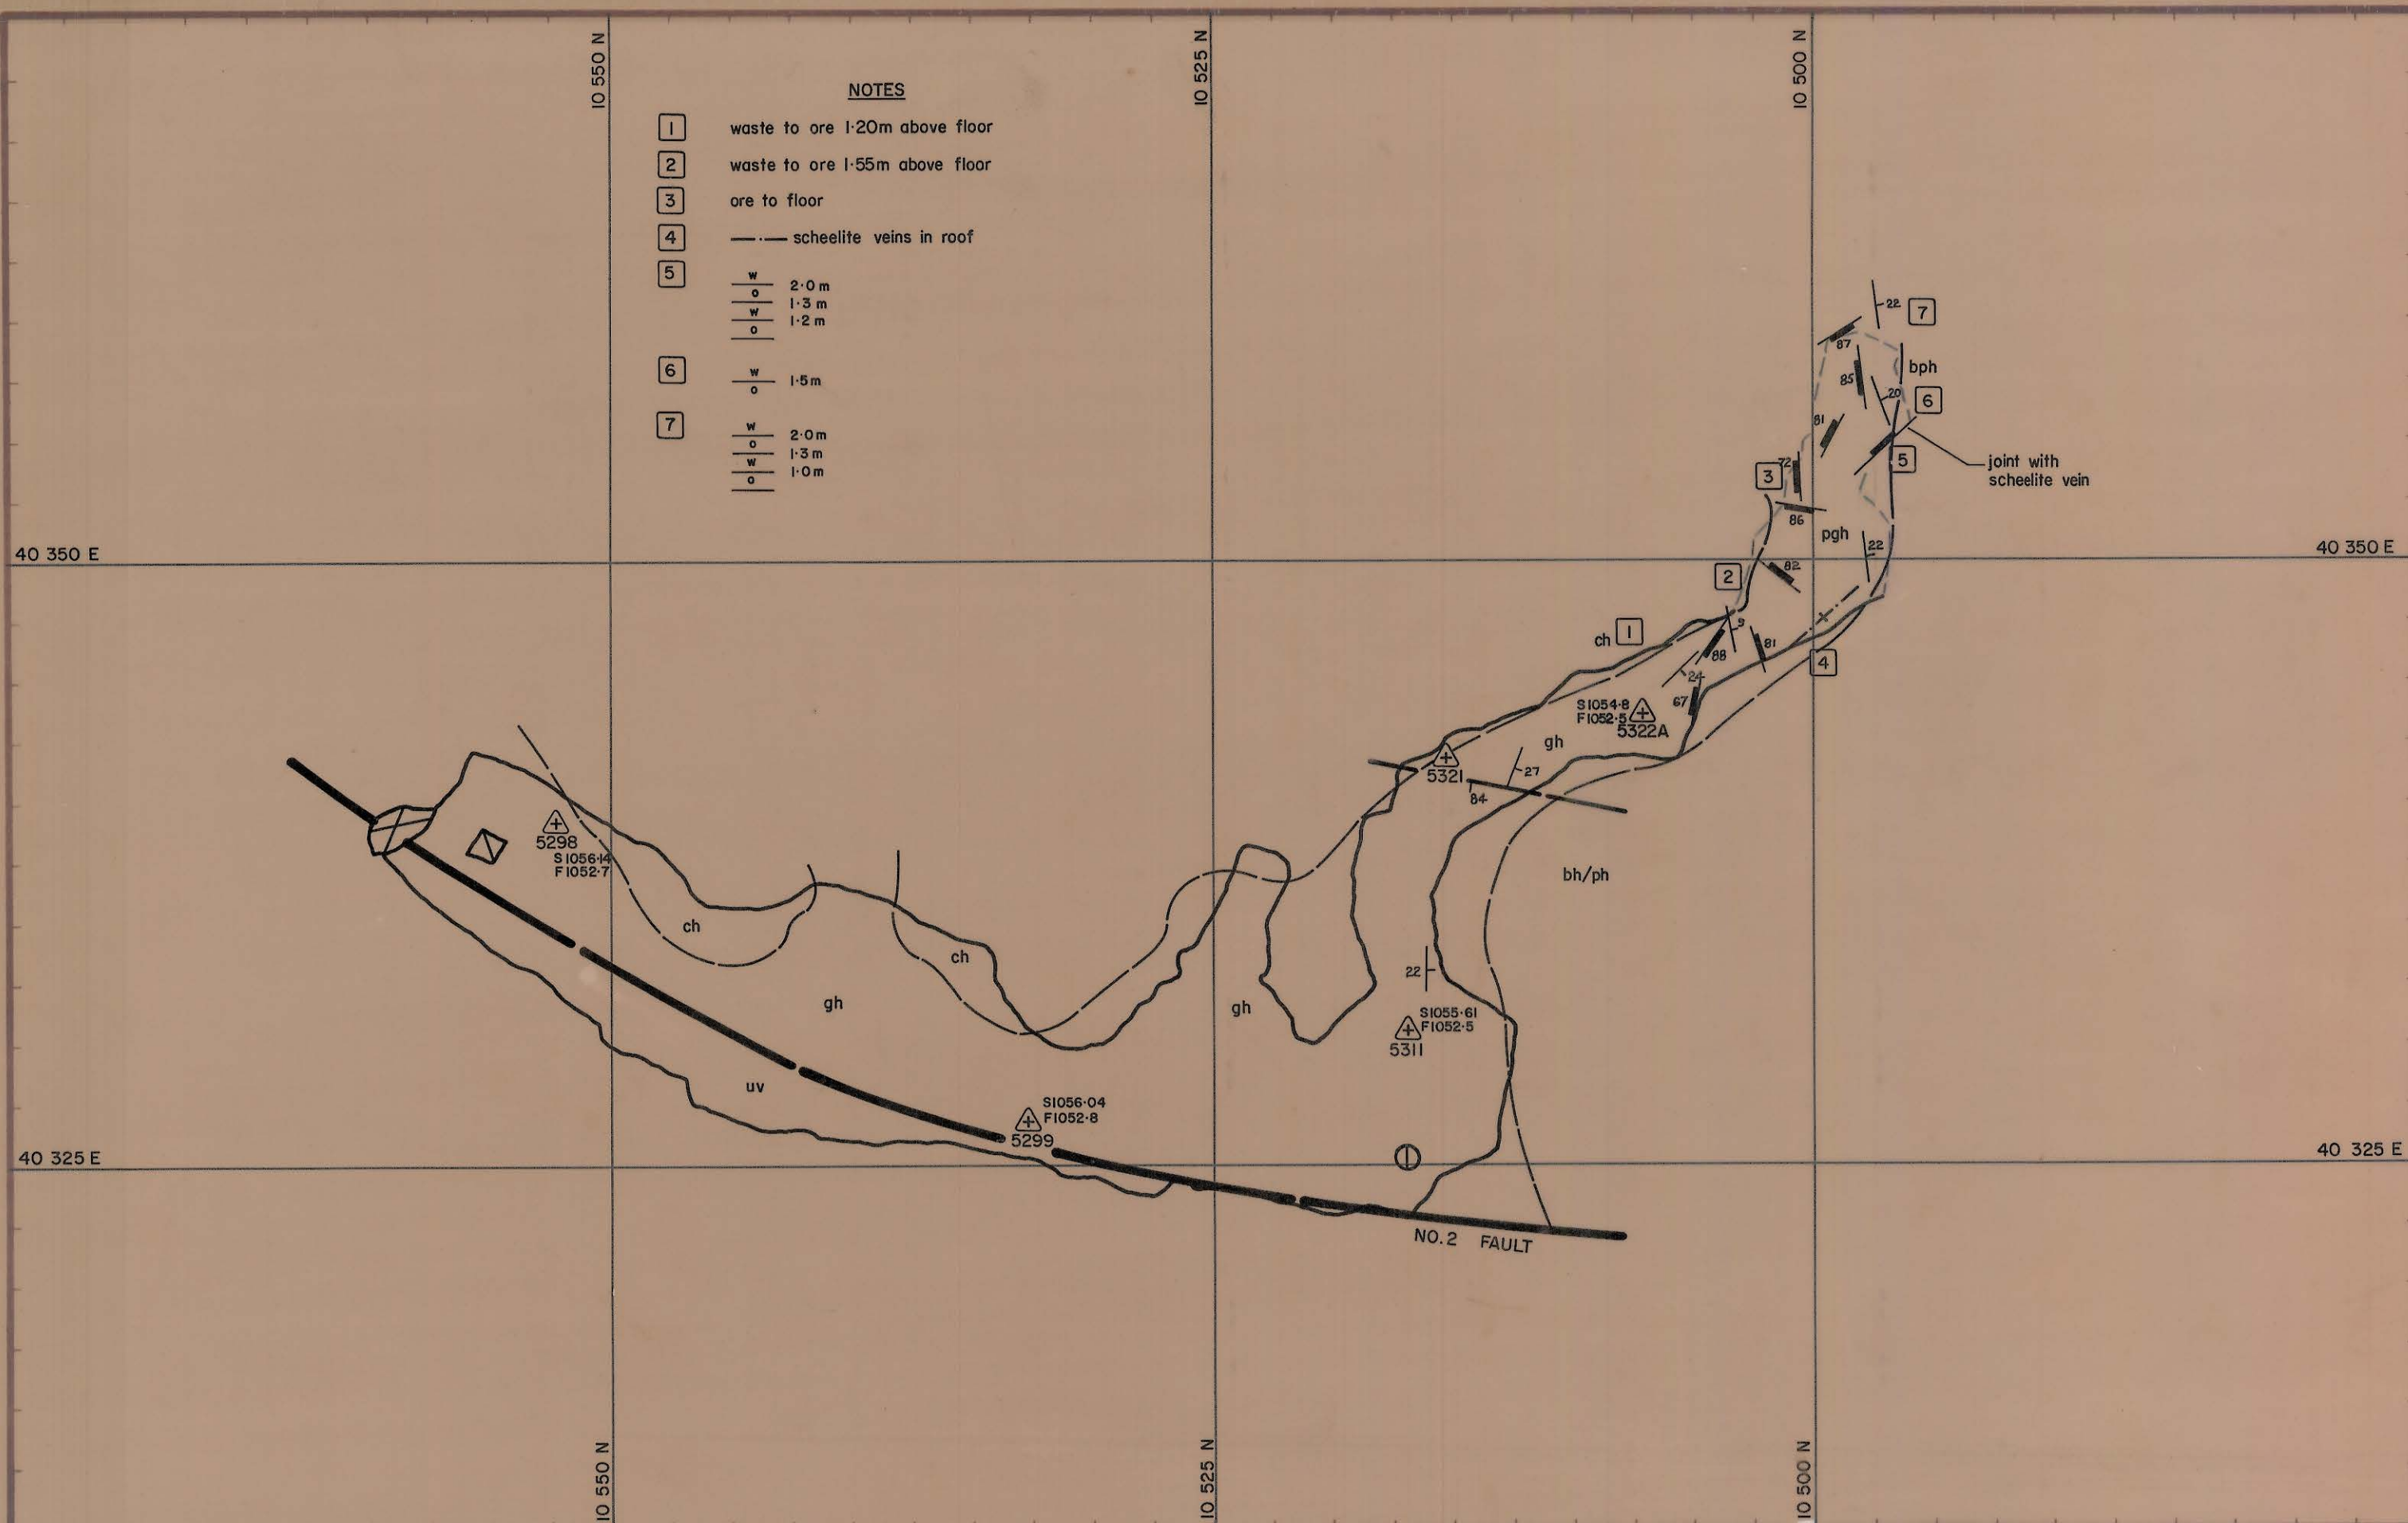

LEGEND:

GEOPEKO LIMITED
KING ISLAND

Scale: 1:250

No. KG3-261-007

DATE Jan 77

GEOL S.G.B.

DWN: L.G.

CHKD M.C.R.

BOLD HEAD OREBODY

H50 STOPE

3rd Lift