



27 JUN 1981

H50 STOPE
2nd LIFT

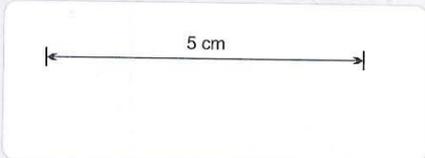

0374_4842

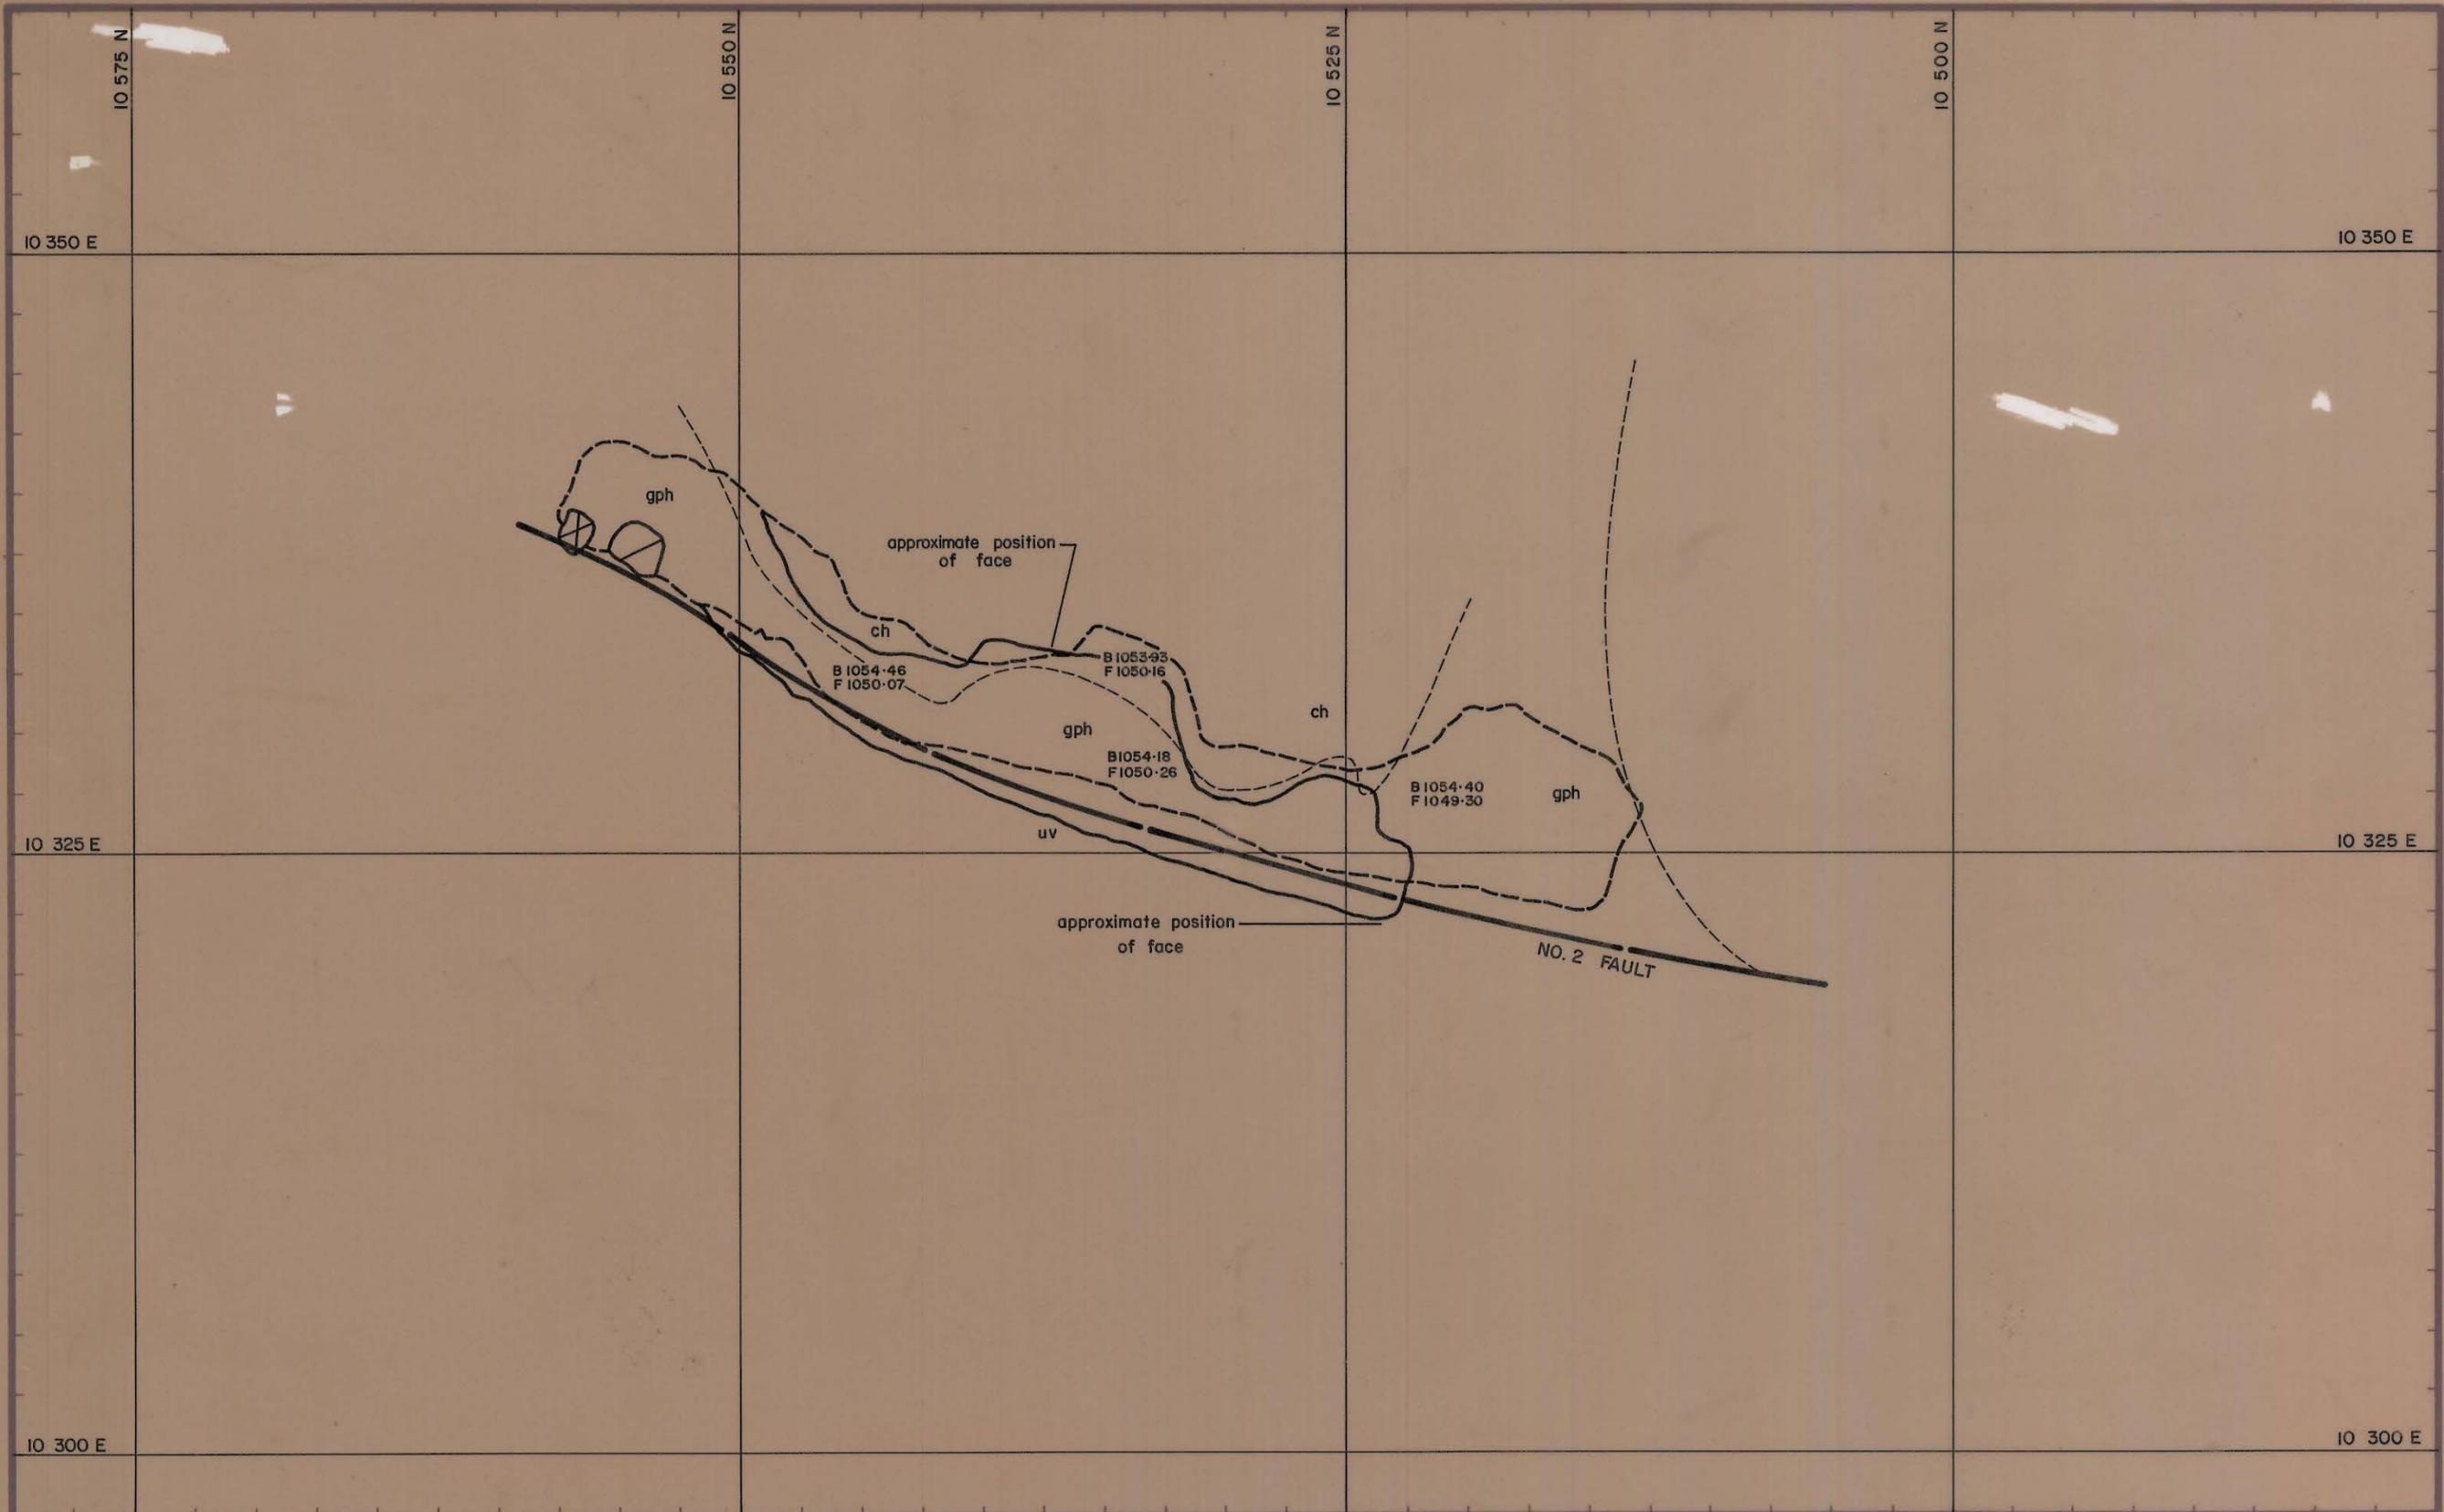

LEGEND:

----- Outline of 2nd lift approximately 1054m R.L. (back)

———— Outline of 3rd (present) lift approximately 1056m R.L. (back)

	GEOPEKO LIMITED KING ISLAND	
	Scale: 1 : 250	No. KG3-261-006
	BOLD HEAD OREBODY	
	H50 STOPE	
DATE: Nov 76	2nd Lift	
GEOLOGIST: S.G.B.		
DRAWN: L.G.		
CHECKED: M.C.R.		